

Environmental Services - Water Quality
Onsite Wastewater Scan Data Entry Form

PERMIT #: 0001686

PIN #: 1708293400

OP DATE: 1011911987

SYSTEM USE:

- ☒ House
☐ Mobile Home
☐ Business
☐ Other

SEWAGE TYPE:

- ☒ Domestic
☐ Industrial

PUMP/SIPHON?:

- ☐ Yes
☒ No

PRESSURE MANIFOLD:

- ☐ Yes
☒ No

SYSTEM TYPE:

- ☐ I
☒ II
☐ III
☐ IV
☐ V
☐ VI
☐ Other

SUB TYPE:

- ☒ A
☐ B
☐ C
☐ D
☐ E
☐ F
☐ G

NBR BEDROOMS:

- ☐ 1
☐ 2
☐ 3
☒ 4
☐ 5
☐ 6
☐ Other

MAINT. SCHEDULE:

- ☐ Yes
☒ No

CERT. OPERATOR

- ☐ Yes
☒ No

GT	ST	PT	SIZE
☐	☐		750
☐	☐	☐	900
☐	☐	☐	1,000
☐	☒	☐	1,200
☐	☐	☐	1,500
☐	☐	☐	1,800
☐	☐	☐	2,100
☐	☐	☐	2,500
☐	☐	☐	3,000
☐	☐	☐	4,000
☐	☐	☐	5,000
☐	☐	☐	8,000
☐	☐	☐	10,000
☐	☐	☐	Other
☒		☒	None/NA GT or PT

DRAINFIELD SIZE(SQ. FT.)

01700

DRAIN TYPE:

- ☒ Stone
☐ EZ Flow
☐ Infiltrator
☐ Biodiffuser
☐ Cultec
☐ Drip
☐ Hancor
☐ Large Dia. Pipe
☐ Multi-Pipe
☐ Other

MAX DEPTH (IN.):

- ☐ 12 in. or less
☐ 18 in. or less
☐ 24 in. or less
☐ 26 in. or less
☐ 28 in. or less
☐ 30 in. or less
☐ 32 in. or less
☐ 36 in. or less
☒ Other

STONE DEPTH (IN.):

- ☐ 8 in. or less
☒ 12 in. or less
☐ 18 in. or less
☐ 24 in. or less
☐ Other

TRENCHES:

- ☒ Individual
☐ Bed

TRENCH WIDTH (IN.):

- ☐ 12 in. or less
☐ 18 in.
☐ 24 in.
☒ 36 in.
☐ 6 ft. or less
☐ 9 ft. or less
☐ Other

MI
4/28/15

WAKE COUNTY HEALTH DEPARTMENT WELL AND SEWAGE SITE, LOCATION PERMIT

Tax Map No. 281 Parcel No. 240 No. **C** 01686

Contractor: Robert Brown Co. Inc. Operation Permit []

Owner: _____ Date: 5-18-87

Location: 225 Jansmith Lane

1708 29 3400

Subdivision Name: Chelsea Lot No. 19 Section or Block No. _____

SP. 1005

Sewage System

Repair [] Original Permit No. _____

Garbage Disposal Unit Yes [] No [☒]

House [☒] Mobile Home [] Business []

No. Bedrooms 4 Lot Area 40,000

Size of Tank 1200 gal.

Nitrification Line 1200 sq. ft.

Depth of Stone in Lines: 12" [☒]

Riser and Baffle Required [☒] Pump Required []


Improvement Permit

*Permit Void 36 months from date of issuance

*Permit Void if not in compliance with zoning regulations

*Permit may be voided if site alterations made

Layout By: _____

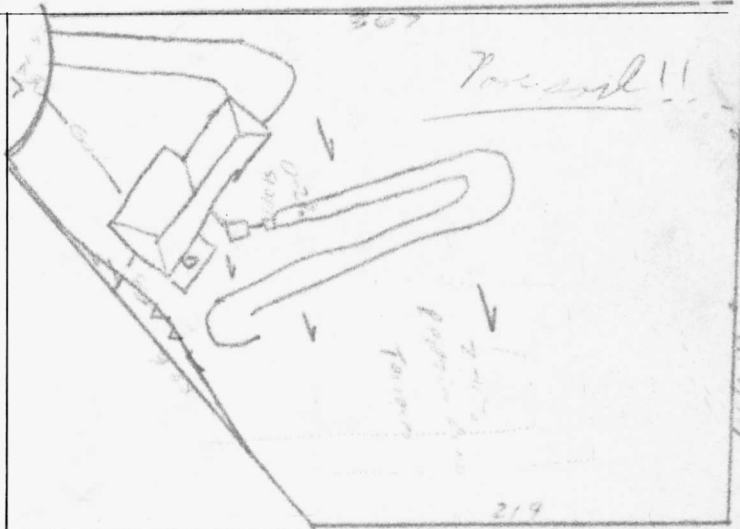

Date Sept 19, 1987 Installed By Bulger Bros Service Approved By Joseph L. Bulger

Well System

Individual [] Semi-Public [] Public [☒]

New [] Replacement [] Repair []

Fee Paid Yes [] No []

Construction Compliance Yes No

Site Approved [] []

Well Head Approved [] []

Grouting Approved [] []

Date Inspected

Sanitarian

Final Inspection Yes No

Required Slab [] []

Chlorinated [] []

Required Certificate [] []

Variance (Explain) [] []

WCHD I.D. Affixed [] []

Sample Collected [] []

**Well permit void 12 months from issuance date

Bacteriological Results

Initial Sample: _____ Date: _____

*Re-sample #1 _____ Date: _____

*Re-sample #2 _____ Date: _____

Re-chlorination as required Yes [] No []

Comments: _____

*\$10.00 fee for all re-samples

All checks payable to: **Wake County Health Department**

Well Installed By: _____

Date System Finalized

Sanitarian

This report is based in part on information provided by the homeowner or his/her representative in the application submitted for this permit. The sanitarian is not responsible for false or misleading information contained in the application. The sanitarian is also not responsible for concealed conditions on the property or for statements in this report that may have resulted from false or misleading statements provided to him in the application. Neither Wake County nor the sanitarian warrants that the septic tank system will continue to function satisfactorily in the future or that the water supply will remain potable.