

WAKE COUNTY HEALTH DEPARTMENT SEPTIC TANK LAYOUT AND PERMIT

TAX MAP NO. 7X1 PARCEL NO. 70 PERMIT NO. 33224

CONTRACTOR O. Smith OPERATION PERMIT ☐ DATE 7-30-84

OWNER 1

LOCATION 2615 Townsend Ln.

SUBDIVISION NAME Cheriton LOT NO. 11 SECTION OR BLOCK NO. 1005

REPAIR ☐ ORIGINAL PERMIT NO. _____

GARBAGE DISPOSAL UNIT YES ☐ NO ☒

HOUSE ☒ MOBILE HOME ☐ BUSINESS ☐

NO. BEDROOMS 4 LOT AREA 11,100

SIZE OF TANK _____ gal.

NITRIFICATION LINE 7' (7'00") sq. ft. 1200

DEPTH OF STONE IN LINES: 12" ☒

RISER AND BAFFLE REQUIRED ☒ PUMP REQUIRED ☐


WATER SUPPLY: INDIVIDUAL ☐ PUBLIC ☒ OTHER ☐

PERMIT VOID 36 MONTHS FROM DATE OF ISSUANCE.

PERMIT VOID IF NOT IN COMPLIANCE WITH ZONING REGULATIONS

PERMIT MAY BE VOIDED IF SITE ALTERATIONS MADE

LAYOUT BY W.D. Smith

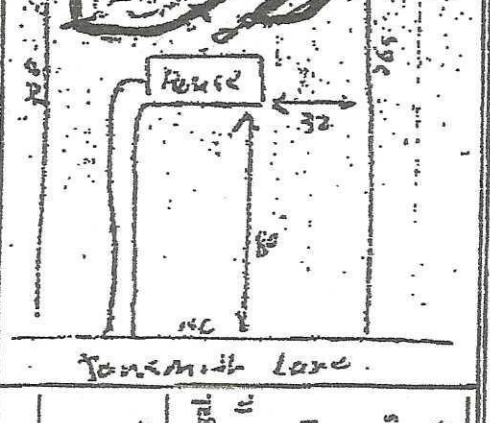

DATE 1-3-86 INSTALLED BY Senior's Culley

APPROVED BY Michael W.D. Smith