

Environmental Services - Water Quality
Onsite Wastewater Scan Data Entry Form

PERMIT #: 1029954

PIN #: 1810132695

OP DATE: 0910611985

SYSTEM USE:

- ☒ House
☐ Mobile Home
☐ Business
☐ Other

SEWAGE TYPE:

- ☒ Domestic
☐ Industrial

PUMP/SIPHON?:

- ☐ Yes
☒ No

PRESSURE MANIFOLD:

- ☐ Yes
☒ No

SYSTEM TYPE:

- ☐ I
☒ II
☐ III
☐ IV
☐ V
☐ VI
☐ Other

SUB TYPE:

- ☒ A
☐ B
☐ C
☐ D
☐ E
☐ F
☐ G

NBR BEDROOMS:

- ☐ 1
☐ 2
☐ 3
☒ 4
☐ 5
☐ 6
☐ Other

MAINT. SCHEDULE:

- ☐ Yes
☒ No

CERT. OPERATOR

- ☐ Yes
☒ No

GT ST PT

- ☐ ☐ ☐
☐ ☐ ☐
☐ ☐ ☐
☐ ☒ ☐
☐ ☐ ☐
☐ ☐ ☐
☒ ☐ ☒

SIZE

- 750
900
1,000
1,200
1,500
1,800
2,100
2,500
3,000
4,000
5,000
8,000
10,000
Other
None/NA GT or PT

DRAINFIELD SIZE(SQ. FT.)

01200

DRAIN TYPE:

- ☒ Stone
☐ EZ Flow
☐ Infiltrator
☐ Biodiffuser
☐ Cultec
☐ Drip
☐ Hancor
☐ Large Dia. Pipe
☐ Multi-Pipe
☐ Other

MAX DEPTH (IN.):

- ☐ 12 in. or less
☐ 18 in. or less
☐ 24 in. or less
☐ 26 in. or less
☐ 28 in. or less
☐ 30 in. or less
☐ 32 in. or less
☐ 36 in. or less
☒ Other

STONE DEPTH (IN.):

- ☐ 8 in. or less
☒ 12 in. or less
☐ 18 in. or less
☐ 24 in. or less
☐ Other

TRENCHES:

- ☒ Individual
☐ Bed

TRENCH WIDTH (IN.):

- ☐ 12 in. or less
☐ 18 in.
☐ 24 in.
☒ 36 in.
☐ 6 ft. or less
☐ 9 ft. or less
☐ Other

B.W 10/18/13

Wake

WAKE COUNTY HEALTH DEPARTMENT SEPTIC TANK LAYOUT AND PERMIT

1200-10

TAX MAP NO. 227 PARCEL NO. 1A-BPERMIT NO. B 29954
BCCONTRACTOR Michael Leonard bldrsOWNER _____ DATE 6-12-84

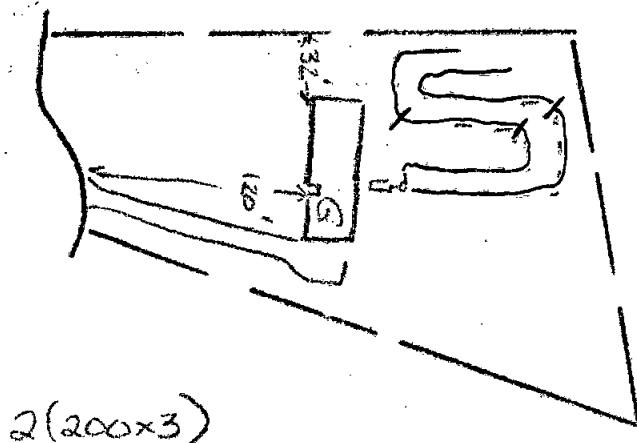
LOCATION _____

SUBDIVISION NAME Birchfalls LOT NO. 18 S. R. NO. 2002
SECTION OR BLOCK NO. 3REPAIR ☐ ORIGINAL PERMIT NO. _____GARBAGE DISPOSAL UNIT YES ☐ NO ☒HOUSE ☒ MOBILE HOME ☐ BUSINESS ☐NO. BEDROOMS 4 LOT AREA 40,000 ~~sq. ft.~~SIZE OF TANK V=480 1200 gal.NITRIFICATION LINE 2(200x3) 1200 sq. ft.DEPTH OF STONE IN LINES: 12" ☒RISER AND BAFFLE REQUIRED ☒ PUMP REQUIRED ☐WATER SUPPLY: INDIVIDUAL ☒ PUBLIC ☒ OTHER ☐

* PERMIT VOID 36 MONTHS FROM DATE OF ISSUANCE

* PERMIT VOID IF NOT IN COMPLIANCE WITH ZONING REGULATIONS

* PERMIT MAY BE VOIDED IF SITE ALTERATIONS MADE

LAYOUT BY Kathy EW, R.S.

DATE

9-6-85C.Y. Davis
INSTALLED BYM.H. Smith
APPROVED BY

590-GP09