

WAKE COUNTY DEPARTMENT OF ENVIRONMENTAL SERVICES WELL AND SEWAGE SITE LOCATION PERMIT

NO PERMIT(S) FOR CONSTRUCTION, LOCATION OR RELOCATION ACTIVITY SHALL BE ISSUED

UNTIL AN AUTHORIZATION FOR WASTEWATER SYSTEM CONSTRUCTION HAS BEEN ISSUED

PERMIT VOID IF NOT IN COMPLIANCE WITH ZONING REGULATIONS AND/OR IF SITE IS ALTERED OR INTENDED USE CHANGED

PERMIT#: D008617 STATUS: A APP DATE: 12/10/1997 BLDG PERMIT#: 0981925
 APPLICANT: FOUSE, SAMUEL BLDR DAY PHONE: (919) 781 - 9558
 ADDRESS: 4000 PICKWICK DR FAX#: (999) 999 - 9999
 CITY: RALEIGH STATE: NC ZIP: 27613
 OWNER: 98 PARTNERS LLC DAY PHONE: (919) 781 - 9558
 ADDRESS: 4000 PICKWICK DR FAX#: (999) 999 - 9999
 CITY: RALEIGH STATE: NC ZIP: 27613
 HD USE CD: 101 ONE-FAMILY HOUSE ORIG PERMIT#: REC?: Y
 EXIST USE: TAX MAP#: 0185
 BEDROOMS: 3 BSMT: N #EMPLOYEES: 0 WATER: C WASTEWATER: I GARB DISPOSAL: N
 TOWNSHIP: 02 BARTON'S CREEK JURIS: WC ZON: R40W PIN: 0881.02 86 9597 000
 SUBD#: S 000 000 00 SUBD NAME: LAKEFALL PH 2 LOT-SEC: 34 ACRE: 0.97
 MPRV PRMT: ISSUED?: Y DATE: 04/02/1998 BY: ACP TYPE SYSTEM: II PUMP:
 NSTR AUTH: ISSUED?: Y DATE: 04/02/1998 BY: ACP DATE EXPIRED: 04/02/2003
 RECEIPT#: 024843 FEE: 145.00 OP DATE: BY:
 ATR SAMPL: REQ?: APPROVED?: DATE: PROPRIETARY SYS:
 ST#: 7420 MI: DIR: NAME: HEARTLAND DIR: TYP: DR
 DIRECTIONS: GO 50N-LT NC98-RT SR1831-LT LK FALLS DR INTO SU
 BDIV LOT# (GAVE ORANGE CARD) 999 EEEET 14yo
 IMPROVEMENT PERMIT
 SIZE OF TANK 1000 ST 1200 PT GALS. TOTAL SQ. FT. 1028 DEPTH OF STONE 12 IN. MAX. DEPTH LINE 24 IN.

WASTEWATER: DOMESTIC ☒ INDUSTRIAL ☐

I.P. ISSUED BY

Andre C. Pence

AUTHORIZATION FOR WASTEWATER SYSTEM CONSTRUCTION

VOID SIXTY (60) MONTHS FROM DATE OF ISSUANCE

AUTHORIZATION CONDITIONS

Contractor To Follow Contours, See Attached Site Plan For Wastewater System Design And Well Location. The wastewater system shall not be covered or placed into use until inspected by the Wake County Department of Environmental Services and an Operation Permit issued.

OTHER CONDITIONS: Water and Sewer lines shall not cross each other. Do not trench utilities in the area of the septic tank system.. USE 2 RISERS and a FILTER.

SIZE OF TANK 1000 ST 1200 PT GALS. TOTAL SQ. FT. 1028 DEPTH OF STONE 12 IN. MAX. DEPTH LINE 24 IN.
 ST FILTER REQUIRED ☒ NUMBER OF TRENCHES 3 LENGTH OF TRENCHES 114 FT. WIDTH OF TRENCHES 3 FT.

C.A. ISSUED BY *Andre C. Pence* INSTALLED BY *J. Bailey* CTR. I.D.# _____

SEPTIC TANK FILTER USED _____

INNOV. APPL. #: IWWS-_____ DATE *9/28/98* INSTALLATION APPROVED BY *Andre C. Pence R.S.*

WELL SYSTEM = PRIVATE ☐ SEMI-PUBLIC ☒ NEW ☐ REPLACEMENT ☐ EXISTING ☐

WELL LOG INFORMATION = DEPTH _____ CASING DEPTH _____ YIELD _____ STATIC LEVEL _____

WELL CONTRACTOR _____ REG.# _____ PUMP CONTRACTOR _____ REG.# _____

CONSTRUCTION COMPLIANCE = GROUT APPROVED ☐ DATE _____ EHS _____

WCHD ID # _____ WELLHEAD APPROVED ☐ DATE _____ EHS _____

NEGATIVE BACTERIOLOGICAL RESULTS ☐ DATE _____ EHS _____

SYSTEM FINALIZED ☐ DATE _____ EHS _____

COMMENTS: _____



 This permit is based in part on information provided by the homeowner or his/her representative in the application submitted for this permit. The Environmental Health Specialist is not responsible for false or misleading information contained in the application. The Environmental Health Specialist is also not responsible for concealed conditions on the property or for statements in this report that may have resulted from false or misleading statements provided to him in the application. Neither Wake County nor the Environmental Health Specialist warrants that the septic tank system will continue to function satisfactorily in the future or that the water supply will remain potable.

0981925
D-8617

ATTN: ED DUKES

CA

LOT 34 LAKEFALL SUB'D, PHASE TWO
1709 CHESTNUT HILL ROAD
WAKE FOREST, NC
CONTACT: SAMUEL FOUSE / BUILDER
RALEIGH, NC
3 NOV. 97 BY-S.F.
SCALE: 1"=50'

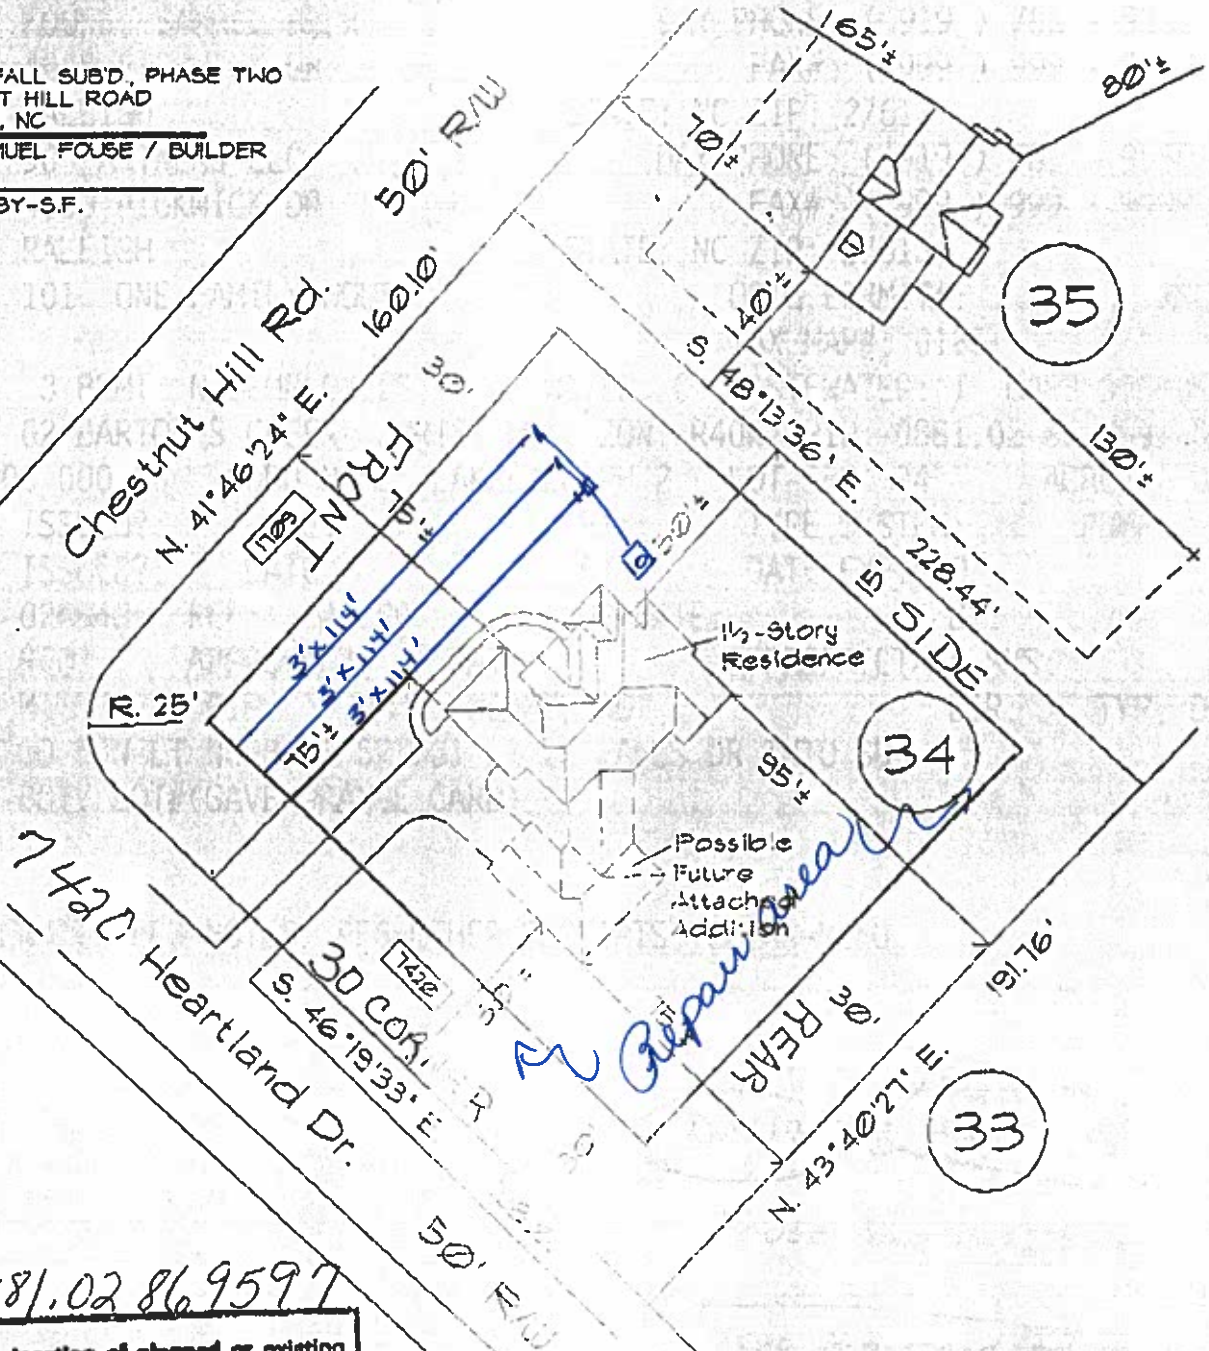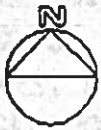

PIN# 0881.02 869597

I certify that the location of planned or existing structure(s) are accurately shown. I understand failure to locate structures in accordance with this plot plan may require the relocation of structure(s) regardless degree of completion. I hereby grant permission to Municipal/County Representatives the right of entry to make evaluations or inspections upon this property.

Samuel Fouse

Signature of Owner or Authorized Agent

Survey R-40W by CH
Approved ☒ Date 12-16-97 2698
Area 101
MBL 110
30 Rear 30
15 Corner 30
Cave under game orange card-


0981925
D-8617

As built

ATTN: ED DUKES

LOT 34 LAKEFALL SUB'D., PHASE TWO
1709 CHESTNUT HILL ROAD
WAKE FOREST, NC
CONTACT: SAMUEL FOUSE / BUILDER
RALEIGH, NC

3 NOV. 97 BY-S.F.
SCALE: 1"=50'

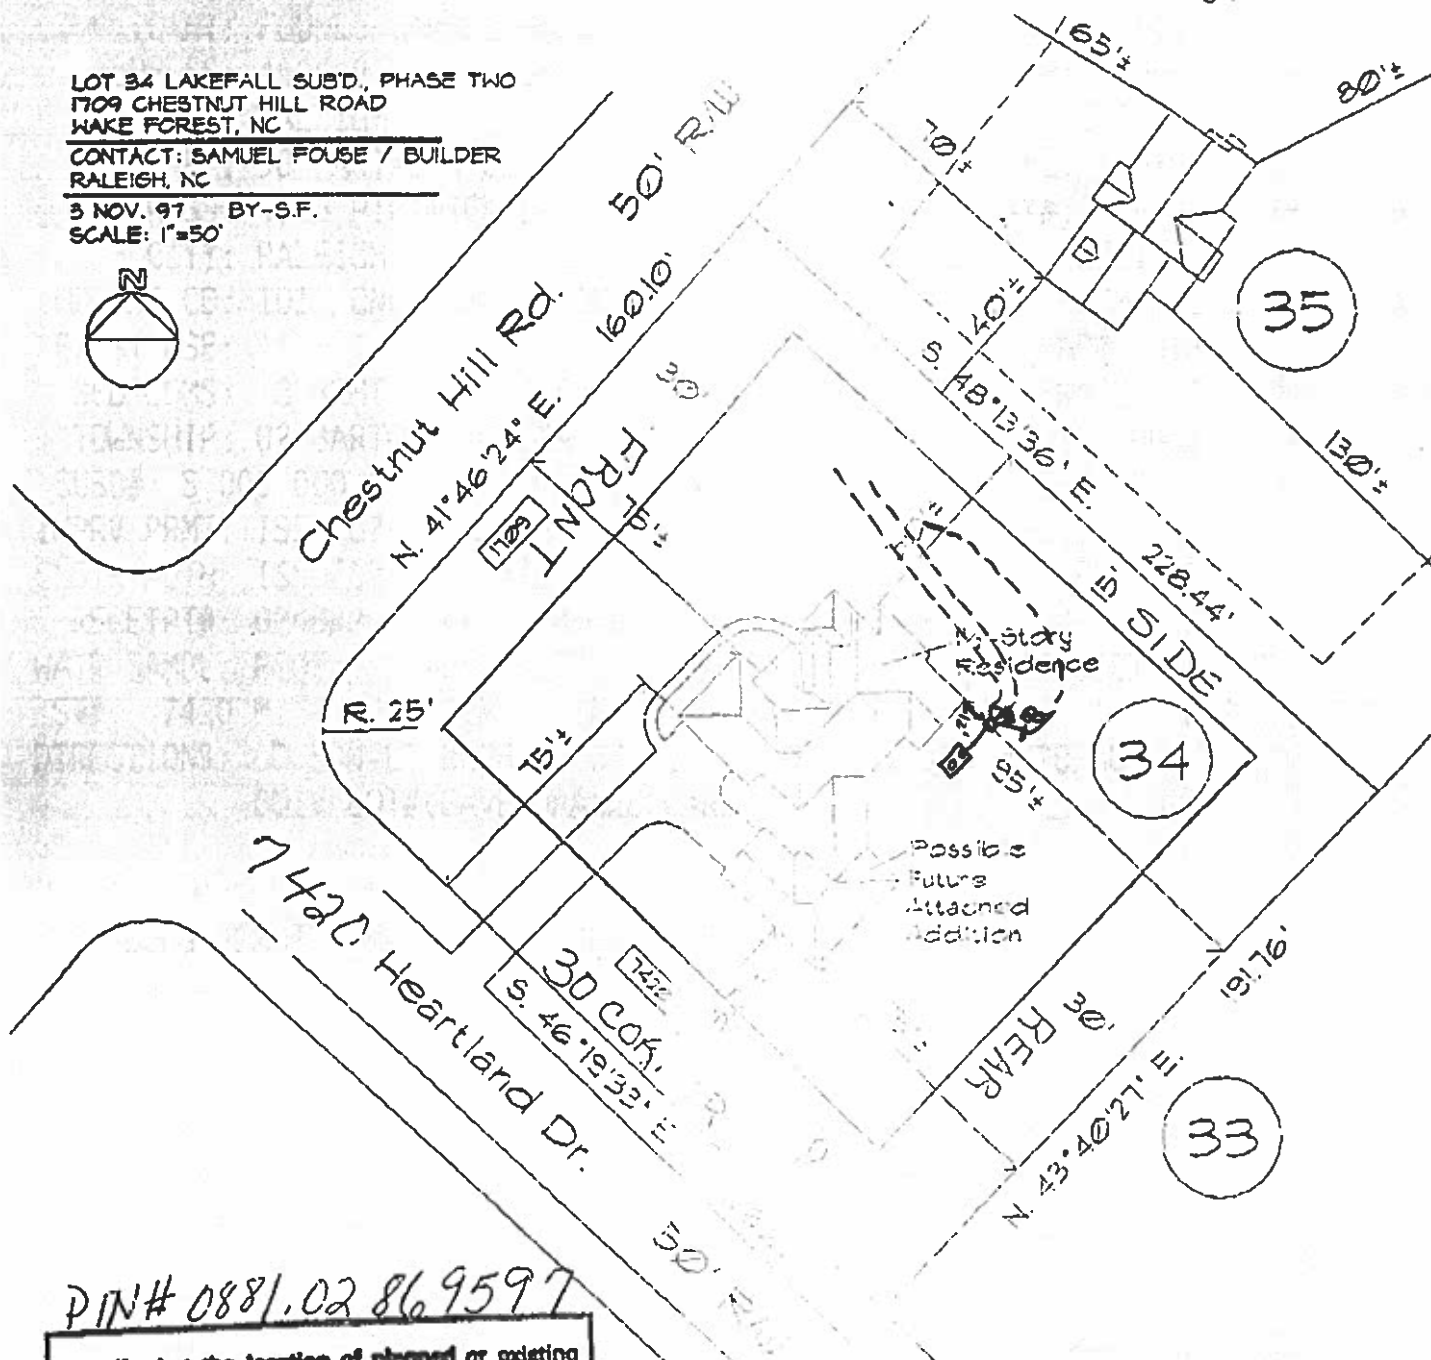

PIN# 0881.02 869597

I certify that the location of planned or existing structure(s) are accurately shown. I understand failure to locate structures in accordance with this plot plan may require the relocation of structure(s) regardless degree of completion. I hereby grant permission to Municipal/County Representatives the right of entry to make evaluations or inspections upon this property.

Signature of Owner or Authorized Agent:

R-40W 07 ch
 Date 12-11-97 269.8
 Usa 101
 MBL 110
 Rear 30
 15 Corner 30
 gave orange card-