

REVISED FOR POOL

WAKE COUNTY DEPARTMENT OF ENVIRONMENTAL SERVICES WELL AND SEWAGE SITE LOCATION PERMIT
NO PERMIT(S) FOR CONSTRUCTION, LOCATION OR RELOCATION ACTIVITY SHALL BE ISSUED
UNTIL AN AUTHORIZATION FOR WASTEWATER SYSTEM CONSTRUCTION HAS BEEN ISSUED

PERMIT VOID IF NOT IN COMPLIANCE WITH ZONING REGULATIONS AND/ OR IF SITE IS ALTERED OR INTENDED USE CHANGED

PERMIT#: D047083 STATUS: A
PIN: 1810.03 24 6100 000
TOWNSHIP: 02 BARTON'S CREEK
APPLICANT: ARBUTINA, CHRIS

APP. DATE: 12/29/2011
TAX MAP: 0227 0055
JURISDICTION: WC

BLDG. PERMIT#: 0121238
RECORDED: Y ORIG. PERMIT#:
ZONING: R80W SW DEVICE: N S#:

3411 INTEGRITY DR
GARNER, NC 27529
(919) 669-3235

USE: HD USE: 101A CONVENTIONAL ONE-FAMILY H

EXIST USE:

LTAR: 0.30 0.30 BEDROOMS: 5 BASEMENT: Y #EMPLOYEES: 0 FOUNDATION DRAIN: Y

SITE: ADDRESS: 15508 POSSUM TRACK RD

SUBDIVISION: LOT: ACRES: 5.17 EASEMENT: N LOC: SYS:

DIRECTION: SIX FORKS RD TO POSSUM TRACK PROPERTY ON L

IMPROVEMENT PERMIT

TANK SIZE: 1500 gal. PUMP Tank: ____ gal. SQ FT: 1800 INNOVATIVE MAX DEPTH LINE: 28 in.
WASTEWATER: INDIVIDUAL SEWAGE: DOMESTIC TYPE SYSTEM: III G PUMP: N P/M: N
DAILY FLOW: 600 gal/day DESIGN FEE REQ?: PAID?: WATER: INDIVIDUAL

COMMENTS:

IP ISSUED? Y DATE: 01/26/2012 BY: (SCR)  PHONE#: 856-6194


AUTHORIZATION FOR WASTEWATER/WATER SYSTEM CONSTRUCTION
VOID SIXTY (60) MONTHS FROM DATE OF ISSUANCE
AUTHORIZATION CONDITIONS:

Contractors shall install system on contours, see attached site plan for wastewater system design and well location. No underground utilities, water lines or sprinkler systems may be located in the original system or repair areas. A septic tank filter with a riser for access is required. The wastewater system shall not be covered or placed into use until inspected by the Wake County Department of Environmental Services and an Operation Permit issued. An Accepted Status System may be used in place of conventional system, if it can be placed in the permitted/authorized trench footprint (except reduction in line length and/or number as allowed for in approval) and the installation is in accordance with the accepted system approval, without unauthorized product alteration. If permit required use of an Accepted Status System, substitution with another accepted status system may be made, as long as no changes are necessary in the location of each nitrification line (including any increase in line length), trench depth or effluent distribution method. If changes are necessary, prior approval by this office is required before system installation. OTHER

CONDITIONS:

INITIAL SYSTEM AND REPAIR PROPOSED BY CONSULTANT AS 3 200' LINES USING ACCEPTED STATUS MEDIA, 25% REDUCTION ALREADY TAKEN. LINES ARE FLAGGED OUT IN FIELD. KEEP MINIMUM SETBACK OF 15' FROM HOUSE TO SEPTIC TANK. KEEP MINIMUM SETBACK OF 10' FROM PROPERTY LINE TO D-BOX AND DRAIN LINES. SUPPLY MUST BE KEPT 5' FROM PROPERTY LINE. CALL OFFICE WITH ANY QUESTIONS PRIOR TO OR DURING INSTALLATION

TANK SIZE: 1500 gal. PUMP TANK: ____ gal. SQ FT: 1800 INNOVATIVE MAX DEPTH LINE: 28 in.
MAINT: N OPER: N L/O: P TRENCH#: 3 LENGTH: 200 ft. WIDTH: 36 in. DESIGNER: ____
SUBFIELDS: _ DESIGN HEAD PRESSURE: _ DESIGN FLOW: ____ gal/min DOSE VOLUME: ____ gal.

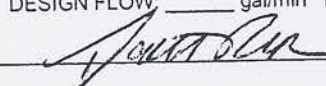CA ISSUED? Y DATE: 05/18/2012 BY: (SCR)  PHONE#: 856-6194

WAKE COUNTY DEPARTMENT OF ENVIRONMENTAL SERVICES WELL AND SEWAGE SITE LOCATION PERMIT
 NO PERMIT(S) FOR CONSTRUCTION, LOCATION OR RELOCATION ACTIVITY SHALL BE ISSUED
 UNTIL AN AUTHORIZATION FOR WASTEWATER SYSTEM CONSTRUCTION HAS BEEN ISSUED
 PERMIT VOID IF NOT IN COMPLIANCE WITH ZONING REGULATIONS AND/ OR IF SITE IS ALTERED OR INTENDED USE CHANGED

PERMIT#: D047083 STATUS: A APP. DATE: 12/29/2011 BLDG. PERMIT#: 0121238
 PIN: 1810.03 24 6100 000 TAX MAP: 0227 0055 RECORDED: Y ORIG. PERMIT#:
 TOWNSHIP: 02 BARTON'S CREEK JURISDICTION: WC ZONING: R80W SW DEVICE: N S#:
 APPLICANT: ARBUTINA, CHRIS
 3411 INTEGRITY DR
 GARNER, NC 27529
 (919) 669 - 3235
 USE: HD USE: 101A CONVENTIONAL ONE-FAMILY H
 EXIST USE:
 LTAR: 0.30 0.30 BEDROOMS: 5 BASEMENT: Y #EMPLOYEES: 0
 SITE: ADDRESS: 15508 POSSUM TRACK RD
 SUBDIVISION: LOT: ACRES: 5.17 EASEMENT: N LOC: SYS:
 DIRECTION: SIX FORKS RD TO POSSUM TRACK PROPERTY ON L

Well System: WATER: INDIVIDUAL - TYPE: NEW

WELL LOG INFORMATION: DEPTH: 48 CASING DEPTH: 46 YIELD: 25 STATIC LEVEL: 46
 WELL CONTRACTOR: W. J. P. Co. REG.# _____ PUMP CONTRACTOR: _____ REG.# _____
 Construction Compliance GROUT APPROVED ☒ DATE 4/24/12 EHS nh
 WELLHEAD APPROVED ☐ DATE _____ EHS _____
 SYSTEM FINALIZED ☐ DATE _____ EHS _____
 COMMENTS: WELL SETBACKS: 50' FROM HOUSE, 40' FROM RIGHT PROPERTY LINE, 50'+ FROM SEPTIC SYSTEM AND 100' SETBACK
 FROM FRONT PROPERTY LINE, THE SETBACK OFF FRONT PROPERTY LINE IS FLEXABLE IF NEEDED.

Operation Permit

DESIGN FLOW: _____ gal./min. ACTUAL FLOW: _____ INNOVATIVE LETTER: _____
 INSTALLED BY: _____ INSTALLATION APPROVED BY: _____
 PROPRIETARY SYSTEM: _____ FILTER NO: _____
 COMMENTS: _____
 OPERATIONS PERMIT ISSUED? _____ OP DATE: _____ BY: _____

This permit is based in part on information provided by the homeowner or his/her representative in the application submitted for this permit. The Environmental Health Specialist is not responsible for false or misleading information contained in the application. The Environmental Health Specialist is also not responsible for concealed conditions on the property or for statements in this report that may have resulted from false or misleading statements provided to him in the application. Neither Wake County nor the Environmental Health Specialist warrants that the septic tank system will continue to function satisfactorily in the future or that the water supply will remain potable.

As Built Information:

Date: _____ Benchmark: _____ Rod reading: _____ Distance to Structure: _____
 ST: _____ gals ID#: _____ D.O.M.: _____ Elev.: _____ Distance to Well: _____
 PT: _____ gals ID#: _____ D.O.M.: _____ Elev.: _____
 D-box/FD/PM elev.: _____ Supply Line: _____ ft. Pump/Control Panel: _____
 Line 1: _____ Date: _____ Line 6: _____ Date: _____
 Line 2: _____ Date: _____ Line 7: _____ Date: _____
 Line 3: _____ Date: _____ Line 8: _____ Date: _____
 Line 4: _____ Date: _____ Line 9: _____ Date: _____
 Line 5: _____ Date: _____ Line 10: _____ Date: _____
 Distance to P/L: _____ Notes: _____

PERMIT 0121238
D047032

I certify that the location of planned or existing structure(s) are accurately shown. I understand failure to locate structures in accordance with this plot plan may require the relocation of structure(s) regardless degree of completion. I hereby grant permission to Municipal/County Representatives the right of entry to make evaluations or inspections upon this property.

THW
Signature of Owner or Authorized Agent

1" = 100'

Setbacks:

From Septic 58.09'

L-127.47


R-48.76

Rear 725.05

E.A. Site Plan

- 3 (3x200') lines, Plugged in Field
- Accepted status Nuclea, 25"
- reduction taken
- 28" Max trench depth
- 1500 gal S.T.

SWIMMING POOL LAYOUT PLAN Arbutina

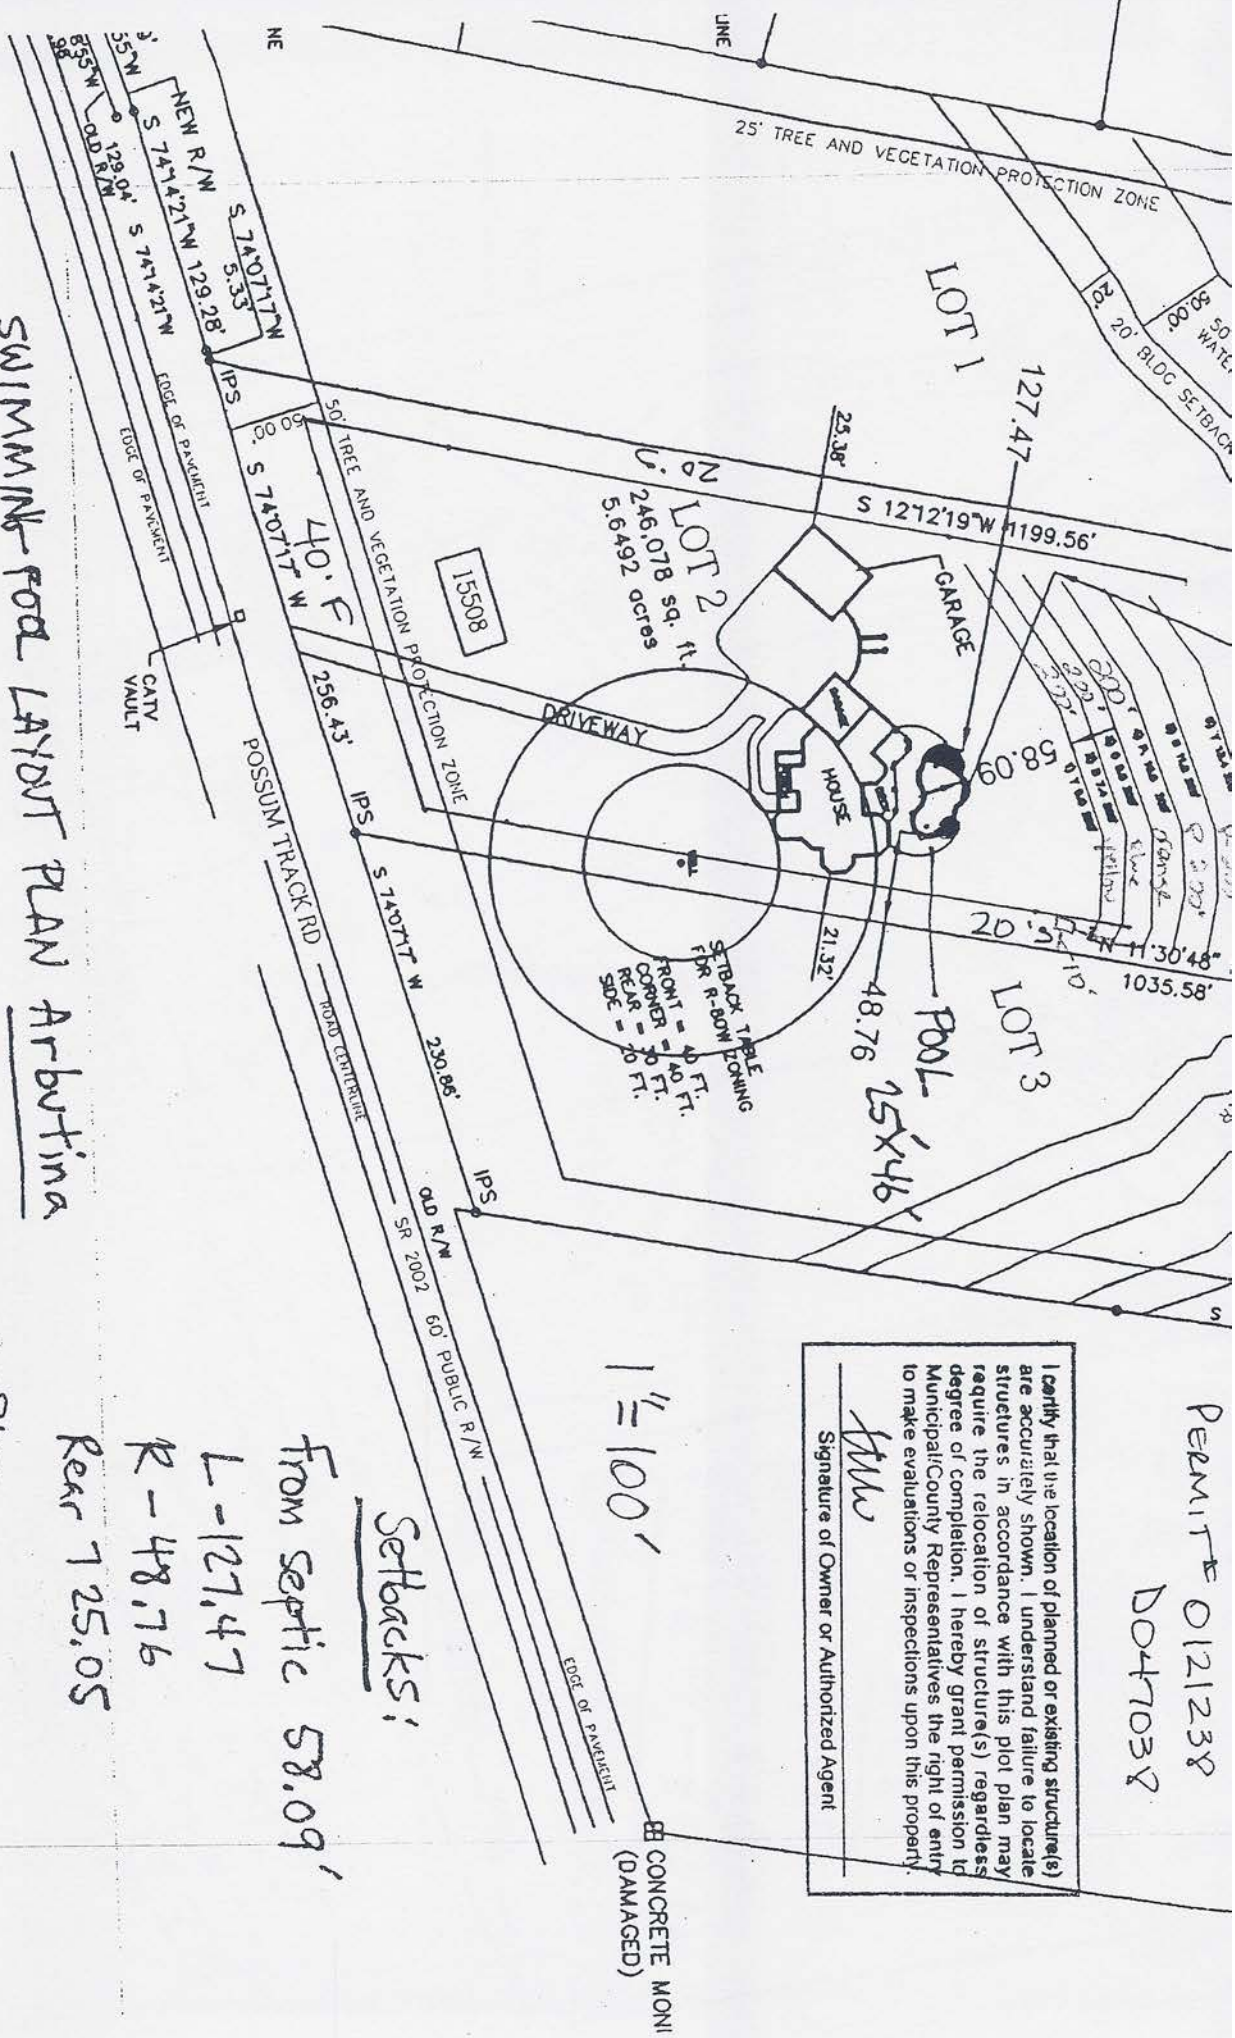



Community Services

INSPECTIONS/DEVELOPMENT PLANS/PERMITS

INSPECTION REQUEST LAND USE PERMITS
856-6060 856-6222

ENVIRONMENTAL SERVICES
856-7400

NOTE — IT IS UNLAWFUL TO OCCUPY OR TO PERMIT THE
OCCUPANCY OF ANY BUILDING FOR WHICH A CERTIFICATE
OF COMPLIANCE HAS NOT BEEN ISSUED.

Permit No. 0121238 Date 3.20.12
Address 15508 Possum Trace
Subdivision Arbutina Lot 2
Township Breitas Creek S.R. No. —
Area Zoned R80w COSD —

CONTRACTORS

General Don Cairns Bude
Plumbing Raleigh Plumbing
Heating / Air Conditioning Air Systems
Electrical Pedro Electric
Sprinkler _____

(Do Not Remove or Deface This Card)

House

BUILDING
PERMIT
NUMBER

0121238

IMPORTANT — Contractor performing work must call in for all inspections. Approved plans must be on job before work will be inspected.

Note: Display this card in a conspicuous location such as driveway entrance.

WORK REQUIRED TO BE INSPECTED AND APPROVED	INSPECTOR'S APPROVAL	DATE
1. SITE INSPECTION ZONING		
2. EXCAVATING — FOOTING		
3. TEMPORARY POLE		
4. ELECTRICAL GROUND WORK		
5. PLUMBING GROUND WORK		
6. MECHANICAL GROUND WORK		
7. BUILDING SLAB		
8. FOUNDATION		
9. ELECTRICAL ROUGH-IN		
10. HEATING & AIR CONDITIONING ROUGH-IN		
11. PLUMBING ROUGH-IN		
12. WATER FINAL		
13. SEWER FINAL		
14. COMPLETION OF WATER & SEWER SYSTEM		
15. FRAMING		
16. WALL INSULATION		
17. CHANGE OF SERVICE		
18. ELECTRICAL FINAL		
19. PLUMBING FINAL		
20. HEATING & AIR CONDITIONING FINAL		
21. BUILDING FINAL		
22.		
23.		
24. ENVIRONMENTAL SERVICES — WELL		
25. ENVIRONMENTAL SERVICES — SEPTIC		

WAKE COUNTY DEPARTMENT OF ENVIRONMENTAL SERVICES WELL AND SEWAGE SITE LOCATION PERMIT

NO PERMIT(S) FOR CONSTRUCTION, LOCATION OR RELOCATION ACTIVITY SHALL BE ISSUED
UNTIL AN AUTHORIZATION FOR WASTEWATER SYSTEM CONSTRUCTION HAS BEEN ISSUED

PERMIT VOID IF NOT IN COMPLIANCE WITH ZONING REGULATIONS AND/ OR IF SITE IS ALTERED OR INTENDED USE CHANGED

PERMIT#: D047083 STATUS: A APP. DATE: 12/29/2011 BLDG. PERMIT#: 0121238
PIN: 1810.03 24 6100 000 TAX MAP: 0227 0055 RECORDED: Y ORIG. PERMIT#:
TOWNSHIP: 02 BARTON'S CREEK JURISDICTION: WC ZONING: R80W SW DEVICE: N S#:
APPLICANT: ARBUTINA, CHRIS
3411 INTEGRITY DR
GARNER, NC 27529
(919) 669 - 3235
USE: HD USE: 101A CONVENTIONAL ONE-FAMILY H
EXIST USE:
LTAR: 0.30 0.30 BEDROOMS: 5 BASEMENT: Y #EMPLOYEES: 0
SITE: ADDRESS: 15508 POSSUM TRACK RD
SUBDIVISION: LOT: ACRES: 5.17 EASEMENT: N LOC: SYS:
DIRECTION: SIX FORKS RD TO POSSUM TRACK PROPERTY ON L

Well System: WATER: INDIVIDUAL - TYPE: NEW

WELL LOG INFORMATION: DEPTH: _____ CASING DEPTH: _____ YIELD: _____ STATIC LEVEL: _____
WELL CONTRACTOR: _____ REG.# _____ PUMP CONTRACTOR: _____ REG.# _____
Construction Compliance GROUT APPROVED ☐ DATE _____ EHS _____
WELLHEAD APPROVED ☐ DATE _____ EHS _____
SYSTEM FINALIZED ☐ DATE _____ EHS _____

COMMENTS: WELL SETBACKS: 50' FROM HOUSE, 40' FROM RIGHT PROPERTY LINE, 50'+ FROM SEPTIC SYSTEM AND 100' SETBACK FROM FRONT PROPERTY LINE, THE SETBACK OFF FRONT PROPERTY LINE IS FLEXABLE IF NEEDED.

DESIGN FLOW: _____ gal./min. ACTUAL FLOW: _____ Operation Permit
INNOVATIVE LETTER: _____
INSTALLED BY: _____ INSTALLATION APPROVED BY: _____
PROPRIETARY SYSTEM: _____ FILTER NO: _____
COMMENTS: _____

OPERATIONS PERMIT ISSUED? _____ OP DATE: _____ BY: _____

This permit is based in part on information provided by the homeowner or his/her representative in the application submitted for this permit. The Environmental Health Specialist is not responsible for false or misleading information contained in the application. The Environmental Health Specialist is also not responsible for concealed conditions on the property or for statements in this report that may have resulted from false or misleading statements provided to him in the application. Neither Wake County nor the Environmental Health Specialist warrants that the septic tank system will continue to function satisfactorily in the future or that the water supply will remain potable.

As Built Information:

Date: _____ Benchmark: _____ Rod reading: _____ Distance to Structure: _____
ST: _____ gals ID#: _____ D.O.M.: _____ Elev.: _____ Distance to Well: _____
PT: _____ gals ID#: _____ D.O.M.: _____ Elev.: _____
D-box/FD/PM elev.: _____ Supply Line: _____ ft. Pump/Control Panel: _____
Line 1: _____ Date: _____ Line 6: _____ Date: _____
Line 2: _____ Date: _____ Line 7: _____ Date: _____
Line 3: _____ Date: _____ Line 8: _____ Date: _____
Line 4: _____ Date: _____ Line 9: _____ Date: _____
Line 5: _____ Date: _____ Line 10: _____ Date: _____
Distance to P/L: _____ Notes: _____

WAKE COUNTY DEPARTMENT OF ENVIRONMENTAL SERVICES WELL AND SEWAGE SITE LOCATION PERMIT
NO PERMIT(S) FOR CONSTRUCTION, LOCATION OR RELOCATION ACTIVITY SHALL BE ISSUED
UNTIL AN AUTHORIZATION FOR WASTEWATER SYSTEM CONSTRUCTION HAS BEEN ISSUED
PERMIT VOID IF NOT IN COMPLIANCE WITH ZONING REGULATIONS AND/ OR IF SITE IS ALTERED OR INTENDED USE CHANGED

PERMIT#: D047083 STATUS: A APP. DATE: 12/29/2011 BLDG. PERMIT#: 0121238
PIN: 1810.03 24 6100 000 TAX MAP: 0227 0055 RECORDED: Y ORIG. PERMIT#:
TOWNSHIP: 02 BARTON'S CREEK JURISDICTION: WC ZONING: R80W SW DEVICE: N S#:
APPLICANT: ARBUTINA, CHRIS
3411 INTEGRITY DR
GARNER, NC 27529
(919) 669-3235
USE: HD USE: 101A CONVENTIONAL ONE-FAMILY H
EXIST USE:
LTAR: 0.30 0.30 BEDROOMS: 5 BASEMENT: Y #EMPLOYEES: 0 FOUNDATION DRAIN: Y
SITE: ADDRESS: 15508 POSSUM TRACK RD
SUBDIVISION: LOT: ACRES: 5.17 EASEMENT: N LOC: SYS:
DIRECTION: SIX FORKS RD TO POSSUM TRACK PROPERTY ON L

IMPROVEMENT PERMIT

TANK SIZE: 1500 gal. PUMP Tank: _____ gal. SQ FT: 1800 INNOVATIVE MAX DEPTH LINE: 28 in.
WASTEWATER: INDIVIDUAL SEWAGE: DOMESTIC TYPE SYSTEM: III G PUMP: N P/M: N
DAILY FLOW: 600 gal/day DESIGN FEE REQ?: PAID?: WATER: INDIVIDUAL

COMMENTS:


IP ISSUED? Y DATE: 01/26/2012 BY: (SCR)  PHONE#: 856-6194


AUTHORIZATION FOR WASTEWATER/WATER SYSTEM CONSTRUCTION
VOID SIXTY (60) MONTHS FROM DATE OF ISSUANCE
AUTHORIZATION CONDITIONS:

Contractors shall install system on contours, see attached site plan for wastewater system design and well location. No underground utilities, water lines or sprinkler systems may be located in the original system or repair areas. A septic tank filter with a riser for access is required. The wastewater system shall not be covered or placed into use until inspected by the Wake County Department of Environmental Services and an Operation Permit issued. An Accepted Status System may be used in place of conventional system, if it can be placed in the permitted/authorized trench footprint (except reduction in line length and/or number as allowed for in approval) and the installation is in accordance with the accepted system approval, without unauthorized product alteration. If permit required use of an Accepted Status System, substitution with another accepted status system may be made, as long as no changes are necessary in the location of each nitrification line (including any increase in line length), trench depth or effluent distribution method. If changes are necessary, prior approval by this office is required before system installation. OTHER

CONDITIONS:
INITIAL SYSTEM AND REPAIR PROPOSED BY CONSULTANT AS 3 200' LINES USING ACCEPTED STATUS MEDIA, 25% REDUCTION ALREADY TAKEN. LINES ARE FLAGGED OUT IN FIELD. KEEP MINIMUM SETBACK OF 15' FROM HOUSE TO SEPTIC TANK. KEEP MINIMUM SETBACK OF 10' FROM PROPERTY LINE TO D-BOX AND DRAIN LINES. SUPPLY MUST BE KEPT 5' FROM PROPERTY LINE. CALL OFFICE WITH ANY QUESTIONS PRIOR TO OR DURING INSTALLATION

TANK SIZE: 1500 gal. PUMP TANK: _____ gal. SQ FT: 1800 INNOVATIVE MAX DEPTH LINE: 28 in.
MAINT: N OPER: N L/O: P TRENCH#: 3 LENGTH: 200 ft. WIDTH: 36 in. DESIGNER: _____
SUBFIELDS: _____ DESIGN HEAD PRESSURE: _____ DESIGN FLOW: _____ gal/min DOSE VOLUME: _____ gal.

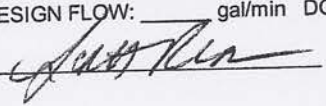
CA ISSUED? Y DATE: 03/05/2012 BY: (SCR)  PHONE#: 856-6194

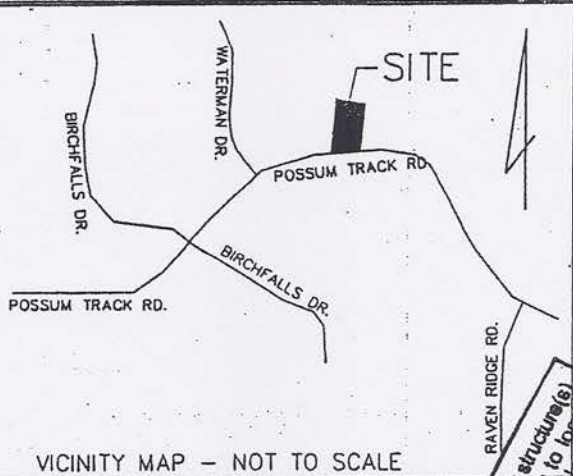

I certify that the location of planned or existing structure(s) are accurately shown. I understand failure to locate structures as shown is a ground violation. This plan may require the relocation of structure(s) regardless of degree of completion. I hereby grant permission to the Municipal/County Representatives the right of entry to make evaluations or inspections upon this property.

[Signature]
Signature of Owner or Authorized Agent

POINT AT FALLS LAKE
B.M. 1984 PG. 1576

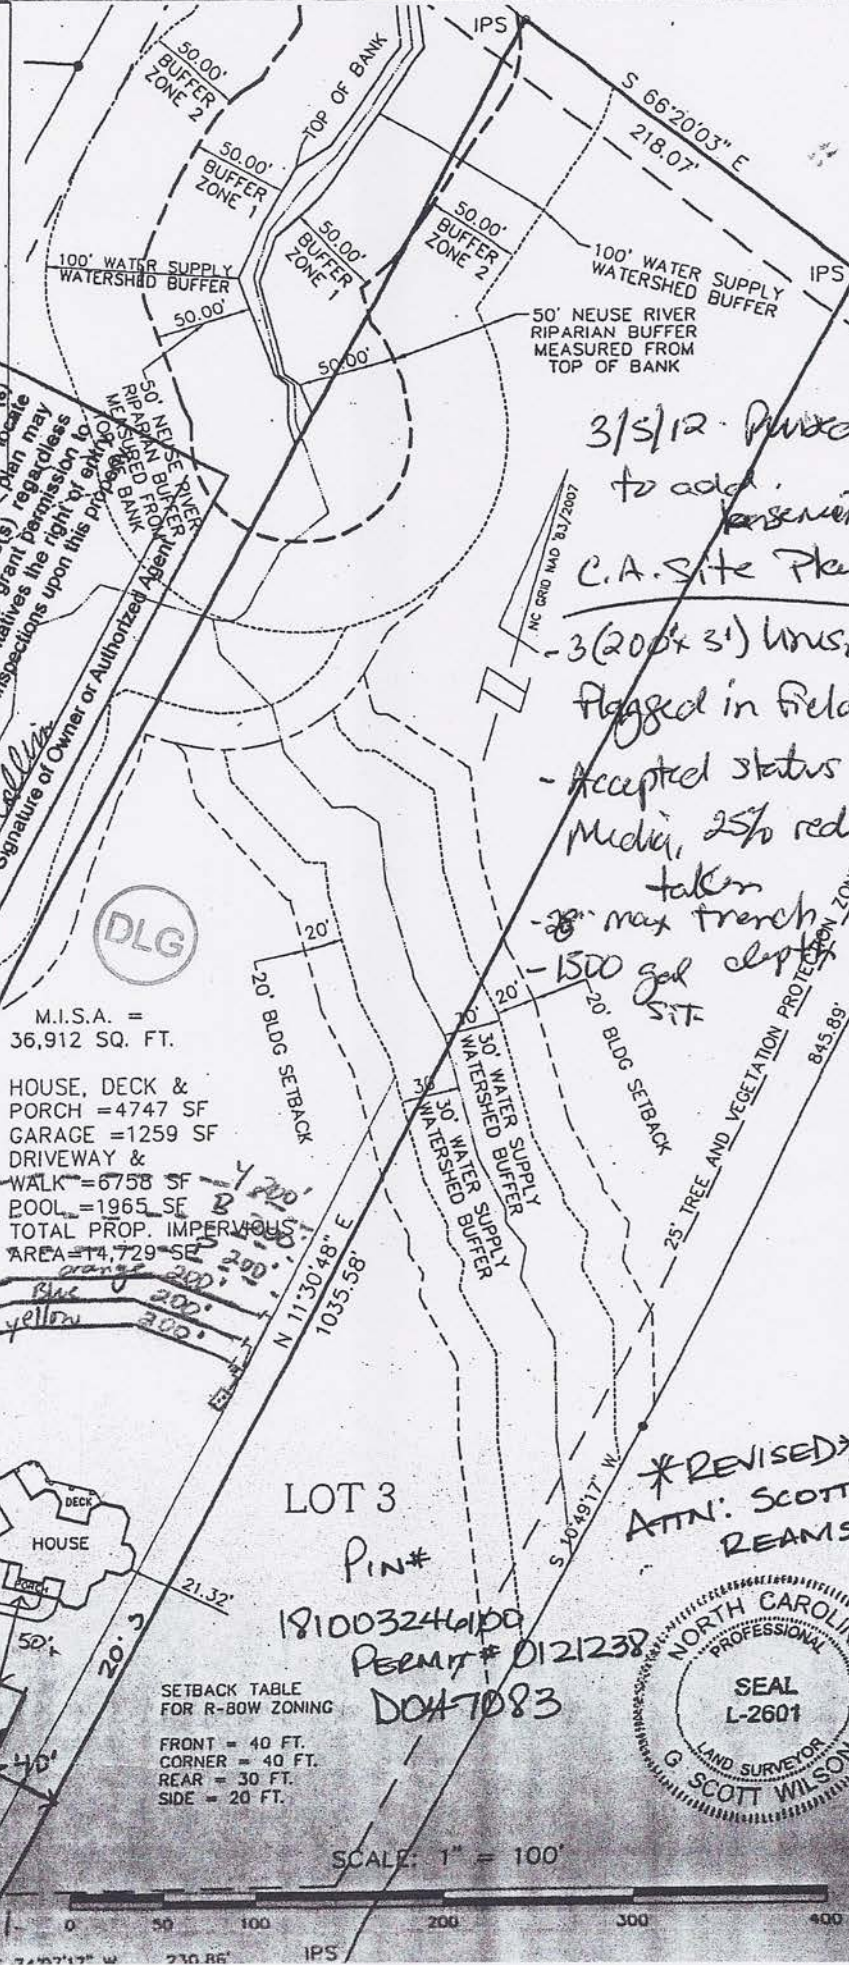


3/5/12 - Revised to add
C.A. Site Plan
- 3(200' x 3') lines, flagged in field
- Accepted status
Media, 25% reduction
- max trench
- 1500 gal cistern
SIT

25' Tree and Vegetation Protection Zone
Approve
Revise
Reject
Front
Side
Comments:
Date 3-1-12
Use MBL 101A
Rear
Corner

REVISED
ATTN: SCOTT REAMS
NORTH CAROLINA PROFESSIONAL
SEAL L-2601
LAND SURVEYOR
G. SCOTT WILSON

I certify that the location of planned or existing structure(s) are accurately shown. I understand failure to locate structures in accordance with this plot plan may require the relocation of structure(s) regardless of degree of completion. I hereby grant permission to Municipal/County Representatives the right of entry to make evaluations or inspections upon this property.

[Signature]
 Signature of Owner or Authorized Agent

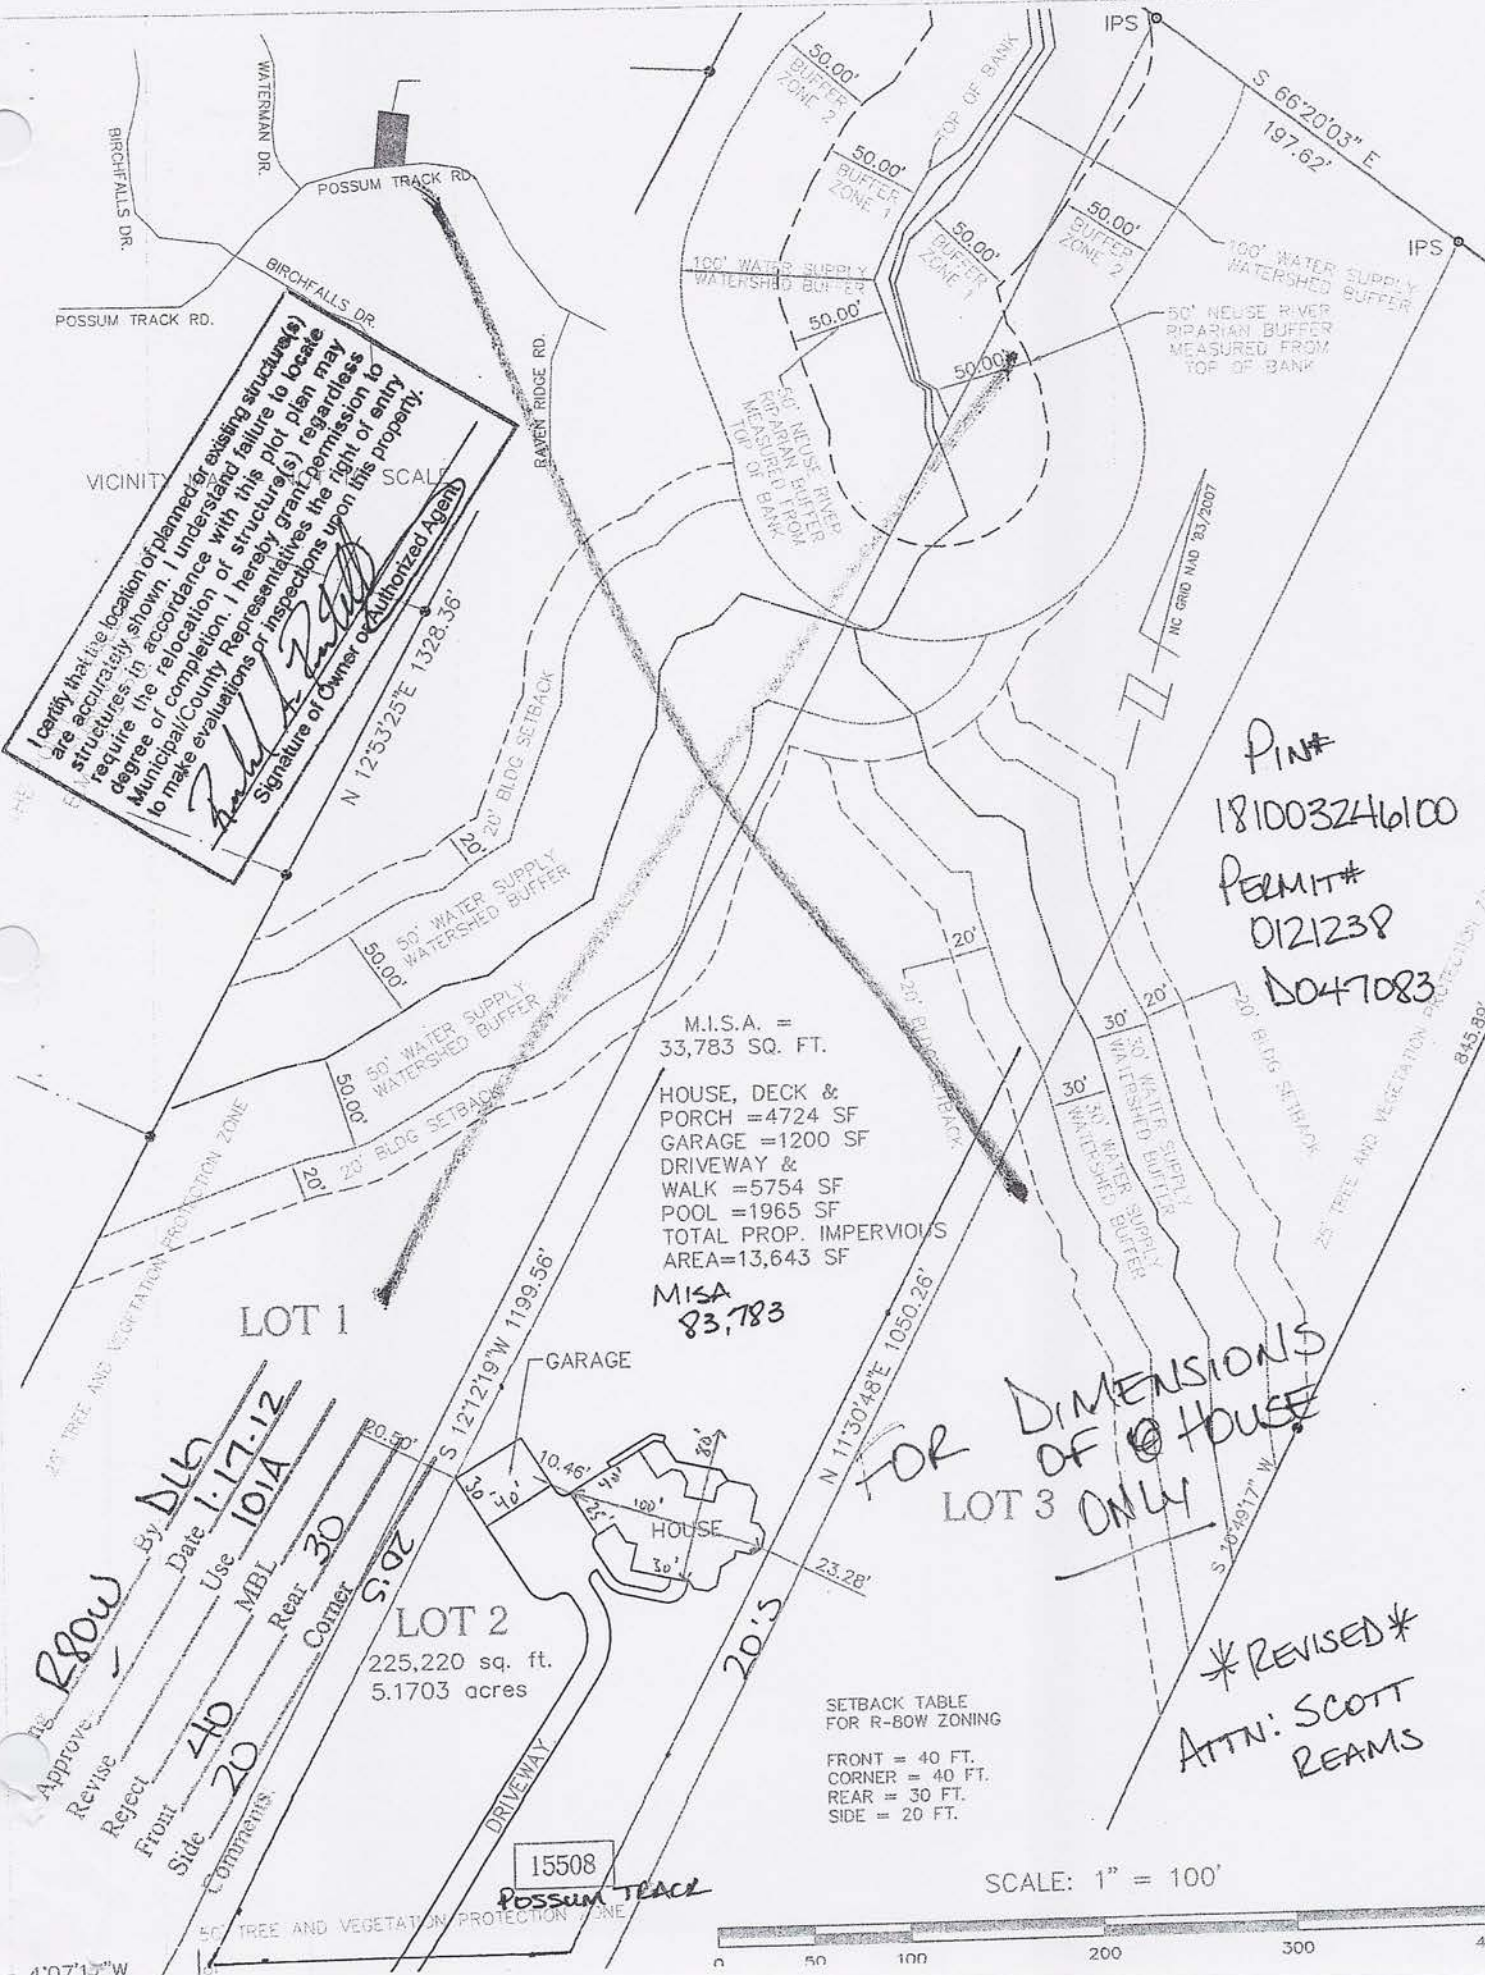

M.I.S.A. =
 33,783 SQ. FT.

HOUSE, DECK &
 PORCH = 4724 SF
 GARAGE = 1200 SF
 DRIVEWAY &
 WALK = 5754 SF
 POOL = 1965 SF
 TOTAL PROP. IMPERVIOUS
 AREA = 13,643 SF

MISA
 83,783

PIN#
 181003246100
 PERMIT#
 D121238
 D047083

FOR
 DIMENSIONS
 OF HOUSE
 LOT 3 ONLY

REVISED
 ATTN: SCOTT
 REAMS

SETBACK TABLE
 FOR R-BOW ZONING

FRONT = 40 FT.
 CORNER = 40 FT.
 REAR = 30 FT.
 SIDE = 20 FT.

SCALE: 1" = 100'



By *R80W*
 Date *1-17-12*
 Use *MBL*
 Front *40*
 Side *20*
 Rear *30*
 Corner *30*
 Comments

LOT 2
 225,220 sq. ft.
 5.1703 acres

15508

Possum Track

0121238

WAKE COUNTY COMMUNITY SERVICES
INSPECTIONS/DEVELOPMENT PLANS/PERMITS
WAKE COUNTY OFFICE BUILDING
RALEIGH, NORTH CAROLINA 27602
PHONE (919) 856-6222 FAX (919) 856-6229

PERMIT#: 0121238 STATUS: A APP DATE: 03/20/2012 FINALIZED: BY:
 APPL: DON COLLINS BUILDER TYP: G LIC#: 0 47216 ELEC TICKT#: UNKWN
 PRMT TYP: LND Y BLDG Y FIR WTRQ SWST DEED RF: 14435 2556 11 FARM EXMPT:
 TWP: 02 BARTON'S CREEK MAP-PARCEL: 0227 0055 PIN#: 1810.03 24 6100 000
 CITY: ZONING DIST: R80W OWNER: ARBUTINA, CHRIS
 SUBD FILE#: PHASE: SUB NAME: ARBUTINA LOT-SEC: 2
 SUBD IMPROVEMENT#: 12 PLAT REF: 2012 183 ACRES: 5.17
 CENSUS TR: 538 01 TOPFLR: U FIRPLC: P TEMP POLE: Y IMPROV VAL: 1200000
 USE CODE: 101 A CONVENTIONAL ONE-FAMILY HOUSE SQ-FT: 7676 STORY: 3 STORY
 EXIST USE: ORIG PERMIT#: RECPT: FEE:\$1707.00 RECOVERY FUND: Y FEE EXEMPT: ROOMS: 10 BDRMS: 05
 HEALTH#: D047083 WATER: I PRIV SEWER: I PRIV PUMP: N OP: BY:
 BSMT: Y GARB DISPOSAL: N # OF EMPLOYEES: FOOD HANDLING:
 MAKE/MODEL SERIAL# UL/HUD# YR SIZE COLOR
 MB/HOME DATA: X
 BD/ADJ REQUIRED: DATE: CASE#: ACTION:
 LOCATION: 15508 POSSUM TRACK RD
 COMMENT: SIX FORKS RD TO POSSUM TRACK PROPERTY ON L(2 1/
 2ST 5BR SFD,FIN BSMT,GAR,2PRFB,F/R POR,R DECK,P
 ATIO ON GRDE,3RD LVL UNF ATTIC,ELEVTR,RET WALLS

CONTRACTOR TYPE	NAME	LIC#
BUILDING	DON COLLINS BUILDER	047216
ELECTRICAL	PEDRO ELECTRIC	U21572
MECHANICAL	AIR SYSTEMS	H14737
PLUMBING	RALEIGH PLUMB	P17542

LOT AREA _____ SQ. FT. FRONT YARD DEPTH 40 T CORNER YARD DEPTH _____ FT

LOT WIDTH _____ SQ. FT. SIDE YARD DEPTH 20 FT. REAR YARD DEPTH 30

PLANS APPROVED DATE
 JWW 03-19-12

PROCESSED BY: (DLG)

THE APPLICANT AGREES TO COMPLY WITH ALL BUILDING REGULATIONS AND OTHER LAWS APPLICABLE TO THE USE OF THE STRUCTURE AND FACILITIES REFERRED TO HEREIN. THE PERMIT ISSUED FOR WORK SHALL EXPIRE BY LIMITATION SIX MONTHS AFTER THE DATE OF ISSUANCE IF THE WORK AUTHORIZED HAS NOT BEEN COMMENCED. IF AFTER COMMENCEMENT THE WORK IS DISCONTINUED FOR A PERIOD OF 12 MONTHS, THE PERMIT THEREFORE SHALL IMMEDIATELY EXPIRE. NO WORK AUTHOURIZED BY ANY PERMIT THAT HAS EXPIRED SHALL THEREFORE BE PERFORMED UNTIL A NEW PERMIT HAS BEEN SECURED.

SIGNATURE

DATE

3/20/12

0121239

WAKE COUNTY COMMUNITY SERVICES
INSPECTIONS/DEVELOPMENT PLANS/PERMITS
WAKE COUNTY OFFICE BUILDING
RALEIGH, NORTH CAROLINA 27602
PHONE (919) 856-6222 FAX (919) 856-6229

PERMIT#: 0121239 STATUS: A APP DATE: 03/20/2012 FINALIZED: BY:
 APPL: DON COLLINS BUILDER TYP: G LIC#: 0 47216 ELEC TICKT#: UNKWN
 PRMT TYP: LND Y BLDG Y FIR WTRQ SWST DEED RF: 14435 2556 11 FARM EXMPT:
 TWP: 02 BARTON'S CREEK MAP-PARCEL: 00227 0055 PIN#: 1810.03 24 6100 000
 CITY: ZONING DIST: R80W OWNER: ARBUTINA, CHRIS
 SUBD FILE#: PHASE: SUB NAME: LOT-SEC:
 SUBD IMPROVEMENT#: 12 PLAT REF: 2012 183 ACRES: 5.17
 CENSUS TR: 538 01 TOPFLR: N FIRPLC: N TEMP POLE: N IMPROV VAL: 100000
 USE CODE: 436 D RESIDENTIAL DETACHED GARAGE SQ-FT: 1200 STORY: 1 STORY
 EXIST USE: 101 A CONVENTIONAL ONE-FAMILY HOUSE ORIG PERMIT#: 0121238
 RECPT: FEE: \$470.00 RECOVERY FUND: Y FEE EXEMPT: ROOMS: BDRMS:
 HEALTH#: WATER: SEWER: PUMP: OP: BY:
 BSMT: GARB DISPOSAL: # OF EMPLOYEES: FOOD HANDLING:
 MAKE/MODEL SERIAL# UL/HUD# YR SIZE COLOR
 MB/HOME DATA: X
 BD/ADJ REQUIRED: DATE: CASE#: ACTION:
 LOCATION: 15508 POSSUM TRACK RD
 COMMENT: SIX FORKS RD TO POSSUM TRACK PROPERTY ON L
 (1ST DET GAR WITH UTILITIES)

CONTRACTOR TYPE	NAME	LIC#
BUILDING	DON COLLINS BUILDER	047216
ELECTRICAL	PEDRO ELECTRIC	U21572
MECHANICAL	AIR SYSTEMS	H14737
PLUMBING	RALEIGH PLUMB	P17542

LOT AREA _____ SQ. FT. FRONT YARD DEPTH foh T CORNER YARD DEPTH _____ FT

LOT WIDTH _____ SQ. FT. SIDE YARD DEPTH 10 FT. REAR YARD DEPTH 10

PLANS APPROVED DATE
 JWW 03-19-12

PROCESSED BY: (DLG)

THE APPLICANT AGREES TO COMPLY WITH ALL BUILDING REGULATIONS AND OTHER LAWS APPLICABLE TO THE USE OF THE STRUCTURE AND FACILITIES REFERRED TO HEREIN. THE PERMIT ISSUED FOR WORK SHALL EXPIRE BY LIMITATION SIX MONTHS AFTER THE DATE OF ISSUANCE IF THE WORK AUTHORIZED HAS NOT BEEN COMMENCED. IF AFTER COMMENCEMENT THE WORK IS DISCONTINUED FOR A PERIOD OF 12 MONTHS, THE PERMIT THEREFORE SHALL IMMEDIATELY EXPIRE. NO WORK AUTHORIZED BY ANY PERMIT THAT HAS EXPIRED SHALL THEREFORE BE PERFORMED UNTIL A NEW PERMIT HAS BEEN SECURED.

SIGNATURE

DATE

3/20/12