

Environmental Services - Water Quality
Onsite Wastewater Scan Data Entry Form

PERMIT #: 8025287

PIN #: 0880933243

OP DATE: 11/10/1982

SYSTEM USE:

- ☒ House
☐ Mobile Home
☐ Business
☐ Other

SEWAGE TYPE:

- ☒ Domestic
☐ Industrial

PUMP/SIPHON?:

- ☐ Yes
☒ No

PRESSURE MANIFOLD:

- ☐ Yes
☒ No

SYSTEM TYPE:

- ☐ I
☒ II
☐ III
☐ IV
☐ V
☐ VI
☐ Other

SUB TYPE:

- ☒ A
☐ B
☐ C
☐ D
☐ E
☐ F
☐ G

NBR BEDROOMS:

- ☐ 1
☐ 2
☒ 3
☐ 4
☐ 5
☐ 6
☐ Other

MAINT. SCHEDULE:

- ☐ Yes
☒ No

CERT. OPERATOR

- ☐ Yes
☒ No

GT ST PT SIZE

- | | | | |
|-------------------------------------|-------------------------------------|-------------------------------------|------------------|
| ☐ | ☐ | | 750 |
| ☐ | ☐ | ☐ | 900 |
| ☐ | ☒ | ☐ | 1,000 |
| ☐ | ☐ | ☐ | 1,200 |
| ☐ | ☐ | ☐ | 1,500 |
| ☐ | ☐ | ☐ | 1,800 |
| ☐ | ☐ | ☐ | 2,100 |
| ☐ | ☐ | ☐ | 2,500 |
| ☐ | ☐ | ☐ | 3,000 |
| ☐ | ☐ | ☐ | 4,000 |
| ☐ | ☐ | ☐ | 5,000 |
| ☐ | ☐ | ☐ | 8,000 |
| ☐ | ☐ | ☐ | 10,000 |
| ☐ | ☐ | ☐ | Other |
| ☒ | | ☒ | None/NA GT or PT |

DRAINFIELD SIZE(SQ. FT.)

01000

DRAIN TYPE:

- ☒ Stone
☐ EZ Flow
☐ Infiltrator
☐ Biodiffuser
☐ Cultec
☐ Drip
☐ Hancor
☐ Large Dia. Pipe
☐ Multi-Pipe
☐ Other

MAX DEPTH (IN.):

- ☐ 12 in. or less
☐ 18 in. or less
☐ 24 in. or less
☐ 26 in. or less
☐ 28 in. or less
☐ 30 in. or less
☐ 32 in. or less
☐ 36 in. or less
☒ Other

STONE DEPTH (IN.):

- ☐ 8 in. or less
☒ 12 in. or less
☐ 18 in. or less
☐ 24 in. or less
☐ Other

TRENCHES:

- ☒ Individual
☐ Bed

TRENCH WIDTH (IN.):

- ☐ 12 in. or less
☐ 18 in.
☐ 24 in.
☐ 36 in.
☐ 6 ft. or less
☐ 9 ft. or less
☒ Other

[Handwritten signature]

F-821-0779

17-98 02:29P

319-457-5463

919-467-5463

PAGE 03

P. 03

WAKE COUNTY HEALTH DEPARTMENT SEPTIC TANK LAYOUT AND PERMIT

25287

PERMIT NO. 8

CONTRACTOR: Tom Higgs

OWNER: Tom Higgs

DATE: 8-25-82

LOCATION: 11905 Appleton Road

SUBDIVISION NAME: Black Horse Run LOT NO. 37 SECTION OR BLOCK NO. II

S. R. NO. 1831

2(167A3)

REPAIR ☐ ORIGINAL PERMIT NO. _____

CARBIDE DISPOSAL UNIT ☐ YES ☒ NO ☒

HOUSE ☒ MOBILE HOME ☐ BUSINESS ☐

NO. BEDROOMS 3 LOT AREA 1.55 AC.

SIZE OF TANK 12' X 30'

NITRIFICATION UNIT 2(167A3) 1000

DEPTH OF STONE IN LINES: 12" ☒ 18" ☐

RISER AND BATTLE REQUIRED ☒ PUMP REQUIRED ☐

WATER SUPPLY: INDIVIDUAL ☒ PUBLIC ☐ OTHER ☐

* PERMIT VOID IN VIOLATION FROM DATE OF ISSUANCE.

* PERMIT VOID IF NOT IN COMPLIANCE WITH ZONING REGULATIONS.

* PERMIT MAY BE MODIFIED BY THE AERATION UNIT.


LAYOUT BY Kathy Tew

DATE 11-10-82

DESIGNED BY Thom Higgs

APPROVED BY Thom Higgs

11755 Appleton Road, Suite 200, Raleigh, NC 27603

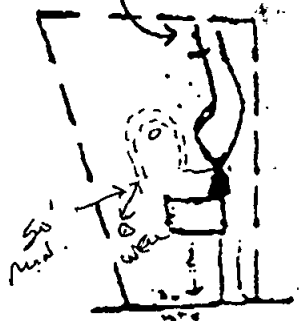

in
effluent pipe
to front
yard

* Kim, needs you to check a DIT and

repair permit for this one

* please call Forest Hill Design at
821-1440 and then fax over

- ADD 1 (6' x 80') TRENCH TO EXISTING D-BOX AS SHOWN

- USE 18" OF STONE

- MAXIMUM DEPTH 26"

- EXISTING SEPTIC TANK O.K.

- 5' x 30' INJURY FROM WEL