

Environmental Services - Water Quality
Onsite Wastewater Scan Data Entry Form

PERMIT #: 0024319

PIN #: 1801417878

OP DATE: 0211812003

SYSTEM USE:

- ☒ House
☐ Mobile Home
☐ Business
☐ Other

SEWAGE TYPE:

- ☒ Domestic
☐ Industrial

PUMP/SIPHON?:

- ☐ Yes
☒ No

PRESSURE MANIFOLD:

- ☐ Yes
☒ No

SYSTEM TYPE:

- ☐ I
☐ II
☒ III
☐ IV
☐ V
☐ VI
☐ Other

SUB TYPE:

- ☐ A
☐ B
☐ C
☐ D
☐ E
☐ F
☒ G

NBR BEDROOMS:

- ☐ 1
☐ 2
☐ 3
☒ 4
☐ 5
☐ 6
☐ Other

MAINT. SCHEDULE:

- ☐ Yes
☒ No

CERT. OPERATOR

- ☐ Yes
☒ No

GT	ST	PT	SIZE
☐	☐		750
☐	☐	☐	900
☐	☒	☐	1,000
☐	☒	☐	1,200
☐	☐	☐	1,500
☐	☐	☐	1,800
☐	☐	☐	2,100
☐	☐	☐	2,500
☐	☐	☐	3,000
☐	☐	☐	4,000
☐	☐	☐	5,000
☐	☐	☐	8,000
☐	☐	☐	10,000
☐	☐	☐	Other
☒		☒	None/NA GT or PT

DRAINFIELD SIZE(SQ. FT.)

01200

DRAIN TYPE:

- ☐ Stone
☒ EZ Flow
☐ Infiltrator
☐ Biodiffuser
☐ Cultec
☐ Drip
☐ Hancor
☐ Large Dia. Pipe
☐ Multi-Pipe
☐ Other

MAX DEPTH (IN.):

- ☐ 12 in. or less
☐ 18 in. or less
☒ 24 in. or less
☐ 26 in. or less
☐ 28 in. or less
☐ 30 in. or less
☐ 32 in. or less
☐ 36 in. or less
☐ Other

STONE DEPTH (IN.):

- ☐ 8 in. or less
☒ 12 in. or less
☐ 18 in. or less
☐ 24 in. or less
☐ Other

TRENCHES:

- ☒ Individual
☐ Bed

TRENCH WIDTH (IN.):

- ☐ 12 in. or less
☐ 18 in.
☐ 24 in.
☒ 36 in.
☐ 6 ft. or less
☐ 9 ft. or less
☐ Other

WAKE COUNTY DEPARTMENT OF ENVIRONMENTAL SERVICES WELL AND SEWAGE SITE LOCATION PERMIT

NO PERMIT(S) FOR CONSTRUCTION, LOCATION OR RELOCATION ACTIVITY SHALL BE ISSUED

UNTIL AN AUTHORIZATION FOR WASTEWATER SYSTEM CONSTRUCTION HAS BEEN ISSUED

PERMIT VOID IF NOT IN COMPLIANCE WITH ZONING REGULATIONS AND/ OR IF SITE IS ALTERED OR INTENDED USE CHANGED

PERMIT#: D024319 STATUS: A APP. DATE: 05/01/2002 BLDG. PERMIT#: 0023184
 PIN: 1801.04-54-2682-000 03 41 7878 TAX MAP: 0199 0011 RECORDED: Y ORIG. PERMIT#:
 TOWNSHIP: 02 BARTON'S CREEK JURISDICTION: WC ZONING: 80W
 APPLICANT: DREES COMPANY
 7701 SIX FORKS RD
 RALEIGH, NC 27615
 (919) 844 - 9288
 USE: HD USE: 101 ONE-FAMILY HOUSE
 EXIST USE:
 DISPOSAL: N BEDROOMS: 4 BASEMENT: N #EMPLOYEES: 0
 SITE: ADDRESS: 7233 LOBLOLLY PINE DR
 SUBDIVISION: REMINGTON FORES LOT: 6 ACRES: 1.17
 DIRECTION: SIX FORKS N R HWY 98 1/2 MI ON R

Well System: WATER: COMMUNITY - TYPE: EXISTING

WELL LOG INFORMATION: DEPTH: _____ CASING DEPTH: _____ YIELD: _____ STATIC LEVEL: _____
 WELL CONTRACTOR: _____ REG.# _____ PUMP CONTRACTOR: _____ REG.# _____
 Construction Compliance GROUT APPROVED ☐ DATE _____ EHS _____
 WELLHEAD APPROVED ☐ DATE _____ EHS _____
 SYSTEM FINALIZED ☐ DATE _____ EHS _____

COMMENTS:

Operation Permit

DESIGN FLOW: _____ gal./min. ACTUAL FLOW: _____ INNOVATIVE LETTER: _____

INSTALLED BY: Quality Landscape INSTALLATION APPROVED BY: Willie L. Wood
 PROPRIETARY SYSTEM: _____ FILTER NO: _____
 COMMENTS: _____

OPERATIONS PERMIT ISSUED? Y OP DATE: 2-18-02 BY: Willie L. Wood

This permit is based in part on information provided by the homeowner or his/her representative in the application submitted for this permit. The Environmental Health Specialist is not responsible for false or misleading information contained in the application. The Environmental Health Specialist is also not responsible for concealed conditions on the property or for statements in this report that may have resulted from false or misleading statements provided to him in the application. Neither Wake County nor the Environmental Health Specialist warrants that the septic tank system will continue to function satisfactorily in the future or that the water supply will remain potable.

WAKE COUNTY DEPARTMENT OF ENVIRONMENTAL SERVICES WELL AND SEWAGE SITE LOCATION PERMIT

NO PERMIT(S) FOR CONSTRUCTION, LOCATION OR RELOCATION ACTIVITY SHALL BE ISSUED

UNTIL AN AUTHORIZATION FOR WASTEWATER SYSTEM CONSTRUCTION HAS BEEN ISSUED

PERMIT VOID IF NOT IN COMPLIANCE WITH ZONING REGULATIONS AND/ OR IF SITE IS ALTERED OR INTENDED USE CHANGED

PERMIT#: D024319 STATUS: A APP. DATE: 05/01/2002 BLDG. PERMIT#: 0023184
PIN: 1801.04 51 2683 000 TAX MAP: 0199 0011 RECORDED: Y ORIG. PERMIT#:
TOWNSHIP: 02 BARTON'S CREEK JURISDICTION: WC ZONING: 80W
APPLICANT: DREES COMPANY
7701 SIX FORKS RD
RALEIGH, NC 27615
(919) 844 - 9288
USE: HD USE: 101 ONE-FAMILY HOUSE
EXIST USE:
DISPOSAL: N BEDROOMS: 4 BASEMENT: N #EMPLOYEES: 0
SITE: ADDRESS: 7233 LOBLOLLY PINE DR
SUBDIVISION: REMINGTON FORES LOT: 6 ACRES: 1.17
DIRECTION: SIX FORKS N R HWY 98 1/2 MI ON R

IMPROVEMENT PERMIT

TANK SIZE: 1200 gal. PUMP Tank: _____ gal. SQ FT: 1200 INNOVATIVE MAX DEPTH LINE: 20 in.
WASTEWATER: INDIVIDUAL SEWAGE: DOMESTIC TYPE SYSTEM: III G PUMP: N P/M: N
DAILY FLOW: 480 gal/day WATER: COMMUNITY

COMMENTS:

IP ISSUED? Y DATE: 05/08/2002 BY: (WDW) William Woodard PHONE#: 856-7468

AUTHORIZATION FOR WASTEWATER/WATER SYSTEM CONSTRUCTION

VOID SIXTY (60) MONTHS FROM DATE OF ISSUANCE

AUTHORIZATION CONDITIONS:

Contractors shall install system on contours, see attached site plan for wastewater system design and well location. No underground utilities, water lines or sprinkler systems may be located in the original system or repair areas. A septic tank filter with a riser for access is required. The wastewater system shall not be covered or placed into use until inspected by the Wake County Department of Environmental Services and an Operation Permit issued. **OTHER CONDITIONS:**

INSTALL ON CONTOUR. INNOVATIVE SYSTEM. TRENCH BOTTOM CANNOT EXCEED 20". PUMP TO D-BOX MAY BE REQUIRED IF ADEQUATE FALL CANNOT BE OBTAINED FROM SEPTIC TANK TO D-BOX WHILE MAINTAINING 20" TRENCH BOTTOM. IF PUMP SYSTEM IS NEEDED CALL BEFORE INSTALLING FOR REQUIREMENTS & DESIGN CRITERIA. NO GRADING OR LANDSCAPING OF SEPTIC/REPAIR AREA. NO UTILITIES THROUGH SEPTIC/REPAIR AREA. MAINTAIN ALL REQUIRED SETBACKS. 1200 GALLON SEPTIC TANK. CALL IF YOU HAVE QUESTIONS. PERMIT VOID IF SITE OR SITE CONDITIONS CHANGE.

TANK SIZE: 1200 gal. PUMP TANK: _____ gal. SQ FT: 1200 INNOVATIVE MAX DEPTH LINE: 20 in.
MAINT: N OPER: N L/O: Y TRENCH#: 4 LENGTH: 100 ft. WIDTH: 36 in.
SUBFIELDS: _____ DESIGN HEAD PRESSURE: _____ DESIGN FLOW: _____ gal/min DOSE VOLUME: _____ gal.

CA ISSUED? Y DATE: 02/11/2003 BY: (WDW) William Woodard PHONE#: 856-7468

PROPERTY OF
A. SCOTT MANFREDO & wife; VERONICA E. MANFREDO
 LOT 6, REMINGTON FOREST SUBDIVISION
 7233 LOBLOLLY PINE DRIVE
 SCALE: 1"= 50'
 REFERENCES: BM 2002, PG 664

BARTONS CREEK T'SHIP
 WAKE COUNTY
 NORTH CAROLINA
 MARCH 24, 2003

LEGEND
 *EIP - EXISTING IRON PIPE
 *IP - IRON PIPE SET
 *A - ADDRESS
 *C - CONCRETE MONUMENT
 *WV - WATER VALVE
 *SM - SEWER MANHOLE
 *PP - POWER POLE
 --- ADJOINING LOT LINES


SEABROOK O. SHAFFER
 D.B. 6322, PG. 546
 B.M. 1988, PG. 511
 PIN NO. 1801.03-41-3894

18

ADOPTED NORTH
 (BM2002, PG664)

I certify that the location of planned or existing structure(s) are accurately located. I further certify that this plot plan may require the relocation of structure(s) regardless of degree of correction. I hereby grant permission to Municipal/Cc. Representatives the right of entry to make evaluations or inspections upon this property.

Signature of Buyer or Authorized Agent

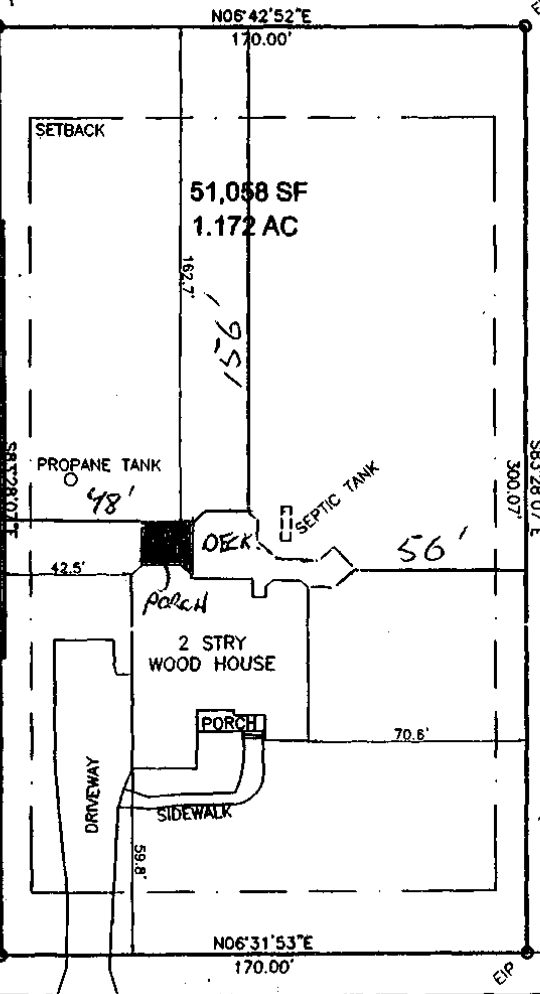


REMINGTON FOREST
 MAP 1
 OPEN SPACE

House 2880
 DRINK 1330
 WALKWAY 248
 PORCH 240
 TOTAL 4698
 TOTAL LOT 51,058
 % 10.86.

PK NAIL @
 INTERSECTION OF LOBLOLLY DRIVE
 & HIDDEN RIVER COURT

7233 LOBLOLLY PINE DRIVE
 Site plan approved as shown for porch
 Any changes to site plan voids approval.

for septic systems and wells, regarding any pools, decks, additions and/or accessory structures. Applicant is responsible for protecting all portions of the septic system, repair area and wells from damage during construction. Adhere to all Local and State Rules.
 Approved by NEWCOMB Date 11/1/06
 Wake County Department of Environmental Services
 Water and Waste Water Section

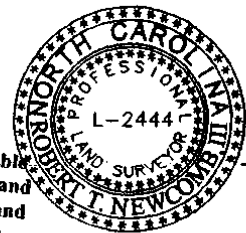

NEWCOMB land surveyors, LLC, 246 West Millbrook Road, Raleigh, NC 27609
 Phone (919) 847-1800, Fax (919) 847-1804

Special H.U.D. Flood Insurance Area ☐ No ☐ Yes ☐ Area Not Mapped
☐ See Flood Certification Sheet Attached ☐ As per Record Plat

022820
 LOT 6_FNL

I, Robert T. Newcomb, III, certify that this plat was drawn under my supervision from an actual survey made under my supervision from references as noted; that the boundaries not surveyed are clearly indicated as drawn from information noted under references; that the ratio of precision as calculated is greater than 1:10,000; that this plat was prepared in accordance with NCGS 47-30 as amended.

Witness my original signature, registration number and seal this 18 day of MARCH, 2003

This survey is of an existing parcel and does not create a new street or change an existing street.

Robert T. Newcomb, III
 Professional Land Surveyor L-2444