

**Environmental Services - Water Quality  
Onsite Wastewater Scan Data Entry Form**

PERMIT #: 0004150

PIN #: 0881956763

OP DATE: 0510911997

**SYSTEM USE:**

- ☒ House  
☐ Mobile Home  
☐ Business  
☐ Other

**SEWAGE TYPE:**

- ☒ Domestic  
☐ Industrial

**PUMP/SIPHON?:**

- ☐ Yes  
☒ No

**PRESSURE MANIFOLD:**

- ☐ Yes  
☒ No

**SYSTEM TYPE:**

- ☐ I  
☒ II  
☐ III  
☐ IV  
☐ V  
☐ VI  
☐ Other

**SUB TYPE:**

- ☒ A  
☐ B  
☐ C  
☐ D  
☐ E  
☐ F  
☐ G

**NBR BEDROOMS:**

- ☐ 1  
☐ 2  
☐ 3  
☒ 4  
☐ 5  
☐ 6  
☐ Other

**MAINT. SCHEDULE:**

- ☐ Yes  
☒ No

**CERT. OPERATOR**

- ☐ Yes  
☒ No

| GT                                  | ST                                  | PT                                  | SIZE             |
|-------------------------------------|-------------------------------------|-------------------------------------|------------------|
| <input type="checkbox"/>            | <input type="checkbox"/>            |                                     | 750              |
| <input type="checkbox"/>            | <input type="checkbox"/>            | <input type="checkbox"/>            | 900              |
| <input type="checkbox"/>            | <input type="checkbox"/>            | <input type="checkbox"/>            | 1,000            |
| <input type="checkbox"/>            | <input checked="" type="checkbox"/> | <input type="checkbox"/>            | 1,200            |
| <input type="checkbox"/>            | <input type="checkbox"/>            | <input type="checkbox"/>            | 1,500            |
| <input type="checkbox"/>            | <input type="checkbox"/>            | <input type="checkbox"/>            | 1,800            |
| <input type="checkbox"/>            | <input type="checkbox"/>            | <input type="checkbox"/>            | 10,000           |
| <input type="checkbox"/>            | <input type="checkbox"/>            | <input type="checkbox"/>            | Other            |
| <input checked="" type="checkbox"/> |                                     | <input checked="" type="checkbox"/> | None/NA GT or PT |

**DRAINFIELD SIZE(SQ. FT.)**

01200

**DRAIN TYPE:**

- ☒ Stone  
☐ EZ Flow  
☐ Infiltrator  
☐ Biodiffuser  
☐ Cultec  
☐ Drip  
☐ Hancor  
☐ Large Dia. Pipe  
☐ Multi-Pipe  
☐ Other

**MAX DEPTH (IN.):**

- ☐ 12 in. or less  
☐ 18 in. or less  
☒ 24 in. or less  
☐ 26 in. or less  
☐ 28 in. or less  
☐ 30 in. or less  
☐ 32 in. or less  
☐ 36 in. or less  
☐ Other

**STONE DEPTH (IN.):**

- ☐ 8 in. or less  
☒ 12 in. or less  
☐ 18 in. or less  
☐ 24 in. or less  
☐ Other

**TRENCHES:**

- ☒ Individual  
☐ Bed

**TRENCH WIDTH (IN.):**

- ☐ 12 in. or less  
☐ 18 in.  
☐ 24 in.  
☒ 36 in.  
☐ 6 ft. or less  
☐ 9 ft. or less  
☐ Other

B.W 11/13/13

## WAKE COUNTY HEALTH DEPARTMENT WELL AND SEWAGE SITE, LOCATION PERMIT

NO PERMIT(S) FOR CONSTRUCTION, LOCATION OR RELOCATION ACTIVITY SHALL BE ISSUED  
UNTIL AN AUTHORIZATION FOR WASTEWATER SYSTEM CONSTRUCTION HAS BEEN ISSUED.

Pin # 0881.02956763 Project # 0971331

Tax Map No. \_\_\_\_\_

Parcel No. \_\_\_\_\_

Improvement Permit

Well Permit No. **D-4150**Zoning Wake

Township

Barton's Creek

Operation Permit [ ]

Owner/Contractor: Wright Bld.Date: 11-21-96Location/Address: (1604 Great Woods Rd) 98 W, (R) Lakefall, (R) Great Woods,  
1st in LDSS.R. # 98WSubdivision Name: LakefallLot No. 10


Section or Block No. \_\_\_\_\_

## Preliminary Layout

SEE ATTACHED PLOT PLAN FOR WASTEWATER  
DISPOSAL SITE.

SEE CONSTRUCTION AUTHORIZATION FOR  
WASTEWATER SYSTEM DESIGN.

## Final Layout

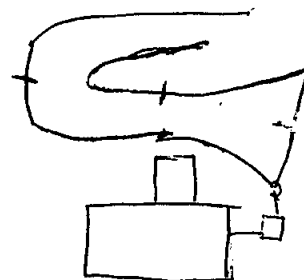

check ~~the~~ inside line: 1) step down,  
2) last 60'  
5-9-97  
DRP

## Sewage System Specifications

Repair [ ] Original Permit No. \_\_\_\_\_

Garbage Disposal Unit Yes [ ] No ☒House ☒ Mobile Home [ ] Business [ ]No. of Bedrooms 4 Lot Area 40,000 ft<sup>2</sup> +Size of Tank 1200 gal.Wastewater: Sewage ☒ Industrial [ ] Comments: \_\_\_\_\_Nitrification Line 1200 (3' x 200') sq. ft.Depth of Stone: 12" ☒ Max Depth of Trenches: 24 in.Riser and Baffle Required ☒ Pump Required [ ]

Permit void if not in compliance with zoning regulations

Permits may be voided if site is altered or intended use changed

Layout by: Terry D. Chappell R.S.Date: 5/9/97 Installed By: David Brantley Approved By: DR Parrell

**Well System**  
Individual [ ] Semi-Public [ ] Public ☒  
New [ ] Replacement [ ] Repair [ ]  
Fee Paid: Yes [ ] No [ ]  
**Construction Compliance**  
Site Approved Yes [ ] No [ ]  
Well Head Approved [ ] [ ]  
Grouting Approved [ ] [ ]

Date Inspected \_\_\_\_\_

Sanitarian \_\_\_\_\_

## Bacteriological Results

Initial Sample: \_\_\_\_\_ Date: \_\_\_\_\_

\* Re-Sample #1 \_\_\_\_\_ Date: \_\_\_\_\_

\* Re-Sample #2 \_\_\_\_\_ Date: \_\_\_\_\_

\* Re-chlorination as required [ ] Yes [ ] No

\* Fees for all resamples

All checks payable to: **Wake County Health Department**

## Final Inspection

Required Slab [ ] [ ]

Chlorinated [ ] [ ]

Required Certificate [ ] [ ]

Variance (Explain) [ ] [ ]

WCHD I.D. Affixed [ ] [ ]

Sample Collected [ ] [ ]

Comments: \_\_\_\_\_

\_\_\_\_\_

\_\_\_\_\_

Well Installed By: \_\_\_\_\_

Date System Finalized \_\_\_\_\_

Sanitarian \_\_\_\_\_

This report is based in part on information provided by the homeowner or his/her representative in the application submitted for this permit. The sanitarian is not responsible for false or misleading information contained in the application. The sanitarian is also not responsible for concealed conditions on the property or for statements in this report that may have resulted from false or misleading statements provided to him in the application. Neither Wake County nor the sanitarian warrants that the septic tank system will continue to function satisfactorily in the future or that the water supply will remain potable.

COPY TO HEALTH DEPARTMENT

30.203-10/15/96

Tax Map No.

Parcel No.

PIN # 0881.0295-6763

**AUTHORIZATION FOR WASTEWATER SYSTEM CONSTRUCTION**  
**VOID SIXTY(60) MONTHS FROM DATE OF ISSUANCE**

|                                                        |                   |                                      |  |
|--------------------------------------------------------|-------------------|--------------------------------------|--|
| DATE: <u>11-21-96</u>                                  |                   | IMPROVEMENT PERMIT NO.: <u>D4150</u> |  |
| TAX MAP NO.: _____                                     | PARCEL NO.: _____ | PIN NO.: <u>0881,02956763</u>        |  |
| OWNER/CONTRACTOR: <u>Wright Bld.</u>                   |                   |                                      |  |
| LOCATION/ADDRESS: <u>(1004 Greentree Dr.)</u>          |                   |                                      |  |
| SUBDIVISION NAME: <u>Lakefall</u>                      |                   |                                      |  |
| LOT NO.: <u>10</u>                                     |                   | SECTION OR BLOCK NO.: _____          |  |
| AUTHORIZATION ISSUED BY: <u>Terry D. Chappell R.S.</u> |                   |                                      |  |

PIN #:

**AUTHORIZATION CONDITIONS**

- 1     WASTEWATER SYSTEM CONSTRUCTION AND INSTALLATION MUST MEET ALL CONDITIONS AND SPECIFICATIONS AS SET FORTH IN IMPROVEMENT PERMIT NO. D4150 AND THE ATTACHED SITE PLAN WITH SYSTEM DETAILS. CONSTRUCTION AND INSTALLATION MUST ALSO MEET ALL REQUIREMENTS SET FORTH IN THE "REGULATIONS GOVERNING SANITARY SEWAGE COLLECTION, TREATMENT, AND DISPOSAL IN WAKE COUNTY" AND ANY OTHER APPLICABLE RULES AND LAWS.
  
- 2     THE WASTEWATER SYSTEM SHALL NOT BE COVERED OR PLACED INTO USE UNTIL INSPECTED BY THE WAKE COUNTY DEPARTMENT OF HEALTH AND AN OPERATION PERMIT ISSUED.
  
- 3     ANY ALTERATION IN SITE OR SOIL CONDITIONS (INCLUDING LOCATION OF STRUCTURES AND APPURTENANCES) OR MODIFICATION IN USE, DESIGN WASTEWATER FLOW, OR WASTEWATER CHARACTERISTICS AS SPECIFIED IN THE ASSOCIATED IMPROVEMENT PERMIT AND APPLICATION, MAY VOID THIS AUTHORIZATION AND ASSOCIATED PERMITS.
  
- 4     OTHER CONDITIONS: Use conventional trench 3' wide, 2 trenches 300' long, use 1200 gal septic tank, max depth of trenches 24"

SCALE 1" = 40'

2000 R4Cw By TL 1  
 Approve ✓ Date 10/23/96  
 Revise \_\_\_\_\_ Use 101  
 Reject \_\_\_\_\_ MBL 110  
 Front 36 Rear 30  
 Side 15 Corner \_\_\_\_\_  
 Comments: 25


1604 A=30.55'  
R=50'

GREAT WOODS ROAD

I certify that the location of planned or existing structures are accurately shown. I understand there is no easement structure in accordance with this Act. I also may require the relocation of structures regardless degree of completion. I hereby grant permission to Municipal/County representatives the right of entry to make evaluations or inspections upon this property.

*W. H. Smith*

Signature of Owner or Authorized Agent

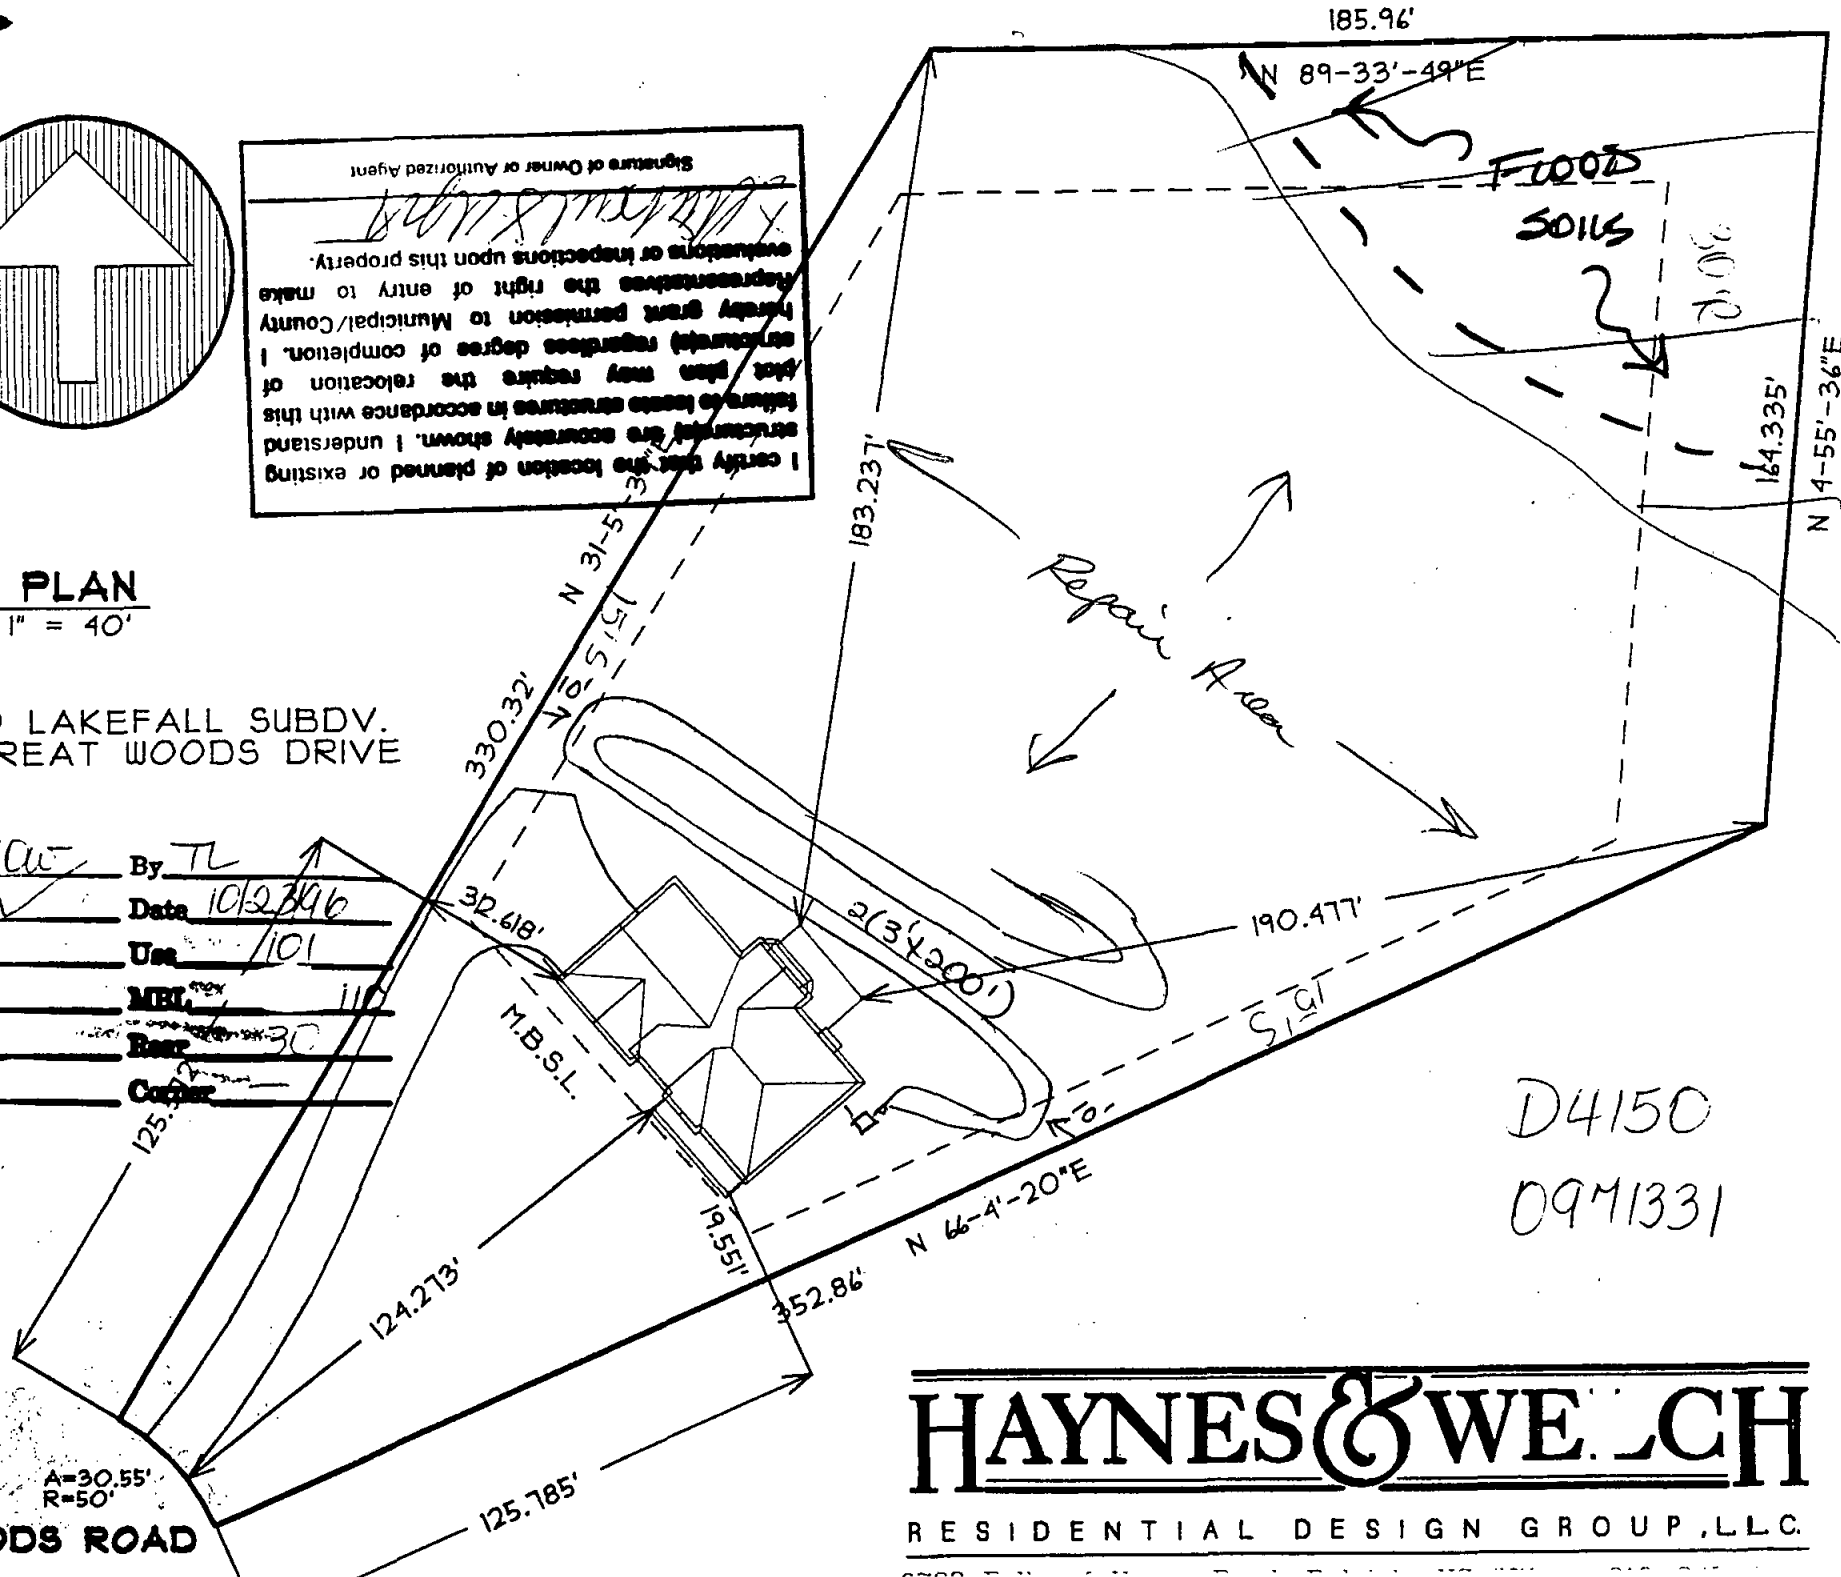

D4150  
0971331

# HAYNES & WELCH

RESIDENTIAL DESIGN GROUP, LLC.