

WAKE COUNTY DEPARTMENT OF ENVIRONMENTAL SERVICES WELL AND SEWAGE SITE LOCATION PERMIT

NO PERMIT(S) FOR CONSTRUCTION, LOCATION OR RELOCATION ACTIVITY SHALL BE ISSUED
UNTIL AN AUTHORIZATION FOR WASTEWATER SYSTEM CONSTRUCTION HAS BEEN ISSUED

PERMIT VOID IF NOT IN COMPLIANCE WITH ZONING REGULATIONS AND/ OR IF SITE IS ALTERED OR INTENDED USE CHANGED

PERMIT#: D058804 STATUS: A APP. DATE: 11/29/2017 BLDG. PERMIT#: 0181783
PIN: 1718 09 2178 000 TAX MAP: 0 RECORDED: Y ORIG. PERMIT#:
TOWNSHIP: 02 BARTON'S CREEK JURISDICTION: WC ZONING: R80W SW DEVICE: N S#:
APPLICANT: HOMESTEAD BUILDING COMPANY (919) 556 - 8472
PO BOX 848 WAKE FOREST, NC 27588
HD USE: 101A CONVENTIONAL ONE-FAMILY HOUSE EXIST USE: DESIGN FEE REQ?: PAID?:
LTAR: 0.30 0.30 BEDROOMS: 4 BASEMENT: N #EMPLOYEES: 0 FOUNDATION DRAIN: N
SITE: ADDRESS: 5109 AVALAIRE OAKS DR
SUBDIVISION: AVALAIRE LOT: 37 ACRES: 1.10 EASEMENT: N LOC: SYS:
DIRECTION: US1 TO DURANT TO AVALAIRE OAKS

IMPROVEMENT PERMIT

[] As per GS 130A-335 (f), Improvement Permit is based on a Site Plan and is void Sixty (60) months from date of issuance.

[X] As per GS 130A-335 (f), Improvement Permit is based on a Plat and is valid without expiration.

Permit is subject to revocation if the site plan or plat,
whichever is applicable, or the intended use changes.

*Maximum depth of line is calculated using the downhill
*side of the trench and includes slope correction.

TANK SIZE: 1200 gal. PUMP Tank: _____ gal. GREASE TRAP: _____ gal. SQ FT: 1200 ACCEPTED STATUS MAX DEPTH LINE: 22 in.
WASTEWATER: INDIVIDUAL SEWAGE: DOMESTIC TYPE SYSTEM: II A PUMP: N P/M: N
DAILY FLOW: 480 gal/day WATER: COMMUNITY PRETREATMENT: NA

COMMENTS: IP BASED ON CONSULTANTS DESIGN FOR A 4 BEDROOM 480GPD GRAVITY ACCEPTED STATUS SYSTEM WITH 0.3LTAR
AND A 22 INCH TRENCH DEPTH. REFER TO CA COMMENTS.

IP ISSUED? Y DATE: 01/16/2018 BY: (JNG) *[Signature]* PHONE#: (919)-397-8670

AUTHORIZATION FOR WASTEWATER/WATER SYSTEM CONSTRUCTION
VALIDITY CONCURRENT WITH THE IMPROVEMENT PERMIT

AUTHORIZATION CONDITIONS:

Contractors shall install system on contours, see attached site plan for wastewater system design and well location. No underground utilities, water lines or sprinkler systems may be located in the original system or repair areas. A septic tank filter with a riser for access is required. The wastewater system shall not be covered or placed into use until inspected by the Wake County Department of Environmental Services and an Operation Permit issued. An Accepted Status System may be used in place of conventional system, if it can be placed in the permitted/authorized trench footprint (except reduction in line length and/or number as allowed for in approval) and the installation is in accordance with the accepted system approval, without unauthorized product alteration. If permit required use of an Accepted Status System, substitution with another accepted status system may be made, as long as no changes are necessary in the location of each nitrification line (including any increase in line length), trench depth or effluent distribution method. If changes are necessary, prior approval by this office is required before system installation. Maximum depth of line is calculated using the downhill side of the trench and includes slope correction.

OTHER CONDITIONS: REFER TO CONSULTANTS DESIGN PLAN FOR INSTALLATION. INITIAL SYSTEM IS EQUAL LENGTH LINES OF 3-100 FOOT EACH / 2-50 FOOT EACH WITH A FLOW DIVIDER - ACCEPTED STATUS. REPAIR SYSTEM IS A SUBSURFACE DRIP SYSTEM. THE SYSTEM IS DESIGNED BY CONSULTANT AND MUST BE INSTALLED PER DESIGN. INSTALL ON CONTOUR AND MAINTAIN ALL SETBACKS. IF FLAGS ARE MISSING, CALL DESIGNER/CONSULTANT TO REFLAG. ANY CHANGE OR VARIATION FROM DESIGN MUST BE APPROVED BY THE DESIGNER AND THE WAKE COUNTY ENVIRONMENTAL SERVICES PRIOR TO SYSTEM INSTALLATION. DO NOT REMOVE SOIL IN THE INITIAL OR REPAIR AREA. CALL WITH QUESTIONS PRIOR TO OR DURING INSTALLATION IF NEEDED.

TANK SIZE: 1200 gal. PUMP TANK: _____ gal. GREASE TRAP: _____ gal. SQ FT: 1200 ACCEPTED STATUS MAX DEPTH LINE: 22 in.
MAINT: N OPER: N L/O: Y TRENCH#: 5 LENGTH: 400 ft. WIDTH: 36 in. DESIGNER: _____
SUBFIELDS: _____ DESIGN HEAD PRESSURE: _____ DESIGN FLOW: _____ gal/min DOSE VOLUME: _____ gal. PRETREATMENT: NA

CA ISSUED? Y DATE: 01/26/2018 BY: (JNG) *[Signature]* PHONE#: (919)-397-8670 2/19/18 SCA

CA contains Ports A, B

WAKE COUNTY DEPARTMENT OF ENVIRONMENTAL SERVICES WELL AND SEWAGE SITE LOCATION PERMIT
NO PERMIT(S) FOR CONSTRUCTION, LOCATION OR RELOCATION ACTIVITY SHALL BE ISSUED
UNTIL AN AUTHORIZATION FOR WASTEWATER SYSTEM CONSTRUCTION HAS BEEN ISSUED

PERMIT VOID IF NOT IN COMPLIANCE WITH ZONING REGULATIONS AND/ OR IF SITE IS ALTERED OR INTENDED USE CHANGED

PERMIT#: D058804 STATUS: A APP. DATE: 11/29/2017 BLDG. PERMIT#: 0181783
PIN: 1718 09 2178 000 TAX MAP: 0 RECORDED: Y ORIG. PERMIT#:
TOWNSHIP: 02 BARTON'S CREEK JURISDICTION: WC ZONING: R80W SW DEVICE: N S#:
APPLICANT: HOMESTEAD BUILDING COMPANY (919) 556 - 8472
PO BOX 848 WAKE FOREST, NC 27588
USE: HD USE: 101A CONVENTIONAL ONE-FAMILY HOUSE EXIST USE:
LTAR: 0.30 0.30 BEDROOMS: 4 BASEMENT: N #EMPLOYEES: 0
SITE: ADDRESS: 5109 AVALAIRE OAKS DR
SUBDIVISION: AVALAIRE LOT: 37 ACRES: 1.10 EASEMENT: N LOC: SYS:
DIRECTION: US1 TO DURANT TO AVALAIRE OAKS

Well System: WATER: COMMUNITY TYPE:

WELL LOG INFORMATION: DEPTH: CASING DEPTH: YIELD: STATIC LEVEL:
WELL CONTRACTOR: REG.# PUMP CONTRACTOR: REG.#
Construction Compliance GROUT APPROVED ☐ DATE EHS
WELLHEAD APPROVED ☐ DATE EHS
SYSTEM FINALIZED ☐ DATE EHS

COMMENTS: COMMUNITY

Operation Permit

DESIGN FLOW: gal./min. ACTUAL FLOW: DOSE VOLUME: gal. INNOVATIVE LETTER:

INSTALLED BY: INSTALLATION APPROVED BY:
PROPRIETARY SYSTEM: TYPE SYSTEM: II A

COMMENTS:

OPERATIONS PERMIT ISSUED? OP DATE: BY:


Systems defined as either a Type IIIb, IIIg with a pump, IV, V or VI, in accordance with the North Carolina Administrative Code 15A NCAC 18A .1961, Table V as adopted by reference in the "Regulations Governing Wastewater Treatment and Dispersal Systems in Wake County", require Wake County Environmental Services to conduct periodic inspections on this type system, pursuant to 15A NCAC 18A .1961 (j). Fees for these inspections will be charged as per the approved Fee Schedule. In addition, all systems are to be operated and maintained as specified in 15A NCAC 18A .1961. This permit is based in part on information provided by the homeowner or his/her representative in the application submitted for this permit. The Environmental Health Specialist is not responsible for false or misleading information contained in the application. The Environmental Health Specialist is also not responsible for concealed conditions on the property or for statements in this report that may have resulted from false or misleading statements provided to him in the application. Neither Wake County nor the Environmental Health Specialist warrants that the septic tank system will continue to function satisfactorily in the future or that the water supply will remain potable.

As Built Information:

Date: Benchmark: Rod reading: Distance to Structure:
ST: gals ID#: D.O.M.: Elev.: Distance to Well:
PT: gals ID#: D.O.M.: Elev.: Distance to P/L:
GT: gals ID#: D.O.M.: Elev.: Pretreatment:
D-box/FD/PM elev.: Supply Line: ft. Pump/Ctrl Panel: Filter:
Line 1: Date: Line 6: Date:
Line 2: Date: Line 7: Date:
Line 3: Date: Line 8: Date:
Line 4: Date: Line 9: Date:
Line 5: Date: Line 10: Date:
ETM1: CC1: ETM2: CC2: OR: AC: WM:
Notes:

Part A / Refer to Part B

PROPERTY IS _____ IS NOT _____ LOCATED IN A SPECIAL FLOOD HAZARD AREA AS DESIGNATED ON FEDERAL EMERGENCY MANAGEMENT AGENCY (F.E.M.A.) FLOOD INSURANCE RATE MAP NUMBER _____ ZONE _____

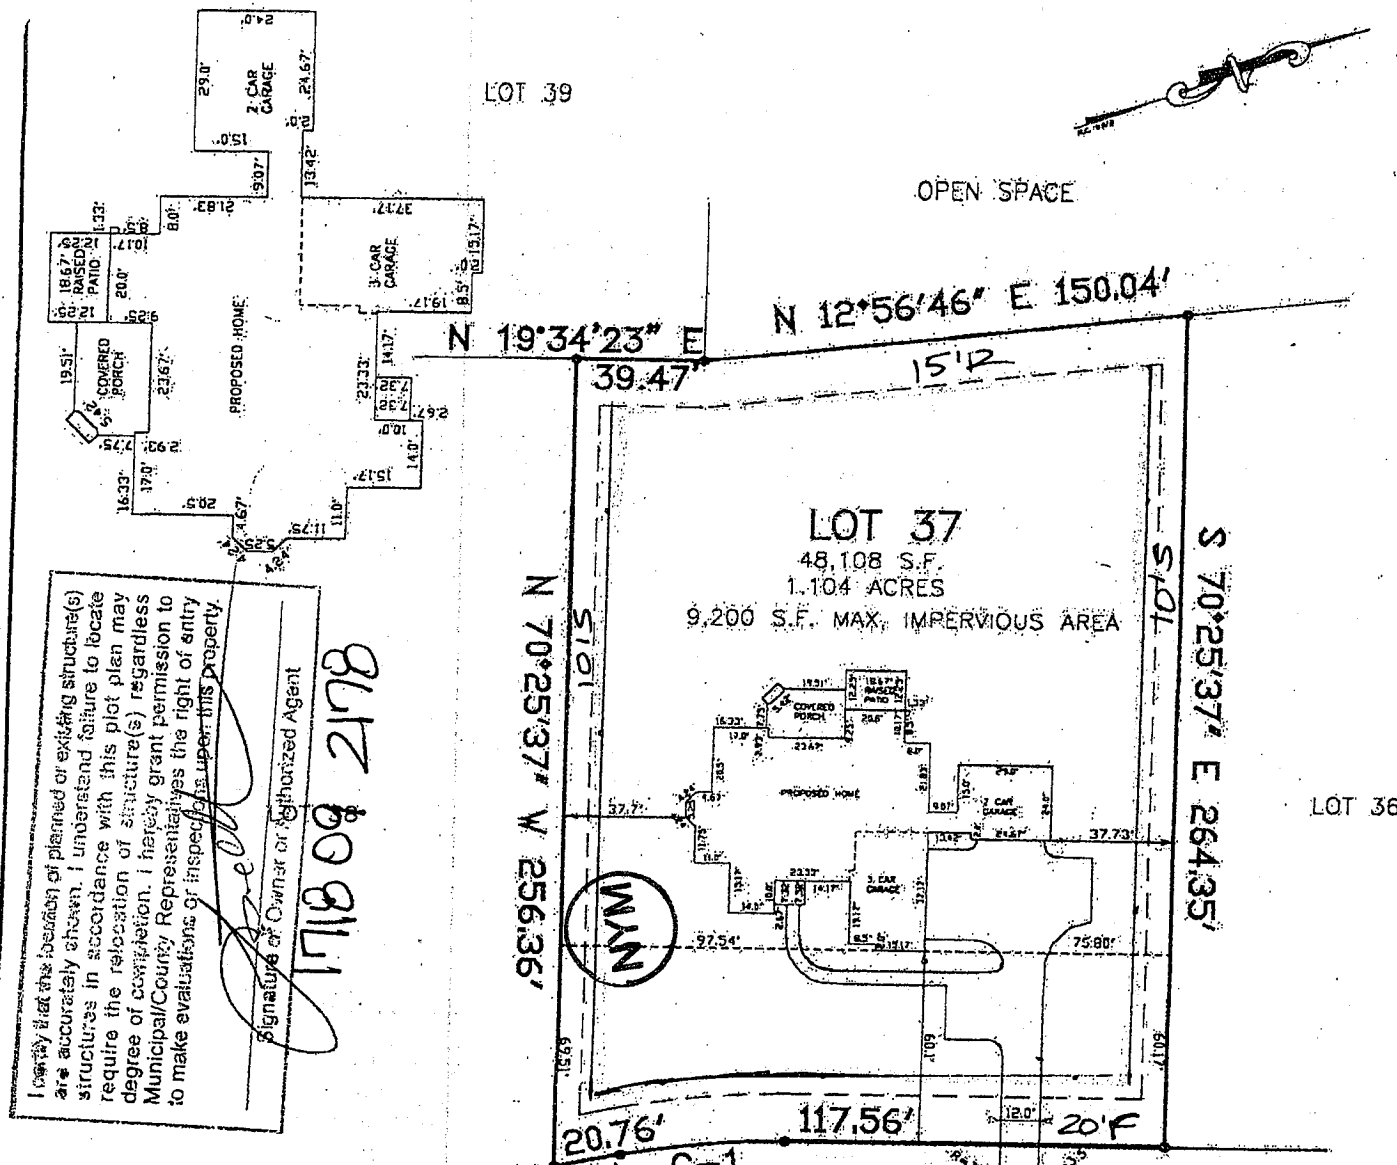

C-1
L=50.95'
R=255.0'
S 13°50'55" W 50.87'

PROPOSED IMPERVIOUS AREAS
HOME 5,438 S.F.
MIS 50 S.F.
WALK & DR 2,901 S.F.
TOTAL 8,389 S.F.
MISA 92007
AVALAIRE SUBDIVISION

Zoning R8W by DA
Approved ✓ Date 11.29.17
Revised ✓ Use IOA
Reject ✓ MBL 10
Front 20 Rear 15
Side 10 Corner 15
Comments: set checker

S 08°07'27" W C-1 51.09 S 19°34'23" W
AVALAIRE OAKS DR
50' PUBLIC R/W

ZONING R-40W
CLUSTER SUBDIVISION
SETBACKS
FRONT 15'
SIDE 7.5'
REAR 15'

0181783
D058804

R8W

PRELIMINARY PLAT, NOT FOR RECORDATION, CONVEYANCE OR SALE

BUILDER TO VERIFY HOUSE DIMENSIONS

PHASE ONE REVISED 10/21/17
LOT 37 MOVED HOME BACK TO 60' BLOCK _____


RECORDED IN BOOK OF MAPS 2016, PAGE 1989 WAKE COUNTY, N. C.

I, JOHN Y. PHELPS, JR. HEREBY CERTIFY THAT THIS MAP IS CORRECT AND THAT THE BUILDINGS ARE WHOLLY ON THE LOT AND THAT THERE ARE NO ENCROACHMENTS OF OTHER BUILDINGS ON SAID LOT UNLESS SHOWN OTHERWISE. THIS MAP IS NOT FOR RECORDING.

PLOT PLAN
HOMESTEAD BUILDING CO.
51.09 AVALAIRE OAKS DR
BARTON'S CREEK TOWNSHIP, WAKE CO., N.C.

SCALE 1"=60'
DATE 10/01/17
AS-37


JOHN Y. PHELPS, JR.
PROFESSIONAL LAND SURVEYOR
5110 BUR OAK CIRCLE
RALEIGH, NORTH CAROLINA, 27612 (919) 787-3658

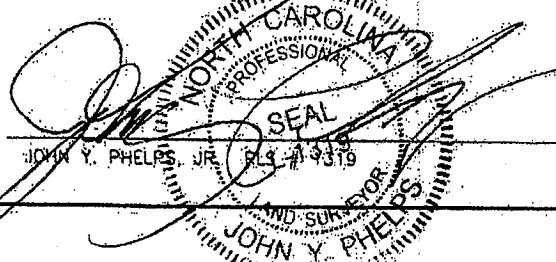

15. Part D

1250 ST
 DBOX
 300 Line @
 36" x 100'
 200 Line @
 36" x 50'
 (Flow divide)
 - ACCEPTED STATUS
 Repair:
 Subsurface
 Drip System

System: ++++++
 Repair: ————

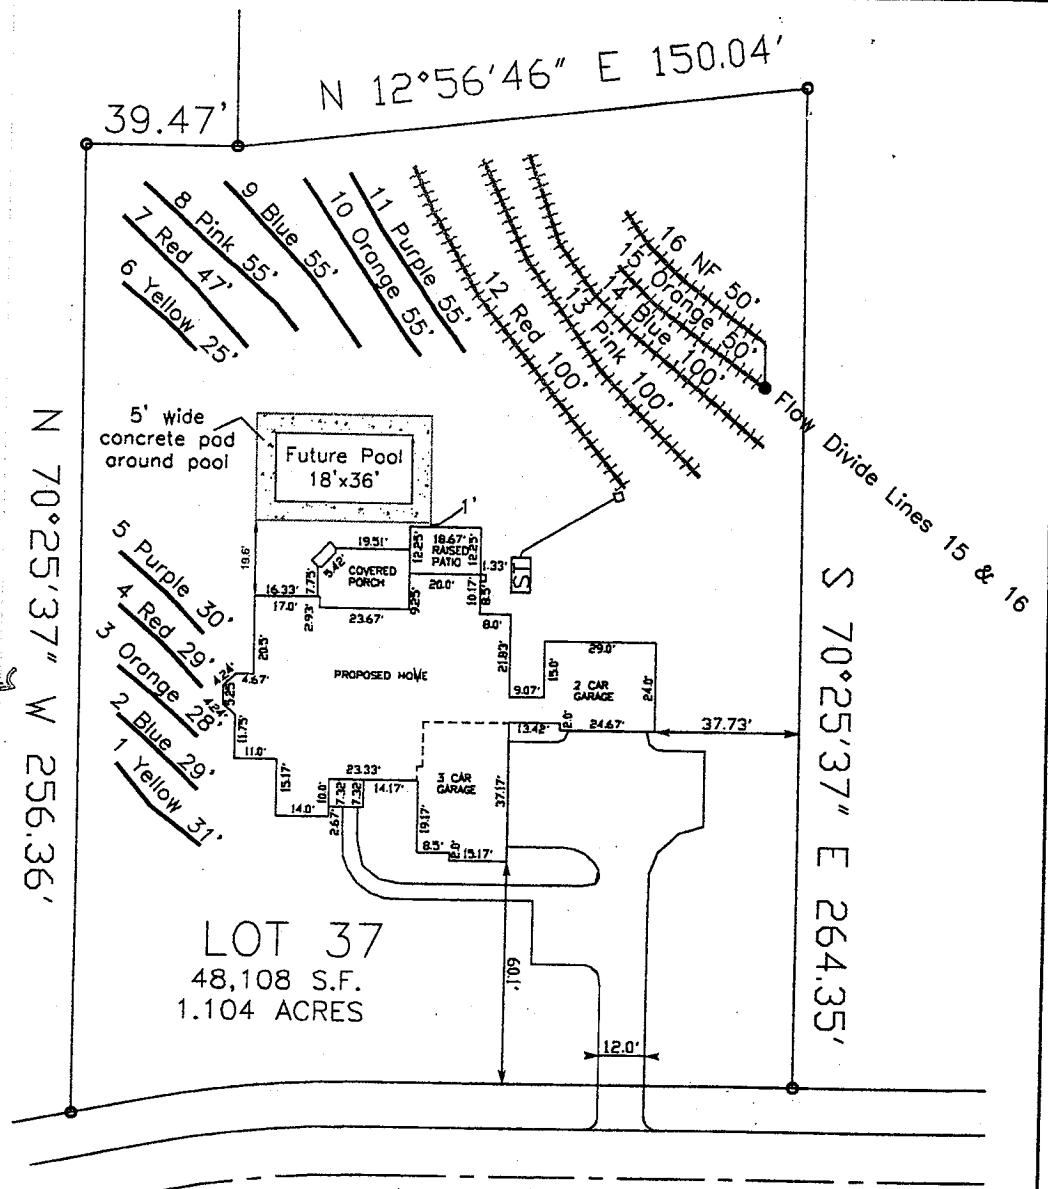


AVALAIRE OAKS DR
 50' PUBLIC R/W

- *Keep Tanks and Drain lines 10' from property lines.
- *Not a Survey
- *Not a guarantee of a septic permit.
- *Keep supply lines >5' from property lines.
- *Some lines are flagged longer in the field than lengths indicated above.
- *No cutting within septic area.
- *No foundation drains.

System: Gravity to D-Box
 Lines: 12-16, (400')
 Accepted Status System
 0.3 Soil LTAR
 24" Trench Bottom

Repair: Subsurface Drip
 Lines: 1-11, (>1,600')
 Subsurface Drip System
 0.15 Soil LTAR
 24" Trench Bottom

GRAPHIC SCALE
 1" = 50'

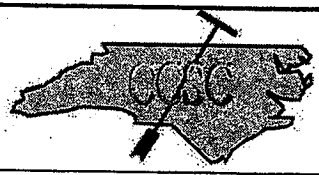

Central Carolina Soil Consulting, PLLC
 1900 South Main Street, Suite 110
 Wake Forest, North Carolina 27587
 Phone (919)569-6704 Fax (919)569-6703

4-Bedroom Septic Layout
 Lot 37, Avalaire Subdivision
 Wake County, North Carolina

Job# : 2154
Drawn By : JR
Date : 12/14/2017
Revision:

0181783

WAKE COUNTY COMMUNITY SERVICES
INSPECTIONS/DEVELOPMENT PLANS/PERMITS
WAKE COUNTY OFFICE BUILDING
RALEIGH, NORTH CAROLI
PHONE (919) 856-6222 FAX (919) 856-6229

PERMIT#: 0181783 STATUS: A APP DATE: 02/14/2018 FINALIZED: BY:
 APPL: HOMESTEAD BUILDING COMPANY TYP: G LIC#: 0 54542 ELEC TICKT#: P/E
 PRMT TYP: LND Y BLDG Y FIR WTRQ SWST DEED RF: 16667 0050 17 FARM EXMPT:
 TWP: 02 BARTON'S CREEK MAP-PARCEL: 0 PIN#: 1718 09 2178 000
 CITY: ZONING DIST: R80W OWNER: HOMESTEAD BUILDING COMPAN
 SUBD FILE#: PHASE: SUB NAME: AVALAIRE LOT-SEC: 37
 SUBD IMPROVEMENT#: 14 PLAT REF: 2016 1989 ACRES: 1.10
 CENSUS TR: 538 08 TOPFLR: U FIRPLC: P TEMP POLE: Y IMPROV VAL: 700000
 USE CODE: 101 A CONVENTIONAL ONE-FAMILY HOUSE SQ-FT: 7586 STORY: 2 STORY
 EXIST USE: ORIG PERMIT#:
 RECPT: FEE: 1703.00 RECOVERY FUND: Y FEE EXEMPT: ROOMS: 04 BDRMS: 04
 HEALTH#: D058804 WATER: C COMM SEWER: I PRIV PUMP: N OP: BY:
 BSMT: N GARB DISPOSAL: N # OF EMPLOYEES: FOOD HANDLING:
 MAKE/MODEL SERIAL# UL/HUD# YR SIZE COLOR
 MB/HOME DATA: X
 BD/ADJ REQUIRED: DATE: CASE#: ACTION:
 LOCATION: 5109 AVALAIRE OAKS DR
 COMMENT: US1 TO DURANT TO AVALAIRE OAKS (2ST SFD 4BR 5.5B
 A 2GAR F/R/POR 2PFAB FROP UNFROG UNFIN STOR)

CONTRACTOR TYPE	NAME	LIC#
BUILDING	HOMESTEAD BUILDING COMPANY	054542
ELECTRICAL	ROMANOFF	U12915
MECHANICAL	CASEY SERVICES	H10540
PLUMBING	EVANS PLUMBING	P07035

LOT AREA _____ SQ. FT. FRONT YARD DEPTH **20** FT. CORNER YARD DEPTH _____ FT.

LOT WIDTH _____ SQ. FT. SIDE YARD DEPTH **10** FT. REAR YARD DEPTH **15** FT

PLANS APPROVED

DATE

MNM**02/14/18**PROCESSED BY: **NJM**

THE APPLICANT AGREES TO COMPLY WITH ALL BUILDING REGULATIONS AND OTHER LAWS APPLICABLE TO THE USE OF THE STRUCTURE AND FACILITIES REFERRED TO HEREIN. THE PERMIT ISSUED FOR WORK SHALL EXPIRE BY LIMITATION SIX MONTHS AFTER THE DATE OF ISSUANCE IF THE WORK AUTHORIZED HAS NOT BEEN COMMENCED. IF AFTER COMMENCEMENT THE WORK IS DISCONTINUED FOR A PERIOD OF 12 MONTHS, THE PERMIT THEREFORE SHALL IMMEDIATELY EXPIRE. NO WORK AUTHOURIZED BY ANY PERMIT THAT HAS EXPIRED SHALL THEREFORE BE PERFORMED UNTIL A NEW PERMIT HAS BEEN SECURED.

SIGNATURE

DATE



Environmental Services

TEL 919 856 7400

Water Quality Division

335 Fayetteville St. • P.O. Box 550 • Raleigh, NC 27602

Purpose: This forms is to be completed when making changes to a pending or active Well, Septic, or Building Permit.

D# 058804 BUILDING PERMIT # 0181783 PIN # 1718092178

Change of Bedrooms from ... to ...
*Site Plan May Be Required

Change Applicant Name to ...
*Attach Owner Authorization

Change of Applicant Address to ...

Change of Applicant Phone Number to ...

Change of Building Footprint ...
* Site Plan Will Be Required

Foundation Drain ☐ Yes ☒ No
* No Site Plan Required

Change # of Employees ...
* Business, Schools, Daycares, etc.

Change of Basement: Add Basement _____ or Remove Basement _____

Comments NO Foundation on the west side / Left side
+ Northeast corner / Right side
+ North side / Rear zone garage

Project (Site) Address 5109 AVALANCE DR

Applicant Signature [Signature] Date 1-25-18

Wake County Permit Processor [Signature] Date 1-26-18

☐ Sent to Plan Review Staff

Note: Any change made where a Wake County Building Permit is involved requires that this document be forwarded through the Wake County Building Permits Department. All other revision forms can be forwarded to Environmental Services representatives on the 1st floor. Be aware revision fee may be required before processing can begin.