

Environmental Services - Water Quality
Onsite Wastewater Scan Data Entry Form

PERMIT #: 0024660

PIN #: 1801511351

OP DATE: 0410712006

SYSTEM USE:

- ☒ House
☐ Mobile Home
☐ Business
☐ Other

SEWAGE TYPE:

- ☒ Domestic
☐ Industrial

PUMP/SIPHON?:

- ☒ Yes
☐ No

PRESSURE MANIFOLD:

- ☐ Yes
☒ No

SYSTEM TYPE:

- ☐ I
☐ II
☒ III
☐ IV
☐ V
☐ VI
☐ Other

SUB TYPE:

- ☐ A
☒ B
☐ C
☐ D
☐ E
☐ F
☐ G

NBR BEDROOMS:

- ☐ 1
☐ 2
☐ 3
☐ 4
☒ 5
☐ 6
☐ Other

MAINT. SCHEDULE:

- ☐ Yes
☒ No

CERT. OPERATOR

- ☐ Yes
☒ No

GT	ST	PT	SIZE
☐	☐		750
☐	☐	☐	900
☐	☐	☐	1,000
☐	☐	☐	1,200
☐	☒	☐	1,500
☐	☐	☐	1,800
☐	☐	☐	2,100
☐	☐	☐	2,500
☐	☐	☐	3,000
☐	☐	☐	4,000
☐	☐	☐	5,000
☐	☐	☐	8,000
☐	☐	☐	10,000
☐	☐	☒	Other
☒		☐	None/NA GT or PT

DRAINFIELD SIZE(SQ. FT.)

01500

DRAIN TYPE:

- ☐ Stone
☒ EZ Flow
☐ Infiltrator
☐ Biodiffuser
☐ Cultec
☐ Drip
☐ Hancor
☐ Large Dia. Pipe
☐ Multi-Pipe
☐ Other

MAX DEPTH (IN.):

- ☐ 12 in. or less
☐ 18 in. or less
☒ 24 in. or less
☐ 26 in. or less
☐ 28 in. or less
☐ 30 in. or less
☐ 32 in. or less
☐ 36 in. or less
☐ Other

STONE DEPTH (IN.):

- ☐ 8 in. or less
☐ 12 in. or less
☐ 18 in. or less
☐ 24 in. or less
☒ Other

TRENCHES:

- ☒ Individual
☐ Bed

TRENCH WIDTH (IN.):

- ☐ 12 in. or less
☐ 18 in.
☐ 24 in.
☒ 36 in.
☐ 6 ft. or less
☐ 9 ft. or less
☐ Other

WAKE COUNTY DEPARTMENT OF ENVIRONMENTAL SERVICES WELL AND SEWAGE SITE LOCATION PERMIT
NO PERMIT(S) FOR CONSTRUCTION, LOCATION OR RELOCATION ACTIVITY SHALL BE ISSUED
UNTIL AN AUTHORIZATION FOR WASTEWATER SYSTEM CONSTRUCTION HAS BEEN ISSUED

PERMIT VOID IF NOT IN COMPLIANCE WITH ZONING REGULATIONS AND/ OR IF SITE IS ALTERED OR INTENDED USE CHANGED

PERMIT#: D024660 STATUS: A APP. DATE: 06/06/2002 BLDG. PERMIT#: 0023581
PIN: 1801.04 51 1351 000 TAX MAP: 0199 0000 RECORDED: Y ORIG. PERMIT#:
TOWNSHIP: 02 BARTON'S CREEK JURISDICTION: WC ZONING: R80W
APPLICANT: THE DREES COMPANY
7701 SIX FORKS ROAD
RALEIGH, NC 27615
(919) 844 - 9288
USE: HD USE: 101 ONE-FAMILY HOUSE
EXIST USE:
DISPOSAL: N BEDROOMS: 5 BASEMENT: N #EMPLOYEES: 0
SITE: ADDRESS: 1009 HIDDEN RIVER CT
SUBDIVISION: REMINGTON FORES LOT: 11 ACRES: 1.21
DIRECTION: SIX FORKS ROAD NORTH TO HWY 98, T/R (EAST) GO
APPROX. 1/2 MILE..SUBD ON RIGHT.

Well System: WATER: COMMUNITY - TYPE: EXISTING

WELL LOG INFORMATION: DEPTH: _____ CASING DEPTH: _____ YIELD: _____ STATIC LEVEL: _____
WELLI CONTRACTOR: _____ REG.# _____ PUMP CONTRACTOR: _____ REG.# _____
Construction Compliance GROUT APPROVED ☐ DATE _____ EHS _____
WELLHEAD APPROVED ☐ DATE _____ EHS _____
SYSTEM FINALIZED ☐ DATE _____ EHS _____

COMMENTS:

DESIGN FLOW: _____ gal./min. ACTUAL FLOW: _____ Operation Permit
INNOVATIVE LETTER: N

INSTALLED BY: QUALITY LANDSCAPE INSTALLATION APPROVED BY: John Williams
PROPRIETARY SYSTEM: E2 FLOW FILTER NO: 2462V 1801
COMMENTS:

OPERATIONS PERMIT ISSUED? ☒ OP DATE: 4-7-06 BY: Christine H. Hays

This permit is based in part on information provided by the homeowner or his/her representative in the application submitted for this permit. The Environmental Health Specialist is not responsible for false or misleading information contained in the application. The Environmental Health Specialist is also not responsible for concealed conditions on the property or for statements in this report that may have resulted from false or misleading statements provided to him in the application. Neither Wake County nor the Environmental Health Specialist warrants that the septic tank system will continue to function satisfactorily in the future or that the water supply will remain potable.

STB 856 1500 GAL - EL 6-3 1/2
DOM 9-26-05

PT 220 1600 GAL - EL 6-7 1/2
DOM 9-26-05
D-BOX - EL - 5-1 1/2
LINE 1 - 6-7 1/2 - 105' E2 FLOW
LINE 2 - 7-2 1/2 - 165' E2 FLOW
LINE 3 - 8-1 - 170' E2 FLOW

NOTE: (LASER MOVED FOR TANK ELEVATIONS)

INSTALLED E2 FLOW W/ REDUCTIONS.

WAKE COUNTY DEPARTMENT OF ENVIRONMENTAL SERVICES WELL AND SEWAGE SITE LOCATION PERMIT

NO PERMIT(S) FOR CONSTRUCTION, LOCATION OR RELOCATION ACTIVITY SHALL BE ISSUED

UNTIL AN AUTHORIZATION FOR WASTEWATER SYSTEM CONSTRUCTION HAS BEEN ISSUED

PERMIT VOID IF NOT IN COMPLIANCE WITH ZONING REGULATIONS AND/ OR IF SITE IS ALTERED OR INTENDED USE CHANGED

PERMIT#: D024660 STATUS: A APP. DATE: 06/06/2002 BLDG. PERMIT#: 0023581
PIN: 1801.04 51 1351 000 TAX MAP: 0199 0000 RECORDED: Y ORIG. PERMIT#:
TOWNSHIP: 02 BARTON'S CREEK JURISDICTION: WC ZONING: R80W
APPLICANT: THE DREES COMPANY
7701 SIX FORKS ROAD
RALEIGH, NC 27615
(919) 844 - 9288
USE: HD USE: 101 ONE-FAMILY HOUSE
EXIST USE:
DISPOSAL: N BEDROOMS: 5 BASEMENT: N #EMPLOYEES: 0 FOUND DRAIN:
SITE: ADDRESS: 1009 HIDDEN RIVER CT
SUBDIVISION: REMINGTON FORES LOT: 11 ACRES: 1.21
DIRECTION: SIX FORKS ROAD NORTH TO HWY 98, T/R (EAST) GO
APPROX. 1/2 MILE..SUBD ON RIGHT.

IMPROVEMENT PERMIT

TANK SIZE: 1500 gal. PUMP Tank: 1500 gal. SQ FT: 1980 STONE DEPTH: 12 in. MAX DEPTH LINE: 24 in.
WASTEWATER: INDIVIDUAL SEWAGE: DOMESTIC TYPE SYSTEM: III B PUMP: Y P/M: N
DAILY FLOW: 600 gal/day DESIGN FEE REQ?: PAID?: WATER: COMMUNITY

COMMENTS:

IP ISSUED? Y DATE: 06/26/2002 BY: (CPH) Charles Humphrey PHONE#: 856-5842

AUTHORIZATION FOR WASTEWATER/WATER SYSTEM CONSTRUCTION

VOID SIXTY (60) MONTHS FROM DATE OF ISSUANCE

AUTHORIZATION CONDITIONS:

Contractors shall install system on contours, see attached site plan for wastewater system design and well location. No underground utilities, water lines or sprinkler systems may be located in the original system or repair areas. A septic tank filter with a riser for access is required. The wastewater system shall not be covered or placed into use until inspected by the Wake County Department of Environmental Services and an Operation Permit issued. **OTHER CONDITIONS:**

TANK SIZE: 1500 gal. PUMP TANK: 1500 gal. SQ FT: 1980 STONE DEPTH: 12 in. MAX DEPTH LINE: 24 in.
MAINT: N OPER: N I/O: Y TRENCH#: 4 LENGTH: 165 ft. WIDTH: 36 in. DESIGNER: _____
SUBFIELDS: _____ DESIGN HEAD PRESSURE: _____ DESIGN FLOW: _____ gal/min DOSE VOLUME: _____ gal.

CA ISSUED? Y DATE: 06/26/2002 BY: (CPH) Charles Humphrey PHONE#: 856-5842

PROPERTY OF DREES HOMES INC.

LOT 11 REMINGTON FOREST SUB

1009 HIDDEN RIVER COURT

SCALE: 1"=60

REFERENCES: BM 2002, PAGE

BARTONS SREEK

WAKE COUNTY

NORTH CAROLINA

6/03/02


AS-Built

LEGEND

- EIP - EXISTING IRON PIPE
- IPS - IRON PIPE SET
- NPS - NO POINT SET
- CONCRETE MONUMENT
- WATER VALVE
- SEWER MANHOLE
- POWER POLE
- ADJOINING LOT LINES


MAVIS D. DEW
W.B. 99E-2413
D.B. 4057, PG. 37

NAD83
GRID NORTH

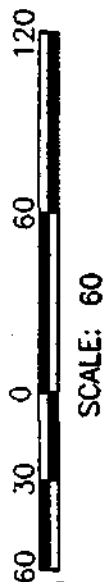

12

10

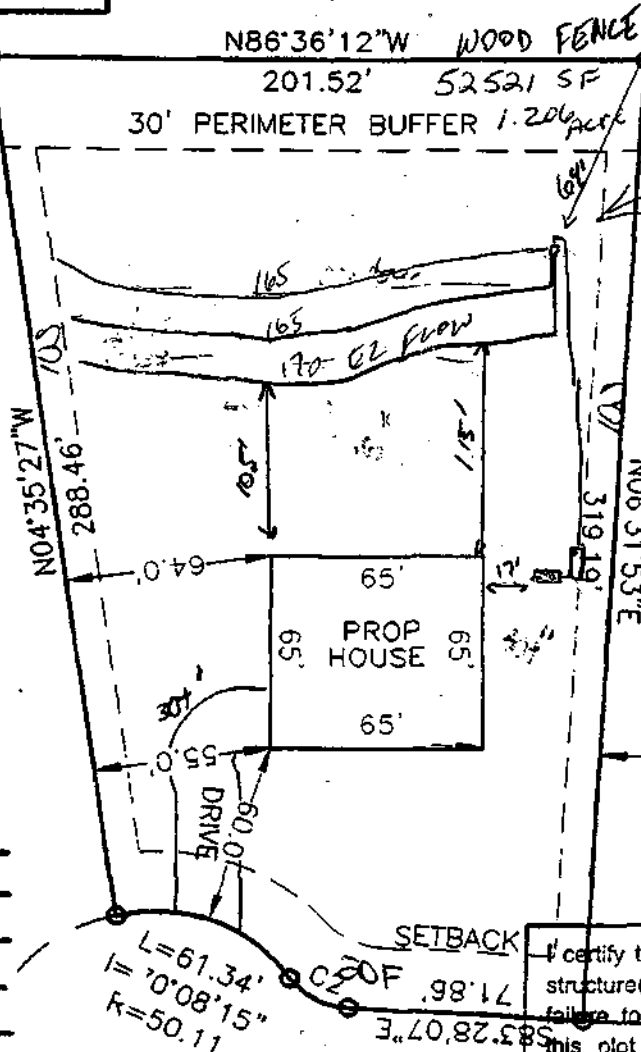

Max. Allowable
Impermeable area
10,508 SF

0023581
D24600

Zoning BOW By JUL
 Approve ✓ Date 6/5/02
 Revise Use 101
 Reject MBL
 Front 20 Rear 30
 Side 10 Corner 20

Comments: Cluster Sub.
Setbacks per Plat.

HIDDEN RIVER COURT
(45' PUBLIC R/W)

I certify that the location of planned or existing structure(s) are accurately shown. I understand failure to locate structures in accordance with this plot plan may require the relocation of structure(s) regardless degree of completion. I hereby grant permission to Municipal/County Representatives the right of entry to make evaluations or inspections upon this property.

Signature of Owner or Authorized Agent

PRELIMINARY PLAN FOR BUILDING PERMIT APPLICATION ONLY
NOT FOR SALES OR CONVEYANCES

PROPERTY OF DREES HOMES INC.

LOT 11 REMINGTON FOREST SUB

1009 HIDDEN RIVER COURT

SCALE: 1"=60

REFERENCES: BM 2002, PAGE

BARTONS SREEK

WAKE COUNTY

NORTH CAROLINA


6/03/02

LEGEND

- EIP - EXISTING IRON PIPE
- IPS - IRON PIPE SET
- NPS - NO POINT SET
- C - CONCRETE MONUMENT
- X - WATER VALVE
- S - SEWER MANHOLE
- P - POWER POLE
- ADJOINING LOT LINES

MAVIS D. DEW
W.B. 99E-2413
D.B. 4057, PG. 37

NAD83
GRID NORTH

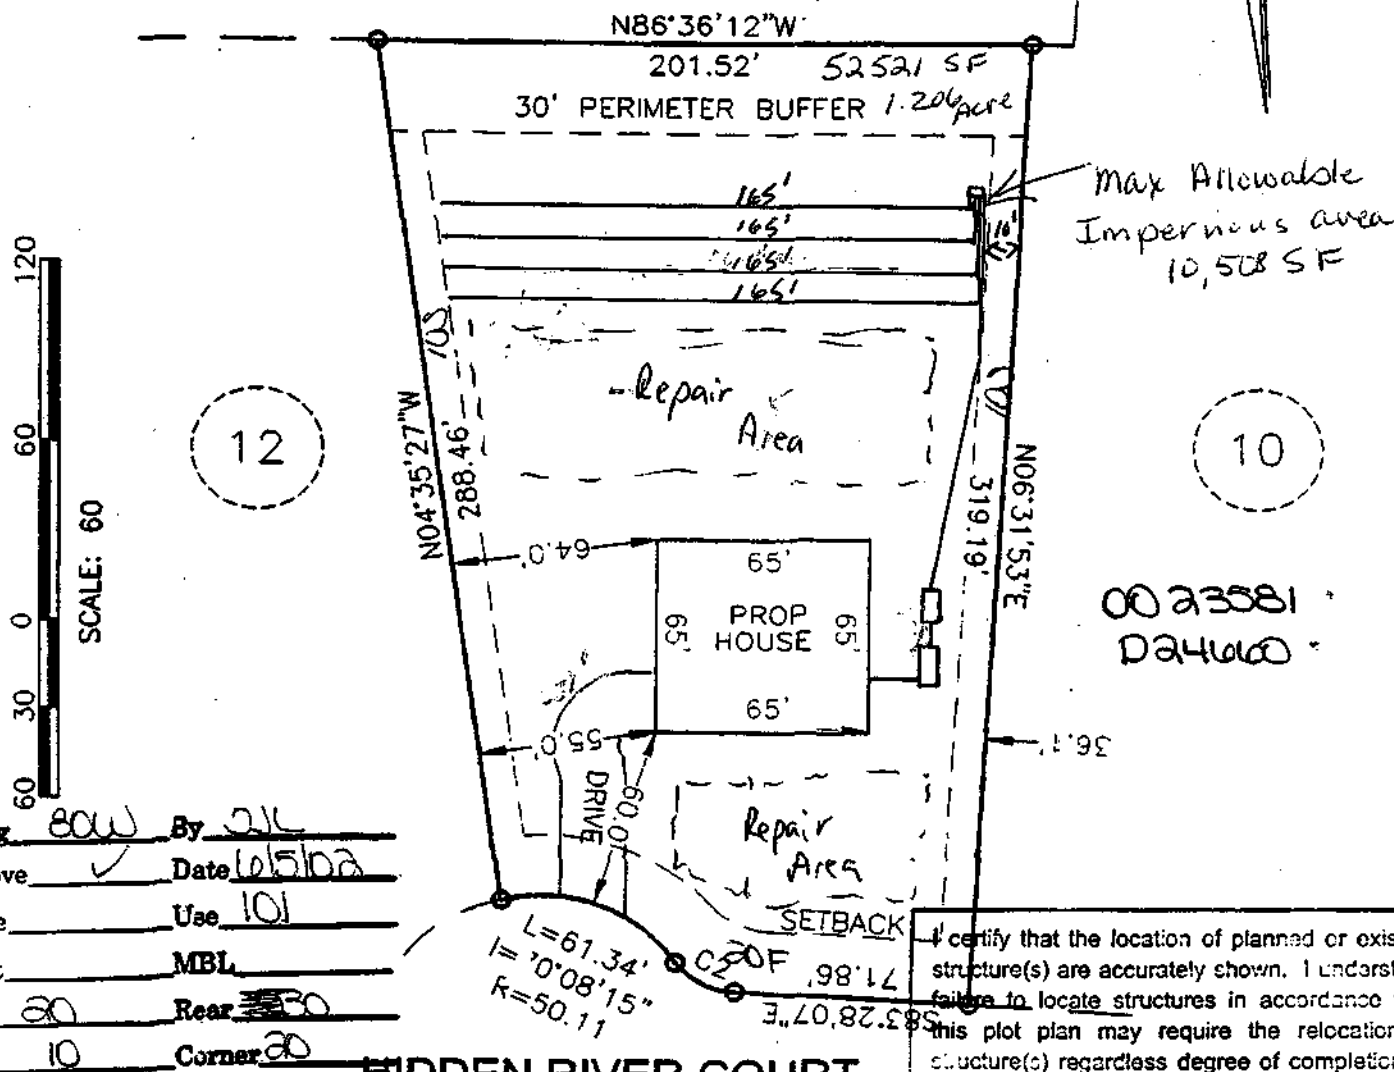

Zoning 80W By 211
 Approve ✓ Date 6/5/02
 Revise Use 101
 Reject MBL
 Front 20 Rear 350
 Side 10 Corner 20

Comments: Cluster Sub.
Setbacks per Plat.

HIDDEN RIVER COURT
 (45' PUBLIC R/W)

I certify that the location of planned or existing structure(s) are accurately shown. I understand failure to locate structures in accordance with this plot plan may require the relocation of structure(s) regardless degree of completion. I hereby grant permission to Municipal/County Representatives the right of entry to make evaluations or inspections upon this property.

Signature of Owner or Authorized Agent

PRELIMINARY PLAN FOR BUILDING PERMIT APPLICATION ONLY
NOT FOR SALES OR CONVEYANCES