

VWCKC

WAKE COUNTY HEALTH DEPARTMENT SEPTIC TANK LAYOUT AND PERMIT

TAX MAP NO.

243

PARCEL NO.

1(3)

PERMIT NO. B

29640

CONTRACTOR

Richard Wade, Assoc.

EC

OWNER

DATE

3-14-84

LOCATION

S. R. NO.

2002

SUBDIVISION NAME

Hunters Landing

LOT NO.

3

SECTION OR BLOCK NO.

REPAIR ☐ ORIGINAL PERMIT NO.GARBAGE DISPOSAL UNIT, YES ☐ NO ☒HOUSE ☒ MOBILE HOME ☐ BUSINESS ☐

NO. BEDROOMS

4

LOT AREA

40,000

SIZE OF TANK

1200 + 100 pump gal.

NITRIFICATION LINE

2(200x3) 1200

sq. ft.

DEPTH OF STONE IN LINES: 12" ☒RISER AND BAFFLE REQUIRED ☒ PUMP REQUIRED ☒WATER SUPPLY: INDIVIDUAL ☐ PUBLIC ☒ OTHER ☐


* PERMIT VOID 36 MONTHS FROM DATE OF ISSUANCE.

* PERMIT VOID IF NOT IN COMPLIANCE WITH ZONING REGULATIONS

* PERMIT MAY BE VOIDED IF SITE ALTERATIONS MADE

LAYOUT BY

Kathy Tew, R.S.

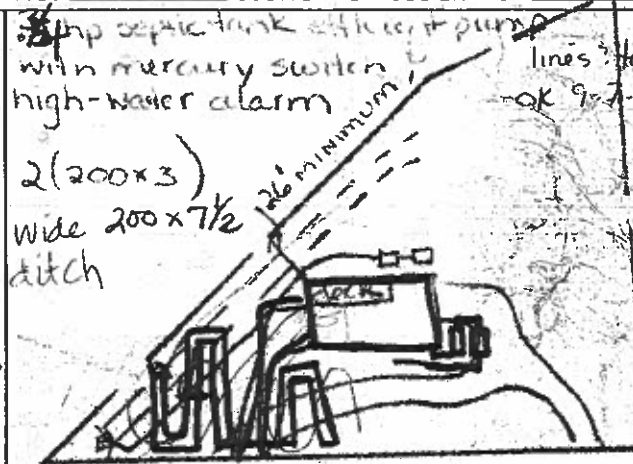

590-GP09

DATE

12-6-85

INSTALLED BY

David Flowers

Waters Plumbing

APPROVED BY

Kathy Tew, R.S.