

Environmental Services - Water Quality
Onsite Wastewater Scan Data Entry Form

PERMIT #: **B 0 I 2 8 8 5**

PIN #: **0 7 9 9 5 1 4 0 9 9**

OP DATE: **0 5 / 2 4 / 1 9 7 9**

SYSTEM USE:

- ☒ House
☐ Mobile Home
☐ Business
☐ Other

SEWAGE TYPE:

- ☒ Domestic
☐ Industrial

PUMP/SIPHON?:

- ☐ Yes
☒ No

PRESSURE MANIFOLD:

- ☐ Yes
☒ No

SYSTEM TYPE:

- ☐ I
☒ II
☐ III
☐ IV
☐ V
☐ VI
☐ Other

SUB TYPE:

- ☒ A
☐ B
☐ C
☐ D
☐ E
☐ F
☐ G

NBR BEDROOMS:

- ☐ 1
☐ 2
☒ 3
☐ 4
☐ 5
☐ 6
☐ Other

MAINT. SCHEDULE:

- ☐ Yes
☒ No

CERT. OPERATOR

- ☐ Yes
☒ No

- | GT | ST | PT | SIZE |
|-------------------------------------|-------------------------------------|-------------------------------------|------------------|
| ☐ | ☐ | | 750 |
| ☐ | ☐ | ☐ | 900 |
| ☐ | ☐ | ☐ | 1,000 |
| ☐ | ☐ | ☐ | 1,200 |
| ☐ | ☒ | ☐ | 1,500 |
| ☐ | ☐ | ☐ | 1,800 |
| ☐ | ☐ | ☐ | 2,100 |
| ☐ | ☐ | ☐ | 2,500 |
| ☐ | ☐ | ☐ | 3,000 |
| ☐ | ☐ | ☐ | 4,000 |
| ☐ | ☐ | ☐ | 5,000 |
| ☐ | ☐ | ☐ | 8,000 |
| ☐ | ☐ | ☐ | 10,000 |
| ☐ | ☐ | ☐ | Other |
| ☒ | | ☒ | None/NA GT or PT |

DRAINFIELD SIZE(SQ. FT.)

0 1 5 0 0

DRAIN TYPE:

- ☒ Stone
☐ EZ Flow
☐ Infiltrator
☐ Biodiffuser
☐ Cultec
☐ Drip
☐ Hancor
☐ Large Dia. Pipe
☐ Multi-Pipe
☐ Other

MAX DEPTH (IN.):

- ☐ 12 in. or less
☐ 18 in. or less
☐ 24 in. or less
☐ 26 in. or less
☐ 28 in. or less
☐ 30 in. or less
☐ 32 in. or less
☐ 36 in. or less
☒ Other

STONE DEPTH (IN.):

- ☐ 8 in. or less
☐ 12 in. or less
☒ 18 in. or less
☐ 24 in. or less
☐ Other

TRENCHES:

- ☐ Individual
☒ Bed

TRENCH WIDTH (IN.):

- ☐ 12 in. or less
☐ 18 in.
☐ 24 in.
☐ 36 in.
☒ 6 ft. or less
☐ 9 ft. or less
☐ Other

NA

* PERMIT VOID IF NOT IN COMPLIANCE WITH ZONING REGULATIONS

0799 51 4099

TAX MAP NO. 259

WAKE COUNTY HEALTH DEPARTMENT
SEPTIC TANK LAYOUT AND PERMIT

PARCEL NO. 6(3)

PERMIT NO. **B** 12885

OWNER OR CONTRACTOR T.A. Jacobs DATE 9-5-78

LOCATION Tom Gipson Bldg.

SUBDIVISION NAME James A. Bailey LOT NO. 7 SECTION OR BLOCK NO. Hwy 50 J

GARBAGE DISPOSAL UNIT YES ☒ NO ☐

HOUSE ☒ MOBILE HOME ☐ BUSINESS ☐

NO. BEDROOMS 3 LOT AREA 4.9 Acres

SIZE OF TANK 1500 gal.


NITRIFICATION LINE 2(125'x6') 1500 sq. ft.

DEPTH OF STONE IN LINES: 12" ☐ 18" ☒

WATER SUPPLY: INDIVIDUAL ☒ PUBLIC ☐

* PERMIT VOID 12 MONTHS FROM DATE OF ISSUANCE.

LAYOUT BY James R. Brown

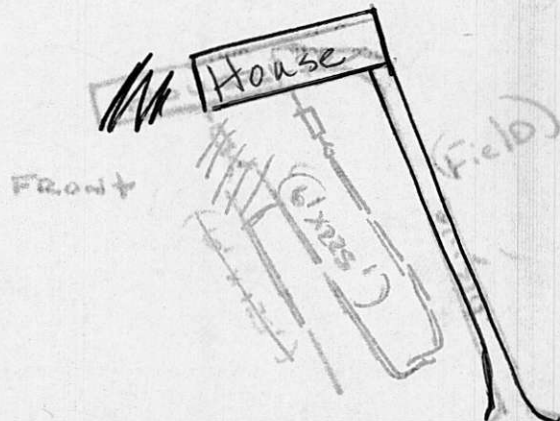

DATE 5-24-79

INSTALLED BY Woody Wilson

APPROVED BY James R. Brown