

Environmental Services - Water Quality
Onsite Wastewater Scan Data Entry Form

PERMIT #: 003396

PIN #: 1719384328

OP DATE: 1011311987

SYSTEM USE:

- ☒ House
☐ Mobile Home
☐ Business
☐ Other

SEWAGE TYPE:

- ☒ Domestic
☐ Industrial

PUMP/SIPHON?:

- ☐ Yes
☒ No

PRESSURE MANIFOLD:

- ☐ Yes
☒ No

SYSTEM TYPE:

- ☐ I
☒ II
☐ III
☐ IV
☐ V
☐ VI
☐ Other

SUB TYPE:

- ☒ A
☐ B
☐ C
☐ D
☐ E
☐ F
☐ G

NBR BEDROOMS:

- ☐ 1
☐ 2
☐ 3
☐ 4
☒ 5
☐ 6
☐ Other

MAINT. SCHEDULE:

- ☐ Yes
☒ No

CERT. OPERATOR

- ☐ Yes
☒ No

GT	ST	PT	SIZE
☐	☐		750
☐	☐	☐	900
☐	☐	☐	1,000
☐	☐	☐	1,200
☐	☒	☐	1,500
☐	☐	☐	1,800
☐	☐	☐	2,100
☐	☐	☐	2,500
☐	☐	☐	3,000
☐	☐	☐	4,000
☐	☐	☐	5,000
☐	☐	☐	8,000
☐	☐	☐	10,000
☐	☐	☐	Other
☒		☒	None/NA GT or PT

DRAINFIELD SIZE(SQ. FT.)

01500

DRAIN TYPE:

- ☒ Stone
☐ EZ Flow
☐ Infiltrator
☐ Biodiffuser
☐ Cultec
☐ Drip
☐ Hancor
☐ Large Dia. Pipe
☐ Multi-Pipe
☐ Other

MAX DEPTH (IN.):

- ☐ 12 in. or less
☐ 18 in. or less
☐ 24 in. or less
☐ 26 in. or less
☐ 28 in. or less
☐ 30 in. or less
☐ 32 in. or less
☐ 36 in. or less
☒ Other

STONE DEPTH (IN.):

- ☐ 8 in. or less
☒ 12 in. or less
☐ 18 in. or less
☐ 24 in. or less
☐ Other

TRENCHES:

- ☒ Individual
☐ Bed

TRENCH WIDTH (IN.):

- ☐ 12 in. or less
☐ 18 in.
☐ 24 in.
☒ 36 in.
☐ 6 ft. or less
☐ 9 ft. or less
☐ Other

CA

WAKE COUNTY HEALTH DEPARTMENT WELL AND SEWAGE SITE, LOCATION PERMIT

Tax Map No. 242 Parcel No. 286

No. C 03396

Contractor: Bonnie Clinton

Operation Permit []

Owner: _____

Date: 9/2/87

Location/Address: 11701 Pacesetter Dr

S.R. # _____

Subdivision Name: Banbury Woods

Lot No. 53

Section or Block No. _____


Zoning: W180 Township: Brenton Creek

Sewage System

Repair [] Original Permit No. _____
 Garbage Disposal Unit Yes [] No [X]
 House [X] Mobile Home [] Business []
 No. Bedrooms 3 Lot Area 410 sq. ft.
 Size of Tank 1500 gal.
 Nitrification Line 1500 2 (3 x 850) sq. ft.
 Depth of Stone: 12" [] Max. Depth of Trenches: _____ in.
 Riser and Baffle Required [] Pump Required []

Improvement Permit

*Permit Void 36 months from date of issuance
 *Permit Void if not in compliance with zoning regulations
 *Permit may be voided if site alterations made
 Layout By: Dr. W. G. L.

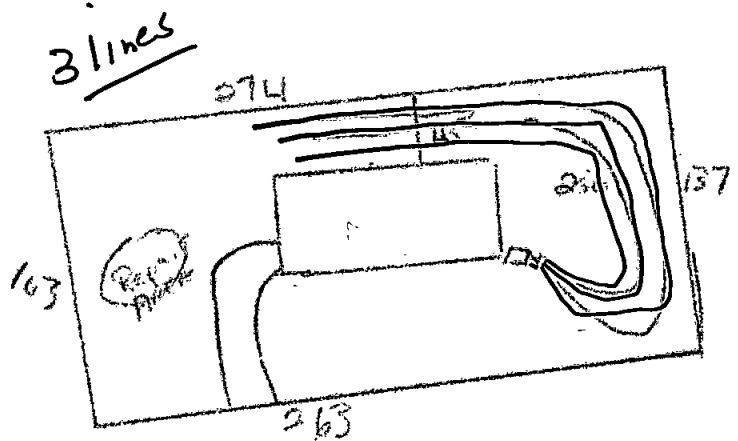

Date 10/13/87

Installed By Gullery

Approved By Dr. W. G. L.

Well System

Individual [] Semi-Public [] Public [X]
 New [] Replacement [] Repair []
 Fee Paid Yes [] No []
 Construction Compliance Yes _____ No _____
 Site Approved [] []
 Well Head Approved [] []
 Grouting Approved [] []

Bacteriological Results

Initial Sample: _____ Date: _____
 *Re-sample #1 _____ Date: _____
 *Re-sample #2 _____ Date: _____
 Re-chlorination as required Yes [] No []
 Comments: _____

*\$10.00 fee for all re-samples

All checks payable to: **Wake County Health Department**

Well Installed By: _____

Date System Finalized _____

Sanitarian _____

Date Inspected	Sanitarian	
	Yes	No
Final Inspection	Yes	No
Required Slab	[]	[]
Chlorinated	[]	[]
Required Certificate	[]	[]
Variance (Explain)	[]	[]
WCHD I.D. Affixed	[]	[]
Sample Collected	[]	[]

**Well permit void 36 months from issuance date

This report is based in part on information provided by the homeowner or his/her representative in the application submitted for this permit. The sanitarian is not responsible for false or misleading information contained in the application. The sanitarian is also not responsible for concealed conditions on the property or for statements in this report that may have resulted from false or misleading statements provided to him in the application. Neither Wake County nor the sanitarian warrants that the septic tank system will continue to function satisfactorily in the future or that the water supply will remain potable.