

Environmental Services - Water Quality
Onsite Wastewater Scan Data Entry Form

PERMIT #: D017260

PIN #: 0890827884

OP DATE: 1010512000

SYSTEM USE:

- ☒ House
☐ Mobile Home
☐ Business
☐ Other

SEWAGE TYPE:

- ☒ Domestic
☐ Industrial

PUMP/SIPHON?:

- ☒ Yes
☐ No

PRESSURE MANIFOLD:

- ☐ Yes
☒ No

SYSTEM TYPE:

- ☐ I
☐ II
☒ III
☐ IV
☐ V
☐ VI
☐ Other

SUB TYPE:

- ☐ A
☒ B
☐ C
☐ D
☐ E
☐ F
☐ G

NBR BEDROOMS:

- ☐ 1
☐ 2
☒ 3
☐ 4
☐ 5
☐ 6
☐ Other

MAINT. SCHEDULE:

- ☐ Yes
☒ No

CERT. OPERATOR

- ☐ Yes
☒ No

GT	ST	PT	SIZE
☐	☐		750
☐	☐	☐	900
☐	☐	☐	1,000
☐	☒	☒	1,200
☐	☐	☐	1,500
☐	☐	☐	1,800
☐	☐	☐	2,100
☐	☐	☐	2,500
☐	☐	☐	3,000
☐	☐	☐	4,000
☐	☐	☐	5,000
☐	☐	☐	8,000
☐	☐	☐	10,000
☐	☐	☐	Other
☒		☐	None/NA GT or PT

DRAINFIELD SIZE(SQ. FT.)

01200

DRAIN TYPE:

- ☐ Stone
☒ EZ Flow
☐ Infiltrator
☐ Biodiffuser
☐ Cultec
☐ Drip
☐ Hancor
☐ Large Dia. Pipe
☐ Multi-Pipe
☐ Other

MAX DEPTH (IN.):

- ☐ 12 in. or less
☐ 18 in. or less
☒ 24 in. or less
☐ 26 in. or less
☐ 28 in. or less
☐ 30 in. or less
☐ 32 in. or less
☐ 36 in. or less
☐ Other

STONE DEPTH (IN.):

- ☐ 8 in. or less
☒ 12 in. or less
☐ 18 in. or less
☐ 24 in. or less
☐ Other

TRENCHES:

- ☒ Individual
☐ Bed

TRENCH WIDTH (IN.):

- ☐ 12 in. or less
☐ 18 in.
☐ 24 in.
☒ 36 in.
☐ 6 ft. or less
☐ 9 ft. or less
☐ Other

WAKE COUNTY DEPARTMENT OF ENVIRONMENTAL SERVICES WELL AND SEWAGE SITE LOCATION PERMIT

NO PERMIT(S) FOR CONSTRUCTION, LOCATION OR RELOCATION ACTIVITY SHALL BE ISSUED
UNTIL AN AUTHORIZATION FOR WASTEWATER SYSTEM CONSTRUCTION HAS BEEN ISSUED
PERMIT VOID IF NOT IN COMPLIANCE WITH ZONING REGULATIONS AND/OR IF SITE IS ALTERED OR INTENDED USE CHANGED

PERMIT#: D017260 STATUS: A APP DATE: 02/14/2000 BLDG PERMIT#: 0002710
APPLICANT: CHATEAU CONSTRUCTION DAY PHONE: (919) 676 - 6766
ADDRESS: PO BOX 32189 FAX#: (919) 676 - 1635
CITY: RALEIGH STATE: NC ZIP: 27614
OWNER: BANYAN HOMES INC DAY PHONE: (999) 999 - 9999
ADDRESS: PO BOX 32189 FAX#: (999) 999 - 9999
CITY: RALEIGH STATE: NC ZIP: 27622
HD USE CD: 101 ONE-FAMILY HOUSE ORIG PERMIT#: REC?: Y
EXIST USE: TAX MAP#: 0225 0000
BEDROOMS: 3 BSMT: N #EMPLOYEES: 0 WATER: I WASTEWATER: I GARB DISPOS: N
TOWNSHIP: 02 BARTON'S CREEK JURIS: WC ZON: R80W PIN: 0890.04 82 7884 000
SUBD#: S 000 000 00 SUBD NAME: TADLOCK LANDING LOT-SEC: 5 ACRE: 1.98
IMPRV PRMT: ISSUED?: Y DATE: 04/18/2000 BY: JTW TYPE SYSTEM: III B PUMP: Y
CNSTR AUTH: ISSUED?: Y DATE: 04/18/2000 BY: JTW MAINT: N OPER: N
RECEIPT#: 0051790 FEE: 290.00 OP DATE: BY:
WATR SAMPL: REQ?: Y APPROVED?: DATE: PROPRIETARY SYS:
ST#: 1000 MI: DIR: NAME: LONG BARROW DIR: TYP: CT
DIRECTIONS: HWY 50 R NORWOOD L MT VERNON CHURCH R MT PLEASA
NT CHURCH 1/2 MI N OF SCHOOL

IMPROVEMENT PERMIT

SIZE OF TANK 1000 ST 1000 PT GALS. TOTAL SQ. FT. 1200 DEPTH OF STONE 12 IN. MAX. DEPTH LINE 24 IN.

WASTEWATER: DOMESTIC ☒ INDUSTRIAL ☐

I.P. ISSUED BY

Tim Waven, R.S.

AUTHORIZATION FOR WASTEWATER SYSTEM CONSTRUCTION

VOID SIXTY (60) MONTHS FROM DATE OF ISSUANCE

AUTHORIZATION CONDITIONS

Contractor To Follow Contours, See Attached Site Plan For Wastewater System Design And Well Location. The wastewater system shall not be covered or placed into use until inspected by the Wake County Department of Environmental Services and an Operation Permit issued.

OTHER CONDITIONS: Install drainfield on contour with no stepdowns. Keep septic system: 100' from any well; 15' side foundation / drain; 25' from rear foundation / drain; 10' from any P/L. ST Filter and double risers (6" above finished grade) required for septic tank. NEMA 4X Box and Alarm required for pump system (see attached). Divert surface water, foundation drains, roof gutter drains away from septic / pump tanks and drainfield. Do not locate / trench any utility through drainfield or repair area. Keep any water line 10' from septic system components.

SIZE OF TANK 1000 ST 1000 PT GALS. TOTAL SQ. FT. 1200 DEPTH OF STONE 12 IN. MAX. DEPTH LINE 24 IN.

ST FILTER REQUIRED ☒ NUMBER OF TRENCHES 3 LENGTH OF TRENCHES 133 FT. WIDTH OF TRENCHES 3 FT.

C.A. ISSUED BY *Tim Waven R.S.*

INSTALLED BY *Glenn Todd*

CTR. I.D. #

SEPTIC TANK FILTER USED *yes*

INNOV. APPL. #: IWWS- DATE *10/5/00*

INSTALLATION APPROVED BY *Todd Taylor*

WELL SYSTEM = PRIVATE ☒ SEMI-PUBLIC ☐ NEW ☒ REPLACEMENT ☐ EXISTING ☐

WELL LOG INFORMATION = DEPTH *405* CASING DEPTH *61* YIELD *2* STATIC LEVEL *30*

WELL CONTRACTOR *Esty* REG.# *1009* PUMP CONTRACTOR REG.#

CONSTRUCTION COMPLIANCE = GROUT APPROVED ☒

DATE *5/11/00*

EHS

WCHD ID # WELLHEAD APPROVED ☒

DATE

EHS

NEGATIVE BACTERIOLOGICAL RESULTS ☐

DATE

EHS

SYSTEM FINALIZED ☐

DATE

EHS

COMMENTS: See attached for well location and setbacks.

This permit is based in part on information provided by the homeowner or his/her representative in the application submitted for this permit. The Environmental Health Specialist is not responsible for false or misleading information contained in the application. The Environmental Health Specialist is also not responsible for concealed conditions on the property or for statements in this report that may have resulted from false or misleading statements provided to him in the application. Neither Wake County nor the Environmental Health Specialist warrants that the septic tank system will continue to function satisfactorily in the future or that the water supply will remain potable.

*9/13/00 checked
LINES & TANKS only 69.*

*EEE-222 L.C. * NOT REDUCED IN S.F.T. **

CTR. I.D. #

9937 JENKS PUMP INSTALLERS!

BANTAN HOMES

LOT 5, TADLOCK LANDINGS SUBD.

REF: B.M. 1999, PG. 1199

BARTON'S CREEK TOWNSHIP

WAKE COUNTY, NORTH CAROLINA

FEBRUARY 8, 2000

REVISED FEBRUARY 11, 2000

ZONED R - 80W


As Built

Pin: 0890-04-82-7884

I certify that the location of planned or existing structure(s) are accurately shown. I understand failure to locate structures in accordance with this plot plan may require the relocation of structure(s) regardless degree of completion. I hereby grant permission to Municipal/County Representatives the right of entry to make evaluations or inspections upon this property.

E. H. H. H.

Signature of Owner or Authorized Agent

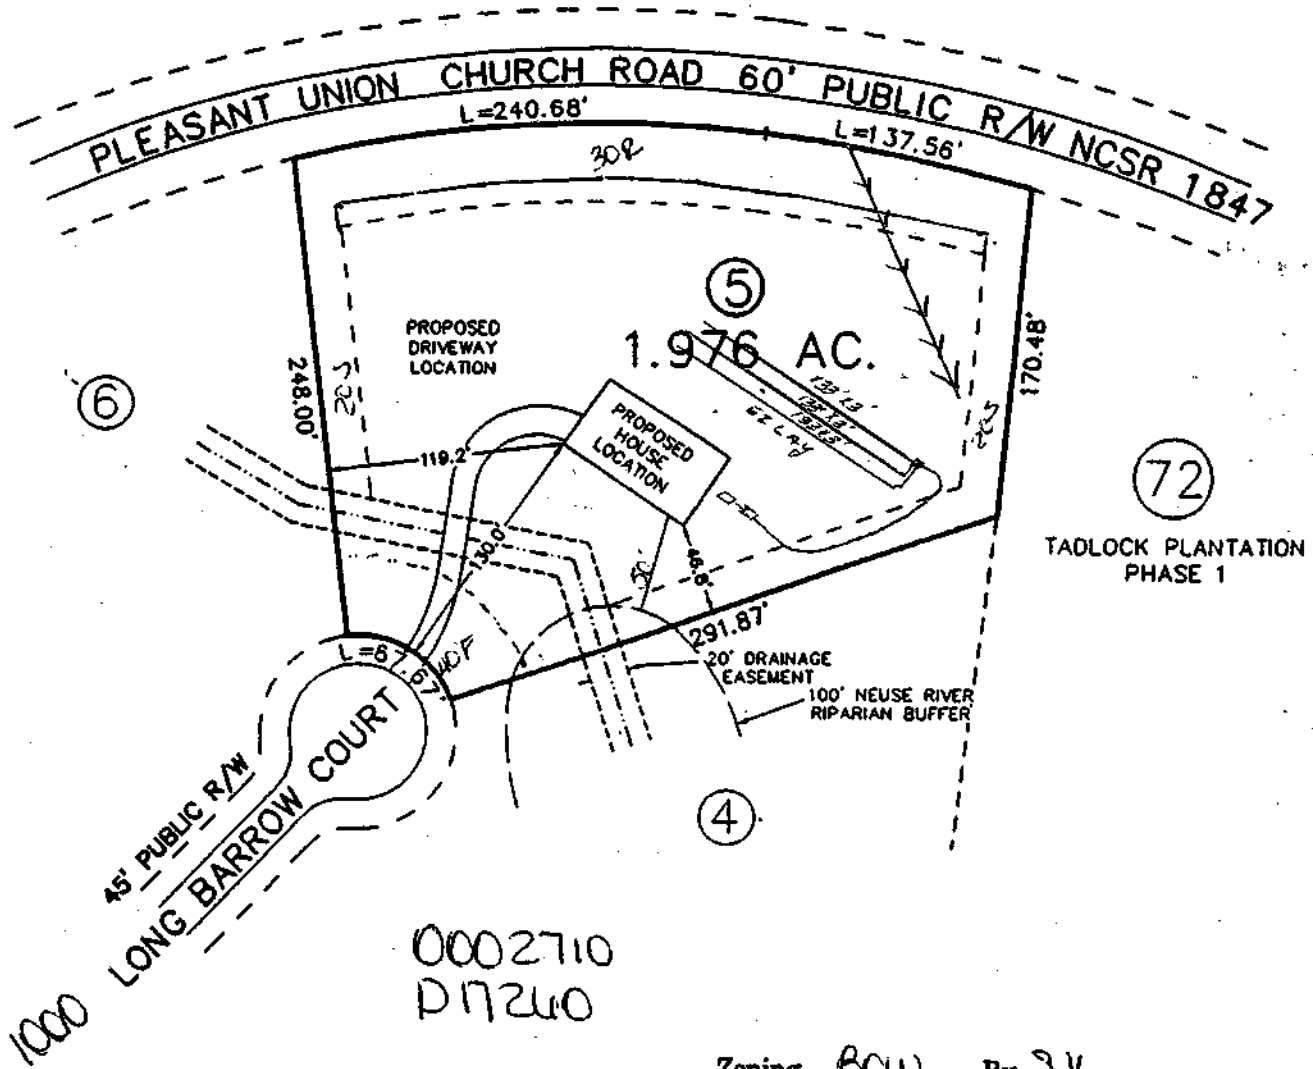

Zoning BCW By 311
 Approve ✓ Date 2-14-00
 Revise _____ Use 101
 Reject _____ MBL _____
 Front 40 Rear 30
 Side 20 Corner _____

Comments:

LOT 5, TADLOCK LANDINGS SUBD.

REF: B.M. 1999, PG. 1199

BARTON'S CREEK TOWNSHIP

WAKE COUNTY, NORTH CAROLINA

FEBRUARY 8, 2000


REVISED FEBRUARY 11, 2000

ZONED R - 80W

Pin: 0890-04-82-7884

I certify that the location of planned or existing structure(s) are accurately shown. I understand failure to locate structures in accordance with this plot plan may require the relocation of structure(s) regardless degree of completion. I hereby grant permission to Municipal/County Representatives the right of entry to make evaluations or inspections upon this property.

Signature of Owner or Authorized Agent

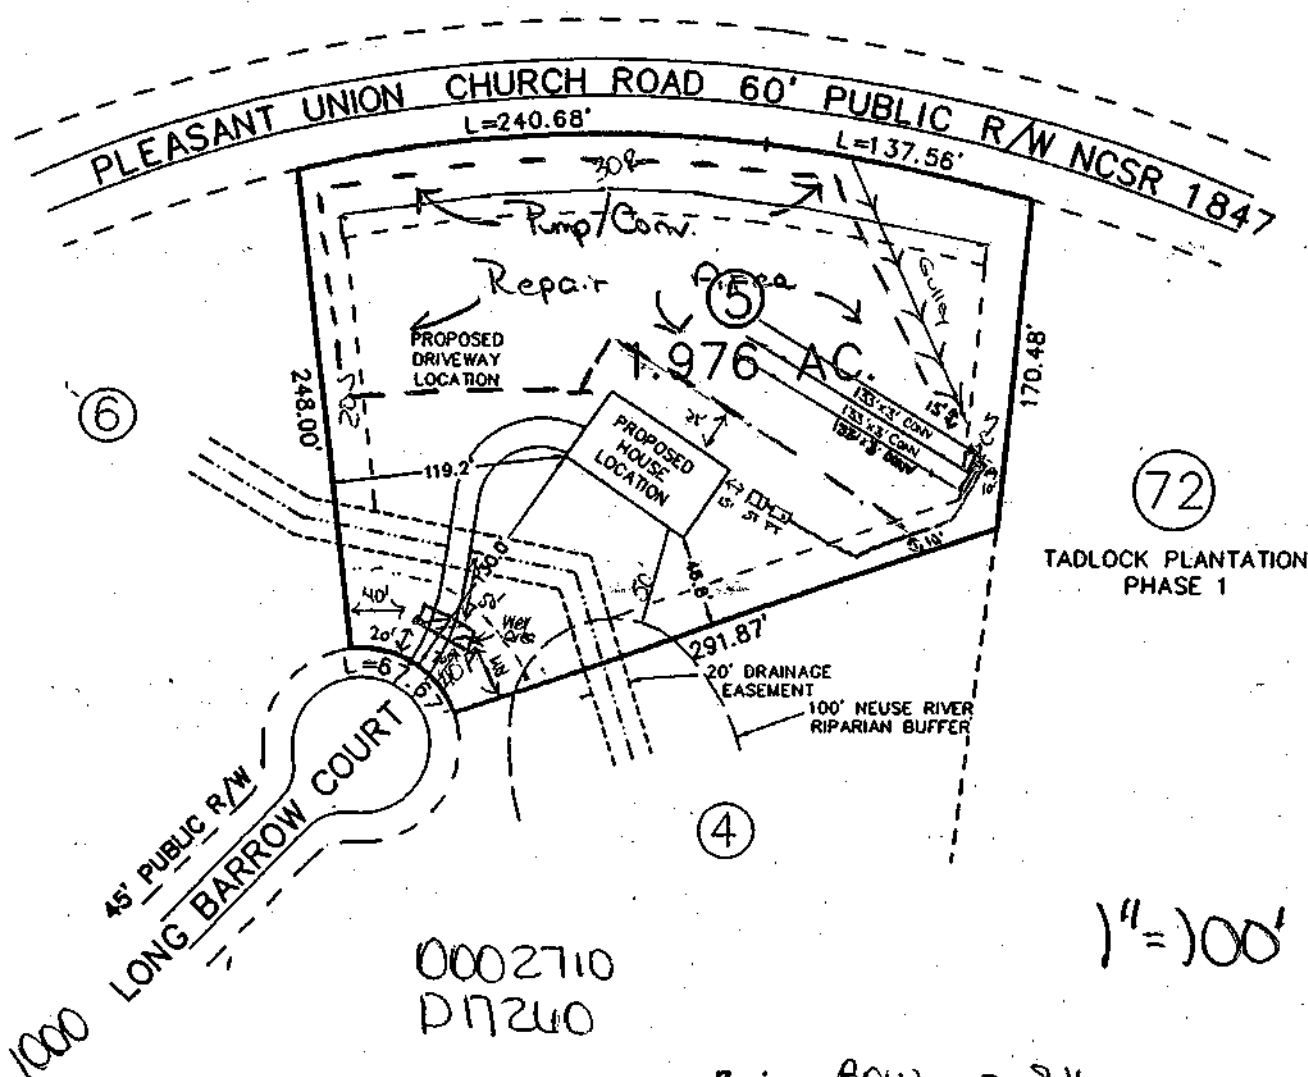

Note: Drainfield contours shown are approximate. Septic contractor to establish and follow actual contours. Septic contractor to call NCDES if contours are different than shown.

NOTES:

Zoning BOW By SJL
Approve ✓ Date 2-14-00
Revise Use 101
Reject MBL
Front 40 Rear 30
Side 20 Corner
Comments: