

Environmental Services - Water Quality
Onsite Wastewater Scan Data Entry Form

PERMIT #: 0020523

PIN #: 0199394554

OP DATE: 0113111995

SYSTEM USE:

- ☒ House
☐ Mobile Home
☐ Business
☐ Other

SEWAGE TYPE:

- ☒ Domestic
☐ Industrial

PUMP/SIPHON?:

- ☐ Yes
☒ No

PRESSURE MANIFOLD:

- ☐ Yes
☒ No

SYSTEM TYPE:

- ☐ I
☒ II
☐ III
☐ IV
☐ V
☐ VI
☐ Other

SUB TYPE:

- ☒ A
☐ B
☐ C
☐ D
☐ E
☐ F
☐ G

NBR BEDROOMS:

- ☐ 1
☐ 2
☒ 3
☐ 4
☐ 5
☐ 6
☐ Other

MAINT. SCHEDULE:

- ☐ Yes
☒ No

CERT. OPERATOR

- ☐ Yes
☒ No

GT ST PT SIZE

- | | | | |
|-------------------------------------|-------------------------------------|-------------------------------------|------------------|
| ☐ | ☐ | | 750 |
| ☐ | ☐ | ☐ | 900 |
| ☐ | ☒ | ☐ | 1,000 |
| ☐ | ☐ | ☐ | 1,200 |
| ☐ | ☐ | ☐ | 1,500 |
| ☐ | ☐ | ☐ | 1,800 |
| ☐ | ☐ | ☐ | 2,100 |
| ☐ | ☐ | ☐ | 2,500 |
| ☐ | ☐ | ☐ | 3,000 |
| ☐ | ☐ | ☐ | 4,000 |
| ☐ | ☐ | ☐ | 5,000 |
| ☐ | ☐ | ☐ | 8,000 |
| ☐ | ☐ | ☐ | 10,000 |
| ☐ | ☐ | ☐ | Other |
| ☒ | | ☒ | None/NA GT or PT |

DRAINFIELD SIZE(SQ. FT.)

01200

DRAIN TYPE:

- ☒ Stone
☐ EZ Flow
☐ Infiltrator
☐ Biodiffuser
☐ Cultec
☐ Drip
☐ Hancor
☐ Large Dia. Pipe
☐ Multi-Pipe
☐ Other

MAX DEPTH (IN.):

- ☐ 12 in. or less
☒ 18 in. or less
☐ 24 in. or less
☐ 26 in. or less
☐ 28 in. or less
☐ 30 in. or less
☐ 32 in. or less
☐ 36 in. or less
☐ Other

STONE DEPTH (IN.):

- ☐ 8 in. or less
☒ 12 in. or less
☐ 18 in. or less
☐ 24 in. or less
☐ Other

TRENCHES:

- ☒ Individual
☐ Bed

TRENCH WIDTH (IN.):

- ☐ 12 in. or less
☐ 18 in.
☐ 24 in.
☒ 36 in.
☐ 6 ft. or less
☐ 9 ft. or less
☐ Other

WAKE COUNTY HEALTH DEPARTMENT WELL AND SEWAGE SITE, LOCATION PERMIT

ALL PERMITS VOID 60 MONTHS FROM DATE OF ISSUANCE

Pin # 199-01394554 Project # 0951869

Tax Map No. _____ Parcel No. _____

Improvement Permit

Well Permit No. **C 20523**

Zoning Wake Co Township Bartons Creek

Operation Permit []

Owner/Contractor: Sierra Bld Co.

Date: 1-9-94



Location/Address: 6650 N (R) on Newwood Rd. (L) on Newwood Oaks Dr. Lot at end of street 5824 Newwood Oaks Dr.

S.R. # _____

Subdivision Name: Newwood Oaks

Lot No. 5

Section or Block No. _____

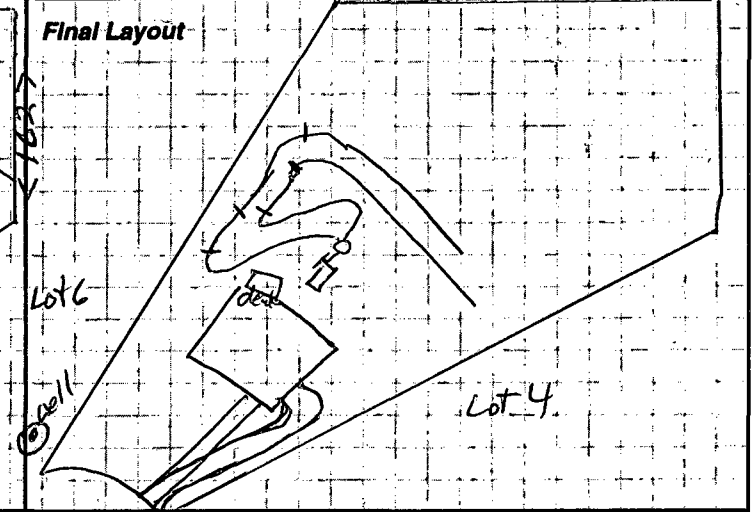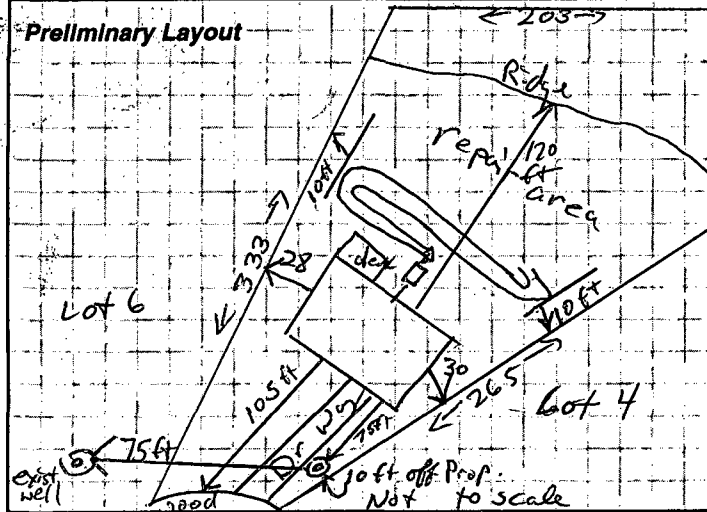

Repair [] Original Permit No. _____

Garbage Disposal Unit Yes [] No [X]

House [X] Mobile Home [] Business []

No. of Bedrooms 3 Lot Area 1.26 Acres

Size of Tank 1000 gal mulls gal.

Comments: Keep septic tank and system shallow - 18 in trench depth - Follow contours
Keep well - 75 ft off house - 75 ft off existing well (Lot 6) and 10 ft off property line (See Nass Site Plan 1-26-95)

Date: 5/15/95 Installed By: Brantley

Approved By: D R

Well System
 Individual [X] New [X] Fee Paid: Yes [X]
 Semi-Public [] Replacement []
 Public [] Repair []

Construction Compliance
 Site Approved [X] Well Head Approved [X] Grouting Approved [X]
6-16-95 Ralph McDonald, R.S.

Date Inspected _____ Sanitarian _____

Bacteriological Results
 Initial Sample: absent Date: 7-27-95
 * Re-Sample #1 _____ Date: _____
 * Re-Sample #2 _____ Date: _____
 * Re-chlorination as required [] Yes [] No

* Fees for all resamples _____
 All checks payable to: **Wake County Health Department**

Final Inspection

	Yes	No
Required Slab	[X]	[]
Chlorinated	[X]	[]
Required Certificate	[]	[]
Variance (Explain)	[]	[]
WCHD I.D. Affixed <u>5565</u>	[X]	[]
Sample Collected	[X]	[]

Comments: _____

Well Installed By: Grady Poole
7-31-95 Ralph McDonald, R.S.
 Date System Finalized _____ Sanitarian _____

This report is based in part on information provided by the homeowner or his/her representative in the application submitted for this permit. The sanitarian is not responsible for false or misleading information contained in the application. The sanitarian is also not responsible for concealed conditions on the property or for statements in this report that may have resulted from false or misleading statements provided to him in the application. Neither Wake County nor the sanitarian warrants that the septic tank system will continue to function satisfactorily in the future or that the water supply will remain potable.

COPY TO HEALTH DEPARTMENT

3002.017 - 5/14/93

Tax Map No.

Parcel No.

Pin 0799-01394554

MUST MAINTAIN 150' MBL


Kvm ~~regardless of its degree of completion:~~

Signature David L. Banks

Date 12-20-94

Check one:

() Owner () Builder/Contractor () Other

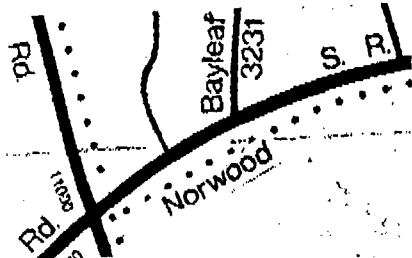

451869

I certify that the location of this structure is accurately shown. Failure to locate this structure in accordance with this plot plan could require relocation of the structure regardless of its degree of completion:

Signature

Check one:


() Owner

Date



Builder/Contractor

() Other

12-20-94

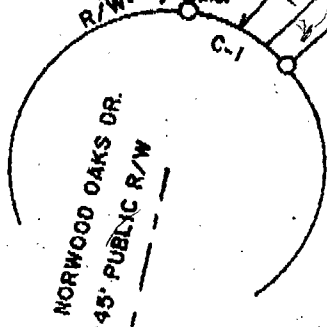


SCALE IN FEET

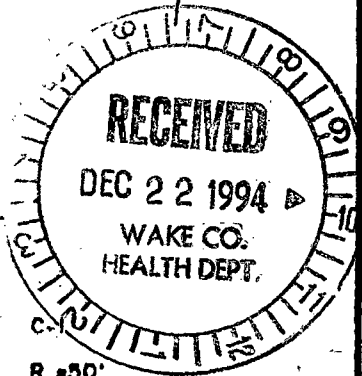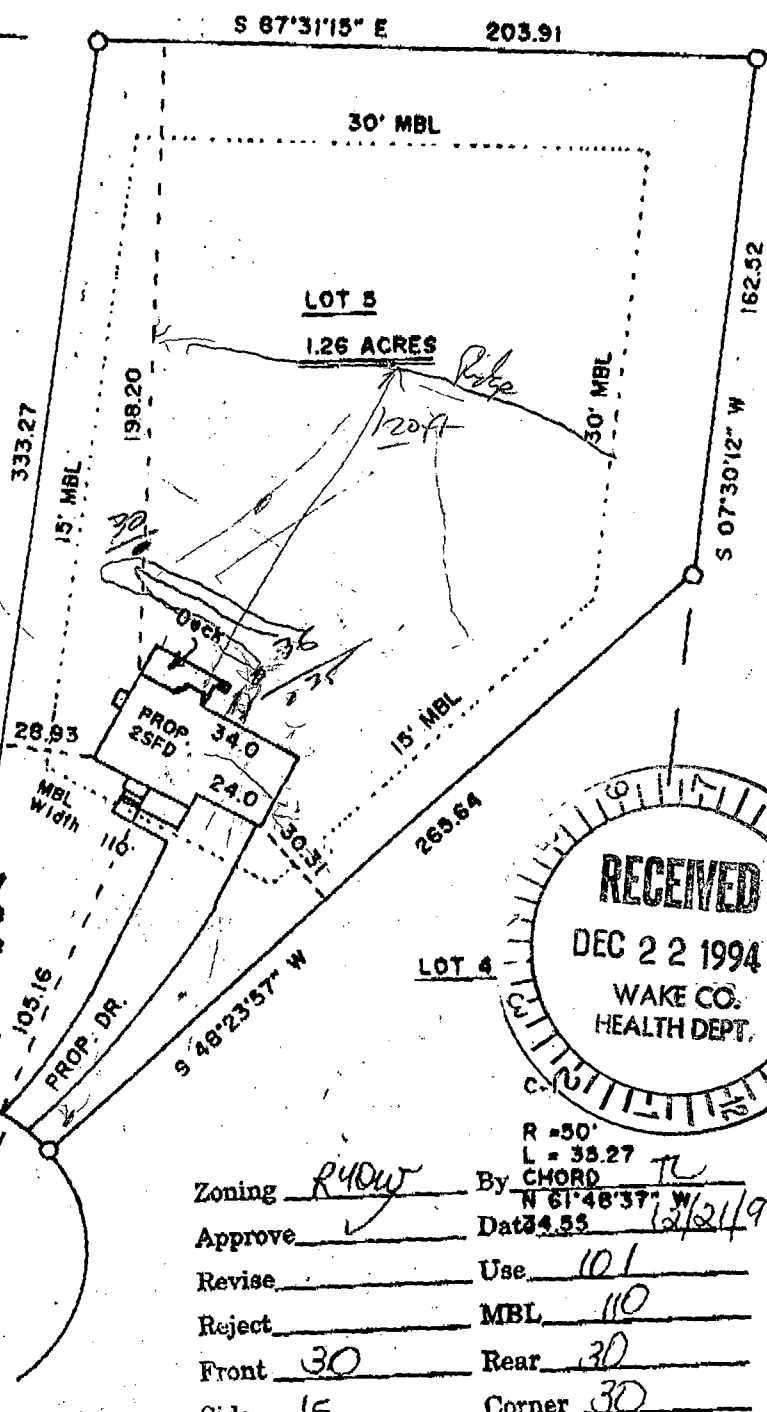

Zoning R40W By CHORD TL
Approve ✓ Date 12/21/94
Revise 101
Reject MBL 110
Front 30 Rear 30
Side 15 Corner 30

Comments:

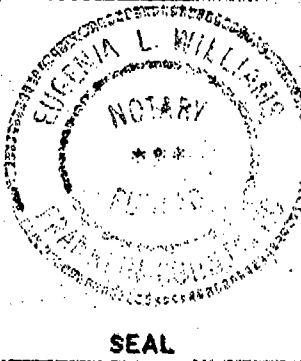

PROPOSED HOUSE LOCATION FOR
SIERRA BUILDING CO., INC.
BARTONS CREEK TOWNSHIP
WAKE COUNTY
NORTH CAROLINA

I, ROBERT G. WILLIAMS, certify that under my direction and supervision this map was drawn from an actual field survey; that the error of closure of the survey as calculated by latitudes and departures is 11; that this map was prepared in accordance with G.S. 42-30 as amended.

Witness my hand and seal this 12 day of DECEMBER, 1994.

R.L.S. L-1417 Robert G. Williams

Sworn to and subscribed before me this 12 day of DECEMBER, 1994.

My Commission expires: 3-17-97 Expiry: 3-17-97

ROBERT G. WILLIAMS
REGISTERED LAND SURVEYOR
ZEBULON, NORTH CAROLINA

Telephone: 269-5700

DRAWN BY: RGW & ELW

CHECKED BY: RGW

DATE: 12-13-94