

Environmental Services - Water Quality
Onsite Wastewater Scan Data Entry Form

PERMIT #: C 0 0 4 5 0 9

PIN #: 0 7 9 9 2 5 8 3 3 9

OP DATE: 0 4 / 1 2 / 1 9 8 8

SYSTEM USE:

- ☒ House
☐ Mobile Home
☐ Business
☐ Other

SEWAGE TYPE:

- ☒ Domestic
☐ Industrial

PUMP/SIPHON?:

- ☐ Yes
☒ No

PRESSURE MANIFOLD:

- ☐ Yes
☒ No

SYSTEM TYPE:

- ☐ I
☒ II
☐ III
☐ IV
☐ V
☐ VI
☐ Other

SUB TYPE:

- ☒ A
☐ B
☐ C
☐ D
☐ E
☐ F
☐ G

NBR BEDROOMS:

- ☐ 1
☐ 2
☐ 3
☒ 4
☐ 5
☐ 6
☐ Other

MAINT. SCHEDULE:

- ☐ Yes
☒ No

CERT. OPERATOR

- ☐ Yes
☒ No

GT	ST	PT	SIZE
☐	☐		750
☐	☐	☐	900
☐	☐	☐	1,000
☐	☒	☐	1,200 <i>existing</i>
☐	☐	☐	1,500
☐	☐	☐	1,800
☐	☐	☐	2,100
☐	☐	☐	2,500
☐	☐	☐	3,000
☐	☐	☐	4,000
☐	☐	☐	5,000
☐	☐	☐	8,000
☐	☐	☐	10,000
☐	☐	☐	Other
☒		☒	None/NA GT or PT

DRAINFIELD SIZE(SQ. FT.)

0 0 8 0 0

DRAIN TYPE:

- ☒ Stone
☐ EZ Flow
☐ Infiltrator
☐ Biodiffuser
☐ Cultec
☐ Drip
☐ Hancor
☐ Large Dia. Pipe
☐ Multi-Pipe
☐ Other

MAX DEPTH (IN.):

- ☐ 12 in. or less
☐ 18 in. or less
☐ 24 in. or less
☐ 26 in. or less
☐ 28 in. or less
☐ 30 in. or less
☐ 32 in. or less
☐ 36 in. or less
☒ Other

STONE DEPTH (IN.):

- ☐ 8 in. or less
☒ 12 in. or less
☐ 18 in. or less
☐ 24 in. or less
☐ Other

TRENCHES:

- ☒ Individual
☐ Bed

TRENCH WIDTH (IN.):

- ☐ 12 in. or less
☐ 18 in.
☐ 24 in.
☒ 36 in.
☐ 6 ft. or less
☐ 9 ft. or less
☐ Other

WAKE COUNTY HEALTH DEPARTMENT WELL AND SEWAGE SITE, LOCATION PERMIT

Tax Map No. 21240 Parcel No. 7(51) No. C 04509


Contractor: _____ Operation Permit []
 Owner: _____ Date: 3/24/88
 Location/Address: 2708 Vesting Way S.R. # _____
 Subdivision Name: Byrum Woods Lot No. 26 Section or Block No. _____
 Zoning: 1-Duke Township: Leasville

Sewage System

Repair [] Original Permit No. _____
 Garbage Disposal Unit Yes [] No []
 House ☒ Mobile Home [] Business []
 No. Bedrooms 4 Lot Area 928
 Size of Tank 12 Existing 1200 gal.
 Nitrification Line (200') (3 x 200') 18" sq. ft.
 Depth of Stone: 12" ☒ Max. Depth of Trenches: _____ in.
 Riser and Baffle Required [] Pump Required []

Improvement Permit

*Permit Void 36 months from date of issuance
 *Permit Void if not in compliance with zoning regulations
 *Permit may be voided if site alterations made
 Layout By: Des Leasville

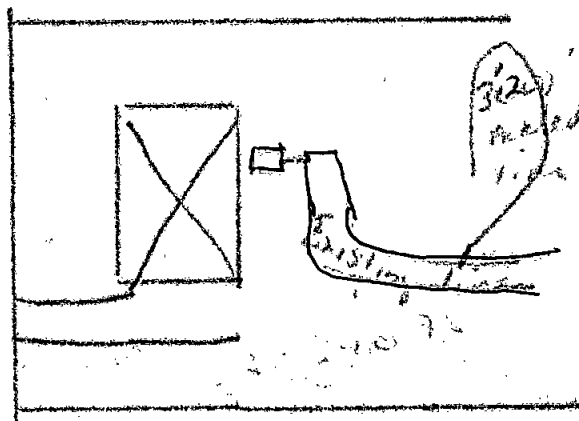

Date 4/12/88 Installed By Konegan Approved By James O. Thompson

Well System

Individual [] Semi-Public [] Public ☒
 New [] Replacement [] Repair ☒
 Fee Paid Yes [] No []
 Construction Compliance Yes No
 Site Approved [] []
 Well Head Approved [] []
 Grouting Approved [] []

Bacteriological Results

Initial Sample: _____ Date: _____
 *Re-sample #1 _____ Date: _____
 *Re-sample #2 _____ Date: _____
 Re-chlorination as required Yes ☒ No []
 Comments: _____

*\$10.00 fee for all re-samples

All checks payable to: **Wake County Health Department**

Well Installed By: _____

Date System Finalized _____ Sanitarian _____

Date Inspected	Sanitarian	
	Yes	No
Final Inspection	Yes	No
Required Slab	[]	[]
Chlorinated	[]	[]
Required Certificate	[]	[]
Variance (Explain)	[]	[]
WCHD I.D. Affixed	[]	[]
Sample Collected	[]	[]

**Well permit void 36 months from issuance date

This report is based in part on information provided by the homeowner or his/her representative in the application submitted for this permit. The sanitarian is not responsible for false or misleading information contained in the application. The sanitarian is also not responsible for concealed conditions on the property or for statements in this report that may have resulted from false or misleading statements provided to him in the application. Neither Wake County nor the sanitarian warrants that the septic tank system will continue to function satisfactorily in the future or that the water supply will remain potable.

Pin: 019901258339

W 10445

919-889-7372

I certify that the location of planned or existing structure(s) are accurately shown. I understand failure to locate structures in accordance with this plot plan may require the relocation of structure(s) regardless degree of completion. I hereby grant permission to Municipal/County Representatives the right of entry to make evaluations or inspections upon this property.

Signature of Owner or Authorized Agent


Site plan approved as shown for Deck/Porch.

Any changes to site plan voids approval. All setbacks apply for septic systems and wells, regarding any pools, decks, additions and/or accessory structures. Applicant is responsible for protecting all portions of the septic system, repair area and wells from damage during construction. Adhere to all Local and State Rules.

Approved by [Signature] Date 10-14-13
Wake County Department of Environmental Services.
Water and Waste Water Section

0141053

Zoning	3400	By	SV
Approve	✓	Date	10/13
Revise		Use	434
Reject		MBL	104
Front	30	Rear	30
Side	15	Corner	
Comments:			

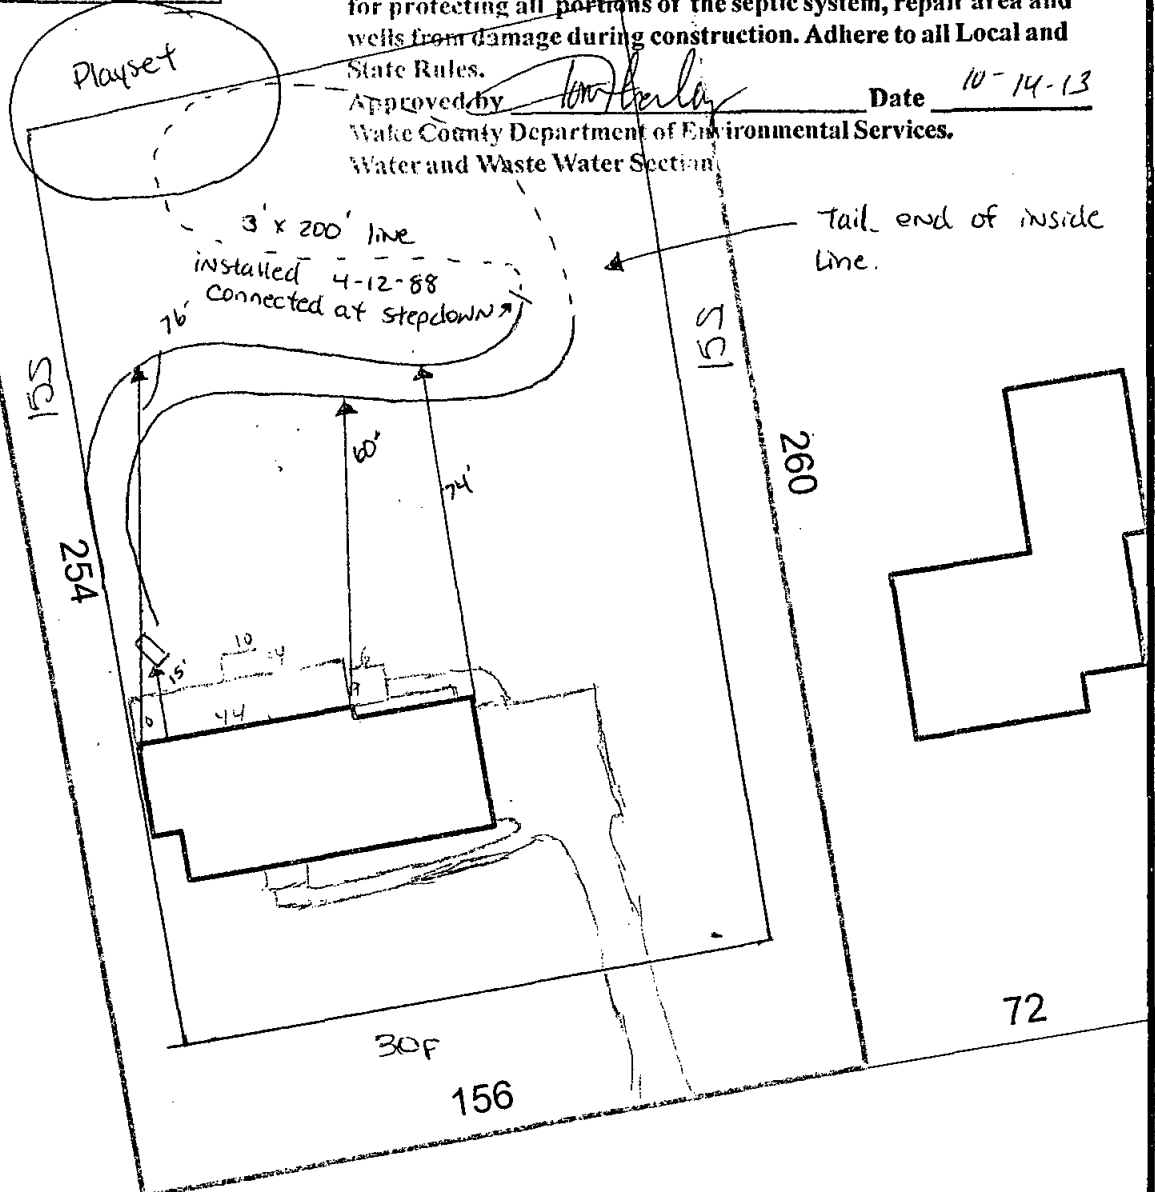

Wake County IDPP
(919) 856-6060
<http://www.wakegov.com>

1 inch = 40 feet

2708 VESTRY WAY

This document is a graphic representation only,
created from the best available sources.
Wake County assumes no responsibility for any errors,
or misuse of this document.

10/9/2013 12:53 PM

