

Wake
207719

WAKE COUNTY HEALTH DEPARTMENT SEPTIC TANK LAYOUT AND PERMIT

TAX MAP NO. 183 PARCEL NO. 13(5)

PERMIT NO. B

26726

CONTRACTOR

OWNER George Edmundson

LOCATION from US 1 N, west on SR 1909, ~1.1 mile on right

DATE 6-14-83

SUBDIVISION NAME

S. R. NO. 1909

LOT NO.

SECTION OR BLOCK NO.

REPAIR ☐ ORIGINAL PERMIT NO.

GARBAGE DISPOSAL UNIT YES ☐ NO ☒

HOUSE ☒ MOBILE HOME ☐ BUSINESS ☐

NO. BEDROOMS 3 LOT AREA 2.825 ac

SIZE OF TANK 2 (1000) gal.

NITRIFICATION LINE 2 (167 x 3) 1000 sq. ft.

DEPTH OF STONE IN LINES: 12" ☐ 18" ☐

RISER AND BAFFLE REQUIRED ☐ PUMP REQUIRED ☐

WATER SUPPLY: INDIVIDUAL ☒ PUBLIC ☐ OTHER ☐

- PERMIT VOID 36 MONTHS FROM DATE OF ISSUANCE.
- PERMIT VOID IF NOT IN COMPLIANCE WITH ZONING REGULATIONS
- PERMIT MAY BE VOIDED IF SITE ALTERATIONS MADE

LAYOUT BY Kathy Tew, R.S.

DATE


INSTALLED BY

APPROVED BY

Set tank
shallow
(12" cover
MAX)

2(175x3)

2(167x3)

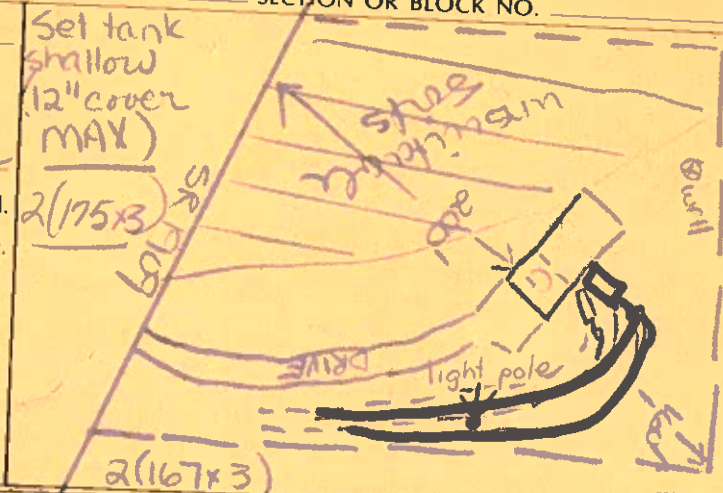

590-GP09