

WAKE COUNTY DEPARTMENT OF ENVIRONMENTAL SERVICES WASTEWATER PERMIT

NO PERMIT(S) FOR CONSTRUCTION, LOCATION OR RELOCATION ACTIVITY SHALL BE ISSUED UNTIL AN AUTHORIZATION FOR WASTEWATER SYSTEM CONSTRUCTION AUTHORIZATION HAS BEEN ISSUED

PERMIT VOID IF NOT IN COMPLIANCE WITH ZONING REGULATIONS AND/OR IF SITE IS ALTERED OR INTENDED USE CHANGED

OPERATIONS PERMIT**PERMIT # WRP-012423-2019****APPLICATION DATE:** 01/22/2019**BLDG. PERMIT#:** 0182885**PIN:** 1842132317**RECORDED:** Yes**TOWNSHIP:** 19 - Wake Forest**JURISDICTION:** Wake County**ZONING:** R-40W**APPLICANT:** AV Homes of Raleigh LLC
8025 CREEDMOOR RD**BUSINESS PHONE:****HOME PHONE:****MOBILE PHONE:****HD USE:** 0001 REPAIR/EXISTING SYSTEM**EXISTING USE:** 101A CONVENTIONAL ONE-FAMILY HOUSE**SITE ADDRESS:** 8412 ADAGIO CIR**SUBDIVISION:** Berklee Estates**LOT:** 49**ACRES:** 0.75**DIRECTIONS:** US 1 toward Franklin County subdivision on the Left before the franklin county line.

Systems defined as either type III-b, III-g with a pump, IV, V or VI, in accordance with the North Carolina administrative code 15A NCAC 18a .1961, table V as adopted by reference in the "Regulations Governing Wastewater Treatment Dispersal Systems in Wake County", requires Wake County Environmental Services to conduct periodic inspections of the system type pursuant to 15A NCAC 18a. 1961 (j). Fees for these inspections will be charged as per the approved Fee Schedule. In addition, all systems are to be operated and maintained as specified in 15A NCAC 18A .1961. This permit is based in part on information provided by the homeowner and/or his/her representative in the application submitted for this permit. The Environmental Health Specialist is not responsible for false or misleading information contained in the application. The environmental health specialist is also not responsible for concealed conditions on the property or for statements in this report that may have resulted from false or misleading statements provided to him/her in the application. Neither Wake County nor the Environmental Health Specialist warrants that the septic tank system will continue to function satisfactorily in the future or that the water supply will remain potable.

OPERATION PERMIT VALID FOR: No Expiration**INSTALLED BY:** BRANTLEY, CORY - 1036 - IV**PROPRIETARY SYSTEM:** EZ1203HG - EZFlow EZ 1203H Geo **PRETREATMENT SYSTEM:****SYSTEM TYPE INSTALLED:** III B**OPERATION PERMIT: STATUS:** Issued**ISSUED BY:** Tom Whaley**ISSUED DATE:** 02/26/2019**SEPTIC TANK:****DATE OF MANUFACTURE:****FILTER:****GREASE TRAP:****DATE OF MANUFACTURE:****FILTER:****DOSING PUMP TANK:****DATE OF MANUFACTURE:****FILTER:****CC1:** ETM1:**CC2:****ETM2:****RECIRCULATION TANK:****DATE OF MANUFACTURE:****CC1:** ETM1:**CC2:****ETM2:****SEPTIC TANK ELEVATION:****GREASE TRAP ELEVATION:****DOSING PUMP TANK ELEVATION:****RECIRCULATION TANK ELEVATION:****DISTRIBUTION DEVICE ELEVATION:**

INSTALLED TRENCH DEPTH	INSTALLED AGGREGATE DEPTH	INSTALLED TRENCH LENGTH	INSTALLED TRENCH BOTTOM ELEVATION
19	12	70	4.25
19	12	50	5.25
19	12	30	6

ACTUAL PRESSURE HEAD: 3

ACTUAL FLOW RATE: 0

ACTUAL DOSE VOLUME:

SPECIFIC OPERATION REQUIREMENTS:

ISSUED BY:





DATE: 02/26/2019



VICINITY MAP
Not To Scale


WRP-012423-2019

AS BUILT

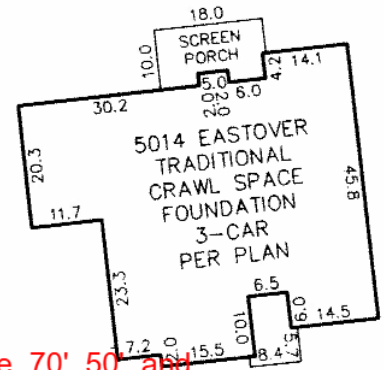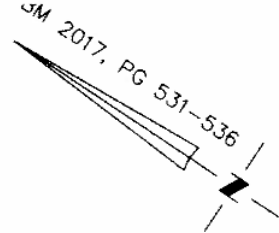

N/F
EARL B. BAREFOOT
FAMILY LIMITED PARTNERSHIP
DB 6995, PG 950

New additions to each line. 70', 50', and 30'. Each is tied into the existing undamaged section of the original line.

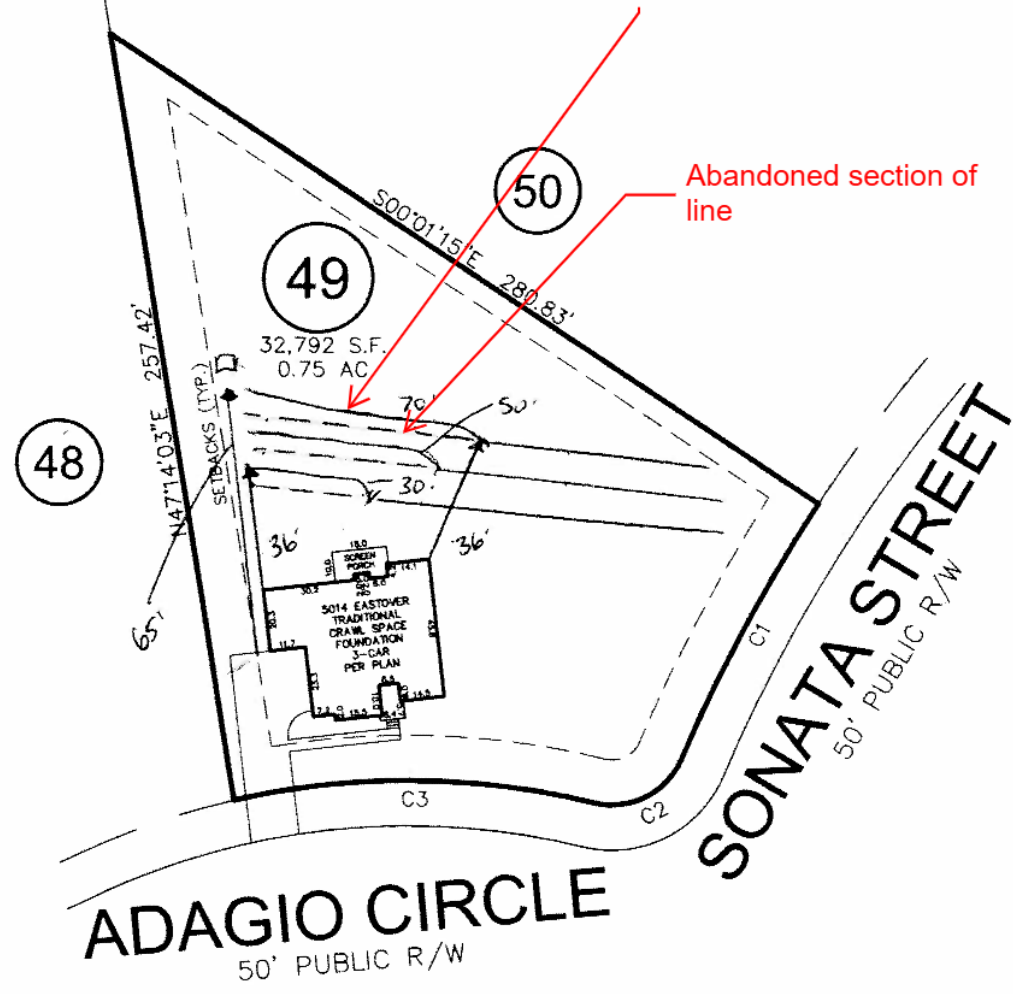


CURVE	RADIUS	ARC LENGTH	CH LENGTH	CH BEARING
C1	525.00'	96.23'	96.09'	S84°31'07"W
C2	25.00'	35.27'	32.42'	S60°18'46"E
C3	255.00'	119.81'	118.71'	N33°21'12"W

THIS PROPERTY MAY BE SUBJECT TO ANY AND ALL APPLICABLE DEED RESTRICTIONS, EASEMENTS, RIGHT-OF-WAY, UTILITIES AND RESTRICTIVE COVENANTS WHICH MAY BE OF RECORD OR IMPLIED

THIS DRAWING DOES NOT REFLECT AS-BUILT INFORMATION

PRELIMINARY PLAT
NOT FOR RECORDATION, CONVEYANCES, OR SALES.

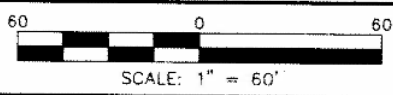

RESIDENTIAL LAND SERVICES, PLLC.
1500 Piney Plains Road, Suite 102
Cary, North Carolina 27518
Phone (919) 977-1554
Firm License # P-0873

HOUSE LOCATION PLOT PLAN

FOR
#8412 ADAGIO CIRCLE
LOT 49, BARKLEE ESTATES, PHASE 1
Wake Forest Township, Wake County, North Carolina

PROPERTY OF: AV HOMES
PLAT BOOK 2008 PAGE 15 DEED REFERENCE

DRAWN BY: JWW

DATE: FEBRUARY 1, 2018