

Environmental Services - Water Quality
Onsite Wastewater Scan Data Entry Form

PERMIT #: 8011052

PIN #: 1832448946

OP DATE: 1212311977

SYSTEM USE:

- ☒ House
☐ Mobile Home
☐ Business
☐ Other

SEWAGE TYPE:

- ☒ Domestic
☐ Industrial

PUMP/SIPHON?:

- ☐ Yes
☒ No

PRESSURE MANIFOLD:

- ☐ Yes
☒ No

SYSTEM TYPE:

- ☐ I
☒ II
☐ III
☐ IV
☐ V
☐ VI
☐ Other

SUB TYPE:

- ☒ A
☐ B
☐ C
☐ D
☐ E
☐ F
☐ G

NBR BEDROOMS:

- ☐ 1
☐ 2
☒ 3
☐ 4
☐ 5
☐ 6
☐ Other

MAINT. SCHEDULE:

- ☐ Yes
☒ No

CERT. OPERATOR

- ☐ Yes
☒ No

GT	ST	PT	SIZE
☐	☐		750
☐	☒	☐	900
☐	☐	☐	1,000
☐	☐	☐	1,200
☐	☐	☐	1,500
☐	☐	☐	1,800
☐	☐	☐	2,100
☐	☐	☐	2,500
☐	☐	☐	3,000
☐	☐	☐	4,000
☐	☐	☐	5,000
☐	☐	☐	8,000
☐	☐	☐	10,000
☐	☐	☐	Other
☒		☒	None/NA GT or PT

DRAINFIELD SIZE(SQ. FT.)

01000

DRAIN TYPE:

- ☒ Stone
☐ EZ Flow
☐ Infiltrator
☐ Biodiffuser
☐ Cultec
☐ Drip
☐ Hancor
☐ Large Dia. Pipe
☐ Multi-Pipe
☐ Other

MAX DEPTH (IN.):

- ☐ 12 in. or less
☐ 18 in. or less
☐ 24 in. or less
☐ 26 in. or less
☐ 28 in. or less
☐ 30 in. or less
☐ 32 in. or less
☐ 36 in. or less
☒ Other

STONE DEPTH (IN.):

- ☐ 8 in. or less
☐ 12 in. or less
☒ 18 in. or less
☐ 24 in. or less
☐ Other

TRENCHES:

- ☐ Individual
☒ Bed

TRENCH WIDTH (IN.):

- ☐ 12 in. or less
☐ 18 in.
☐ 24 in.
☐ 36 in.
☒ 6 ft. or less
☐ 9 ft. or less
☐ Other

* PERMIT VOID IF NOT IN COMPLIANCE WITH ZONING REGULATIONS

TAX MAP NO. 1.2

WAKE COUNTY HEALTH DEPARTMENT

PARCEL NO. 1.2

SEPTIC TANK LAYOUT AND PERMIT

PERMIT NO. **B**

OWNER OR CONTRACTOR Charles T. Williams DATE 9-22-11

LOCATION _____

S. R. NO. 1707

SUBDIVISION NAME Holly Forest LOT NO. 9 SECTION OR BLOCK NO. _____

GARBAGE DISPOSAL UNIT YES ☐ NO ☒

HOUSE ☒ MOBILE HOME ☐ BUSINESS ☐

NO. BEDROOMS 3 LOT AREA 1.91 Acres

SIZE OF TANK 900 gal.

NITRIFICATION LINE (167' x 6') 1000 sq. ft.

DEPTH OF STONE IN LINES: 12" ☐ 18" ☒

WATER SUPPLY: INDIVIDUAL ☒ PUBLIC ☐

* PERMIT VOID 12 MONTHS FROM DATE OF ISSUANCE.

LAYOUT BY James R. Brown

12-23-77


DATE

Bailey Pickhove

INSTALLED BY

James R. Brown

APPROVED BY

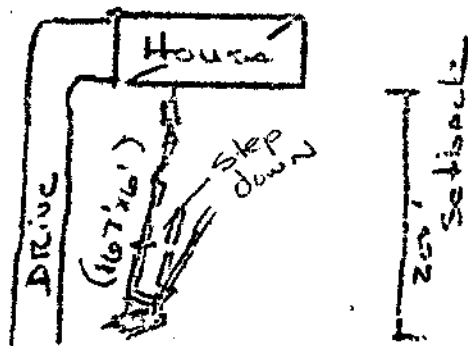

EIP N 04° 56' 50" E 166.62
 10' UTILITY & DRAINAGE EASEMENT


By SVL Date 09.16.09
 Approve ✓ Use 434
 Reject MBL 101
 Front 30 Rear 30
 Side 15 Corner

Comments:
0100539
 N/F
 WAKECROFT DEVELOPERS LTD.

I certify that the location of planned or existing structures are accurately shown. I understand failure to locate structures in accordance with this plot plan may require the relocation of structure(s) regardless of degree of completion. I hereby grant permission to Municipal/County Representatives the right of entry to make evaluations or inspections upon this property.

[Signature]
 Signature of Owner or Authorized Agent

Site plan approved as shown for deck + sidewalk
 Any changes to site plan voids approval. All setbacks apply for septic systems and wells, regarding any ponds, decks, additions and/or accessory structures. Applicant is responsible for protecting all portions of the property from damage during construction. State Rules. Approved by Wake County Department of Water and Waste 9/16/09

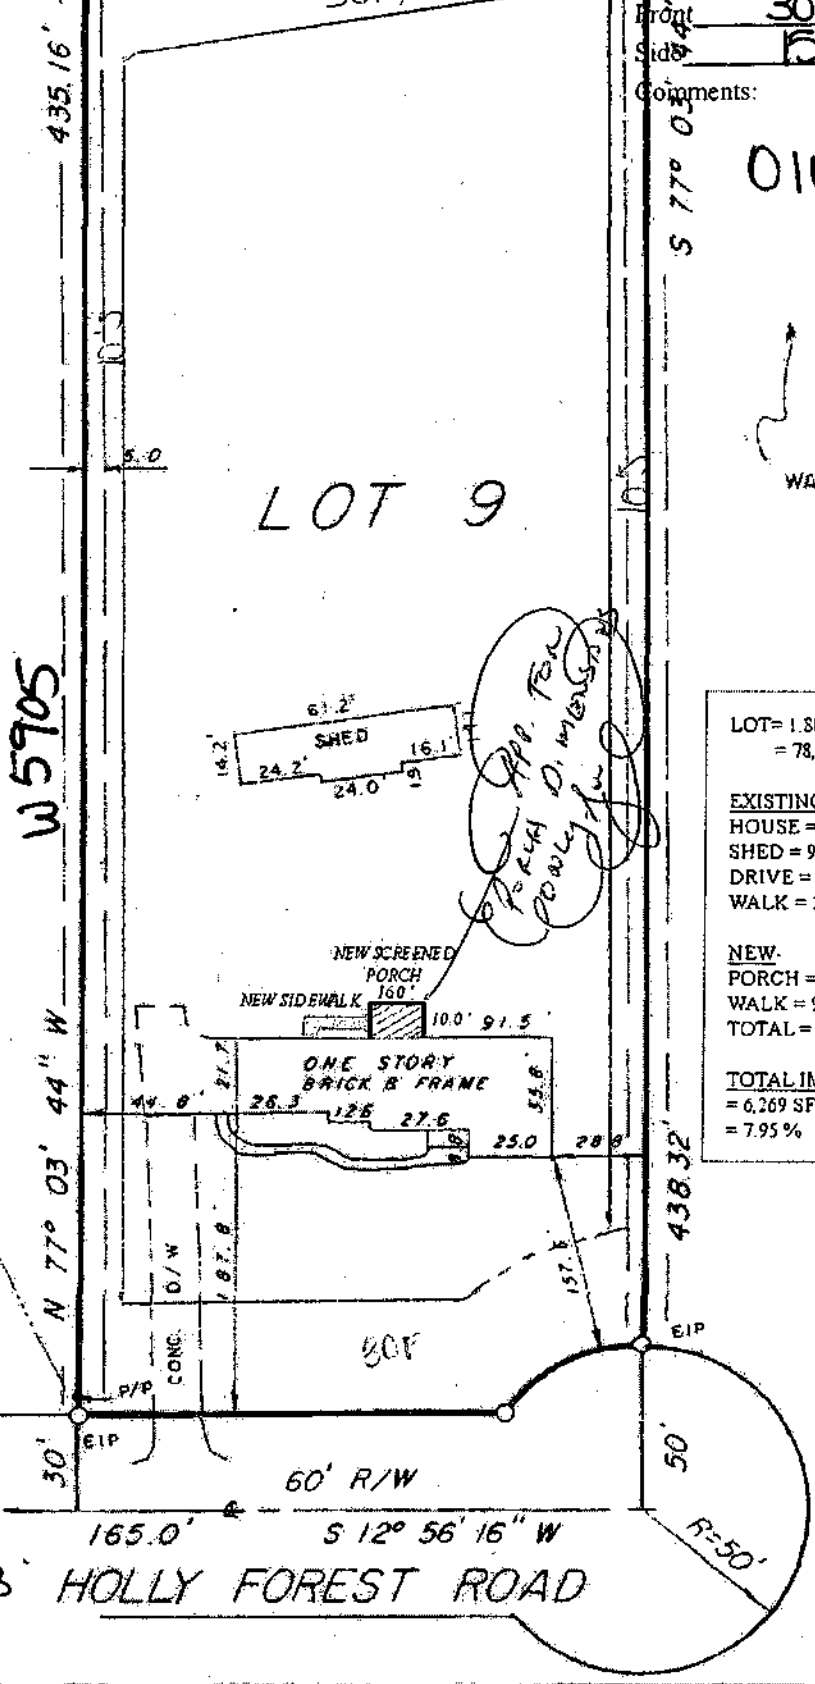

LOT = 1.806 ACRES
 = 78,832 SF

EXISTING:
 HOUSE = 2,612 SF
 SHED = 916 SF
 DRIVE = 2,278 SF
 WALK = 210 SF

NEW:
 PORCH = 160 SF
 WALK = 93 SF
 TOTAL = 253 SF

TOTAL IMP AREA (NEW & EXIST.) = 6,269 SF / 78,832 SF = 7.95%

HOLLY FOREST LOT 9 BLOCK 9 PIN: 183203448946
 8133 HOLLY FOREST ROAD
 1364.09' TO Q. OF S.R. 1909 165.0' S 12° 56' 16\"/>

I, JOHN Y. PHELPS, JR., REGISTERED SURVEYOR, CERTIFY THAT THIS MAP IS CORRECT AND THAT THE BOUNDARIES SHOWN ARE WHOLLY ON THE LOT AND THAT THERE ARE NO ENCUMBRANCES OR OTHER BUILDINGS ON THE LOT.	PROPERTY OF JOHN T. BAXTER & WIFE LAVAY M. BAXTER	
	NEW LIGHT TOWNSHIP, WAKE CO., N. C.	
	SCALE 1" = 60' DATE 06-27-78 252 4345	JOHN Y. PHELPS, JR. REGISTERED SURVEYOR RALEIGH, N. C.
	UPDATED 12/3/86 RECORDED IN BOOK OF MAPS 1975 VOL 1 PAGE 124 WAKE COUNTY, N. C.	