

Environmental Services - Water Quality  
Onsite Wastewater Scan Data Entry Form

PERMIT #: 0021934

PIN #: 1779424522

OP DATE: 0512212003

SYSTEM USE:

- ☒ House  
☐ Mobile Home  
☐ Business  
☐ Other

SEWAGE TYPE:

- ☒ Domestic  
☐ Industrial

PUMP/SIPHON?:

- ☒ Yes  
☐ No

PRESSURE MANIFOLD:

- ☐ Yes  
☒ No

SYSTEM TYPE:

- ☐ I  
☐ II  
☒ III  
☐ IV  
☐ V  
☐ VI  
☐ Other

SUB TYPE:

- ☐ A  
☒ B  
☐ C  
☐ D  
☐ E  
☐ F  
☐ G

NBR BEDROOMS:

- ☐ 1  
☐ 2  
☐ 3  
☒ 4  
☐ 5  
☐ 6  
☐ Other

MAINT. SCHEDULE:

- ☐ Yes  
☒ No

CERT. OPERATOR

- ☐ Yes  
☒ No

| GT                                  | ST                                  | PT                                  | SIZE             |
|-------------------------------------|-------------------------------------|-------------------------------------|------------------|
| <input type="checkbox"/>            | <input type="checkbox"/>            |                                     | 750              |
| <input type="checkbox"/>            | <input type="checkbox"/>            | <input type="checkbox"/>            | 900              |
| <input type="checkbox"/>            | <input type="checkbox"/>            | <input type="checkbox"/>            | 1,000            |
| <input type="checkbox"/>            | <input checked="" type="checkbox"/> | <input checked="" type="checkbox"/> | 1,200            |
| <input type="checkbox"/>            | <input type="checkbox"/>            | <input type="checkbox"/>            | 1,500            |
| <input type="checkbox"/>            | <input type="checkbox"/>            | <input type="checkbox"/>            | 1,800            |
| <input type="checkbox"/>            | <input type="checkbox"/>            | <input type="checkbox"/>            | 10,000           |
| <input type="checkbox"/>            | <input type="checkbox"/>            | <input type="checkbox"/>            | Other            |
| <input checked="" type="checkbox"/> |                                     | <input type="checkbox"/>            | None/NA GT or PT |

DRAINFIELD SIZE(SQ. FT.)

01350

DRAIN TYPE:

- ☐ Stone  
☒ EZ Flow  
☐ Infiltrator  
☐ Biodiffuser  
☐ Cultec  
☐ Drip  
☐ Hancor  
☐ Large Dia. Pipe  
☐ Multi-Pipe  
☐ Other

MAX DEPTH (IN.):

- ☒ 12 in. or less  
☐ 18 in. or less  
☐ 24 in. or less  
☐ 26 in. or less  
☐ 28 in. or less  
☐ 30 in. or less  
☐ 32 in. or less  
☐ 36 in. or less  
☐ Other

STONE DEPTH (IN.):

- ☐ 8 in. or less  
☒ 12 in. or less  
☐ 18 in. or less  
☐ 24 in. or less  
☐ Other

TRENCHES:

- ☒ Individual  
☐ Bed

TRENCH WIDTH (IN.):

- ☐ 12 in. or less  
☐ 18 in.  
☐ 24 in.  
☒ 36 in.  
☐ 6 ft. or less  
☐ 9 ft. or less  
☐ Other

WAKE COUNTY DEPARTMENT OF ENVIRONMENTAL SERVICES WELL AND SEWAGE SITE LOCATION PERMIT  
NO PERMIT(S) FOR CONSTRUCTION, LOCATION OR RELOCATION ACTIVITY SHALL BE ISSUED  
UNTIL AN AUTHORIZATION FOR WASTEWATER SYSTEM CONSTRUCTION HAS BEEN ISSUED

\*PERMIT VOID IF NOT IN COMPLIANCE WITH ZONING REGULATIONS AND/ OR IF SITE IS ALTERED OR INTENDED USE CHANGED\*

PERMIT#: D021934 STATUS: A APP. DATE: 06/07/2001 BLDG. PERMIT#: 0014152  
PIN: 1779.03 42 1571 000 TAX MAP: 0270 0020 RECORDED: Y ORIG. PERMIT#:   
TOWNSHIP: 19 WAKE FOREST JURISDICTION: WC ZONING: R40W  
APPLICANT: STEVER, DENNIS & JANE  
4908 HUNTINGCREEK DR  
WAKE FOREST, NC 27587  
( 919 ) 556 - 7259  
USE: HD USE: 101 ONE-FAMILY HOUSE  
EXIST USE:  
DISPOSAL: N BEDROOMS: 4 BASEMENT: Y #EMPLOYEES: 0  
SITE: ADDRESS: 2300 PULLEY TOWN RD  
SUBDIVISION: LOT: ACRES: 6.03  
DIRECTION: US 1, TR SR 2045, CROSS SR 2049, TL HUNTINGCREE  
K DR

Well System: WATER: INDIVIDUAL TYPE: NEW

WELL LOG INFORMATION: DEPTH: 565 CASING DEPTH: 110 YIELD: 3 STATIC LEVEL: 30  
WELL CONTRACTOR: Coddigan REG.# 722 PUMP CONTRACTOR: Tenks REG.# 983  
Construction Compliance GROUT APPROVED ☒ DATE 5/6/03 EHS Andre R. Ego - The Great  
WELLHEAD APPROVED ☒ DATE 5/12/07 EHS Andre R. Ego  
SYSTEM FINALIZED ☒ DATE 5/19/03 EHS Andre R. Ego

COMMENTS:

Operation Permit

DESIGN FLOW: \_\_\_\_\_ gal./min. ACTUAL FLOW: \_\_\_\_\_ INNOVATIVE LETTER: \_\_\_\_\_

INSTALLED BY: Brett Murphy INSTALLATION APPROVED BY: Adrienne Brown  
PROPRIETARY SYSTEM: E E-Z LAY PIPE FILTER NO: \_\_\_\_\_  
COMMENTS:

OPERATIONS PERMIT ISSUED? X OP DATE: 5/22/03 BY: Adrienne Brown

This permit is based in part on information provided by the homeowner or his/her representative in the application submitted for this permit. The Environmental Health Specialist is not responsible for false or misleading information contained in the application. The Environmental Health Specialist is also not responsible for concealed conditions on the property or for statements in this report that may have resulted from false or misleading statements provided to him in the application. Neither Wake County nor the Environmental Health Specialist warrants that the septic tank system will continue to function satisfactorily in the future or that the water supply will remain potable.

WAKE COUNTY DEPARTMENT OF ENVIRONMENTAL SERVICES WELL AND SEWAGE SITE LOCATION PERMIT

NO PERMIT(S) FOR CONSTRUCTION, LOCATION OR RELOCATION ACTIVITY SHALL BE ISSUED  
UNTIL AN AUTHORIZATION FOR WASTEWATER SYSTEM CONSTRUCTION HAS BEEN ISSUED  
\*PERMIT VOID IF NOT IN COMPLIANCE WITH ZONING REGULATIONS AND/ OR IF SITE IS ALTERED OR INTENDED USE CHANGED\*

PERMIT#: D021934 STATUS: A APP. DATE: 06/07/2001 BLDG. PERMIT#: 0014152  
PIN: 1779.03 42 1571 000 TAX MAP: 0270 0020 RECORDED: Y ORIG. PERMIT#:   
TOWNSHIP: 19 WAKE FOREST JURISDICTION: WC ZONING: R40W  
APPLICANT: STEVER, DENNIS & JANE  
4908 HUNTINGCREEK DR  
WAKE FOREST, NC 27587  
(919) 556-7259  
USE: HD USE: 101 ONE-FAMILY HOUSE  
EXIST USE:  
DISPOSAL: N BEDROOMS: 4 BASEMENT: Y #EMPLOYEES: 0 FOUND DRAIN:   
SITE: ADDRESS: 2300 PULLEY TOWN RD  
SUBDIVISION: LOT: ACRES: 6.03  
DIRECTION: US 1, TR SR 2045, CROSS SR 2049, TL HUNTINGCREE  
K DR

Address should be  
6404 Pulley Town Rd.  
NEW PIN  
1779 42 4522

IMPROVEMENT PERMIT

TANK SIZE: 1200 gal. PUMP Tank: 1200 gal. SQ FT: 1350 INNOVATIVE MAX DEPTH LINE: 12 in.  
WASTEWATER: INDIVIDUAL SEWAGE: DOMESTIC TYPE SYSTEM: III G PUMP: Y P/M: N  
DAILY FLOW: 480 gal/day DESIGN FEE REQ?: PAID?: WATER: INDIVIDUAL

COMMENTS:

IP ISSUED? Y DATE: 12/05/2001 BY: (RTT) Todd Taylor PHONE#: 857-9354

AUTHORIZATION FOR WASTEWATER/WATER SYSTEM CONSTRUCTION

VOID SIXTY (60) MONTHS FROM DATE OF ISSUANCE

AUTHORIZATION CONDITIONS:

Contractors shall install system on contours, see attached site plan for wastewater system design and well location. No underground utilities, water lines or sprinkler systems may be located in the original system or repair areas. A septic tank filter with a riser for access is required. The wastewater system shall not be covered or placed into use until inspected by the Wake County Department of Environmental Services and an Operation Permit issued. **OTHER CONDITIONS:**

INSTALL ON CONTOUR. 25% REDUCTION SYSTEM BEING USED. A CURTAIN DRAIN NEEDED ABOVE SYSTEM. SEE ATTACHED AT-GRADE LETTER FOR INSTALLATION. NEED PRE-CONSTRUCTION MEETING WITH CONTRACTOR. KEEP ALL SETBACKS FROM BUFFERS, PROPERTY LINES, AND HOUSE. 100FT FROM WELL AND 50FT FROM ANY EXISTING WELL. IF SITE OR SITE PLAN CHANGES PERMIT BECOMES VOID. IF GRAVITY FLOW CAN BE ACHIEVED PUMP WILL NOT BE NEEDED. THIS OFFICE NEEDS TO BE TOLD TO MAKE RIGHT CHANGES. CALL BEFORE INSTALLATION.

TANK SIZE: 1200 gal. PUMP TANK: 1200 gal. SQ FT: 1350 INNOVATIVE MAX DEPTH LINE: 12 in.  
MAINT: N OPER: N L/O: Y TRENCH#: 3 LENGTH: 150 ft. WIDTH: 36 in. DESIGNER:   
# SUBFIELDS: \_ DESIGN HEAD PRESSURE: \_ DESIGN FLOW: \_ gal/min DOSE VOLUME: \_ gal.

CA ISSUED? Y DATE: 12/05/2001 BY: (RTT) Todd Taylor PHONE#: 857-9354

0021934

0014152

ATTN: TO DD TAYLOR  
11-28-01

4-BEDROOM CONV. SYSTEM

LINES 4,5,6

LTAR W-EZLAY

As Built

Revised Site

W-EZLAY

PIN: 1779.03-42-1571


0014152

0021934

NYOW is SBC  
✓ Date 11-30-01  
✓ Use 121  
MDL  
Rear 30  
15  
Corner  
SFD

I understand and agree to the terms of this plan. I hereby grant permission to Municipal/County Representatives the right of entry to make evaluations of inspections upon this property.

Signature of Owner or Authorized Agent 1/30/02

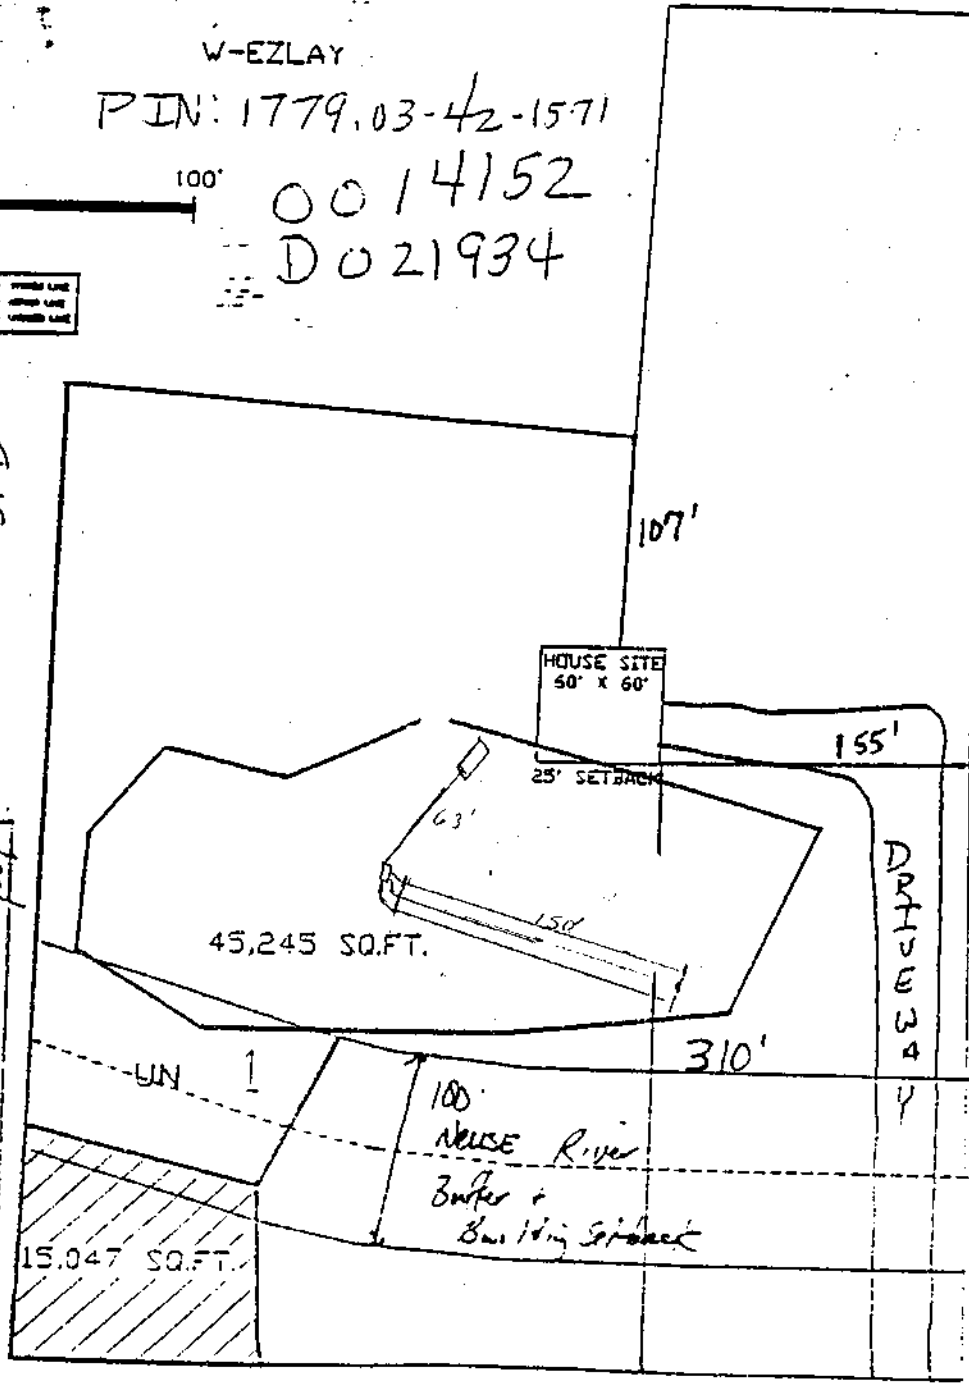

|      |                    |                                                                         |
|------|--------------------|-------------------------------------------------------------------------|
| NO.  | SCALE<br>1" = 100' | SHEET TITLE<br>LOT 1 SEPTIC SYSTEM LAYOUT                               |
| DATE | FIELD WORK         | PROJECT NAME                                                            |
| BY   | WLAN AP            | JANE STEVENS<br>HALL TOWN RD.<br>VAKE COUNTY NORTH CAROLINA<br>478 2001 |



Soil & Environmental Consultants, PA  
1010 Raven Ridge Road • Raleigh, North Carolina 27614 • Phone (919) 846-1900 • Fax (919) 846-4447  
www.SoilEC.com

11010 Raven Ridge Road • Raleigh, North Carolina 27614 • Phone: (919) 846-9900 • Fax: (919) 846-9467  
www.SaiaEC.com