

Environmental Services - Water Quality
Onsite Wastewater Scan Data Entry Form

PERMIT #: 0021890

PIN #: 0789893805

OP DATE: 01/10/2000

SYSTEM USE:

- ☒ House
☐ Mobile Home
☐ Business
☐ Other

SEWAGE TYPE:

- ☒ Domestic
☐ Industrial

PUMP/SIPHON?:

- ☐ Yes
☒ No

PRESSURE MANIFOLD:

- ☐ Yes
☒ No

SYSTEM TYPE:

- ☐ I
☒ II
☐ III
☐ IV
☐ V
☐ VI
☐ Other

SUB TYPE:

- ☒ A
☐ B
☐ C
☐ D
☐ E
☐ F
☐ G

NBR BEDROOMS:

- ☐ 1
☐ 2
☐ 3
☒ 4
☐ 5
☐ 6
☐ Other

MAINT. SCHEDULE:

- ☐ Yes
☒ No

CERT. OPERATOR

- ☐ Yes
☒ No

GT	ST	PT	SIZE
☐	☐		750
☐	☐	☐	900
☐	☐	☐	1,000
☐	☒	☐	1,200
☐	☐	☐	1,500
☐	☐	☐	1,800
☐	☐	☐	2,100
☐	☐	☐	2,500
☐	☐	☐	3,000
☐	☐	☐	4,000
☐	☐	☐	5,000
☐	☐	☐	8,000
☐	☐	☐	10,000
☐	☐	☐	Other
☒		☒	None/NA GT or PT

DRAINFIELD SIZE(SQ. FT.)

01200

DRAIN TYPE:

- ☒ Stone
☐ EZ Flow
☐ Infiltrator
☐ Biodiffuser
☐ Cultec
☐ Drip
☐ Hancor
☐ Large Dia. Pipe
☐ Multi-Pipe
☐ Other

MAX DEPTH (IN.):

- ☐ 12 in. or less
☐ 18 in. or less
☐ 24 in. or less
☐ 26 in. or less
☐ 28 in. or less
☒ 30 in. or less
☐ 32 in. or less
☐ 36 in. or less
☐ Other

STONE DEPTH (IN.):

- ☐ 8 in. or less
☒ 12 in. or less
☐ 18 in. or less
☐ 24 in. or less
☐ Other

TRENCHES:

- ☒ Individual
☐ Bed

TRENCH WIDTH (IN.):

- ☐ 12 in. or less
☐ 18 in.
☐ 24 in.
☒ 36 in.
☐ 6 ft. or less
☐ 9 ft. or less
☐ Other

DN

WAKE COUNTY HEALTH DEPARTMENT WELL AND SEWAGE SITE, LOCATION PERMIT

ALL PERMITS VOID 60 MONTHS FROM DATE OF ISSUANCE

Pin # 0789.02893805 Project # 0951322

Tax Map No. 239 Parcel No. 85

Zoning Wake Township Leesville

Owner/Contractor: William Ken Ted Garraway

Improvement Permit

Well Permit No. **C 21890**

Operation Permit []

Date: 11-18-94

Location/Address: (11505 Old Creedmoor Rd) 50N, (L) Newwood (R) Old Creedmoor



Lot on left before S/D entrance

S.R. # 1831

Subdivision Name: Black Horse Run

Lot No. 10

Section or Block No. 3

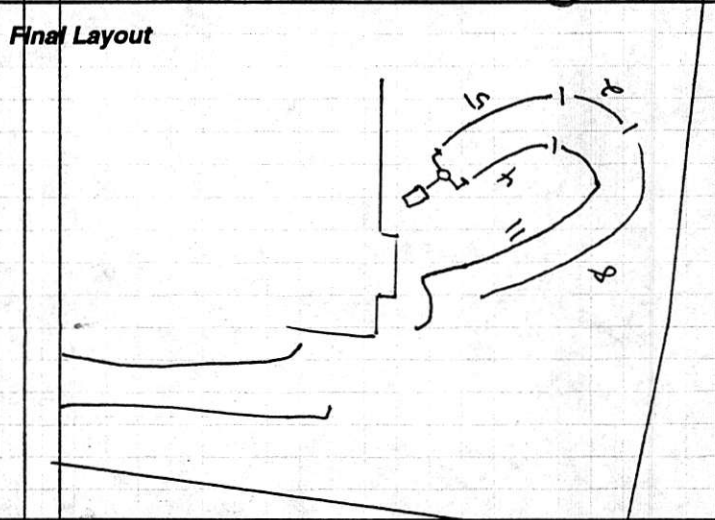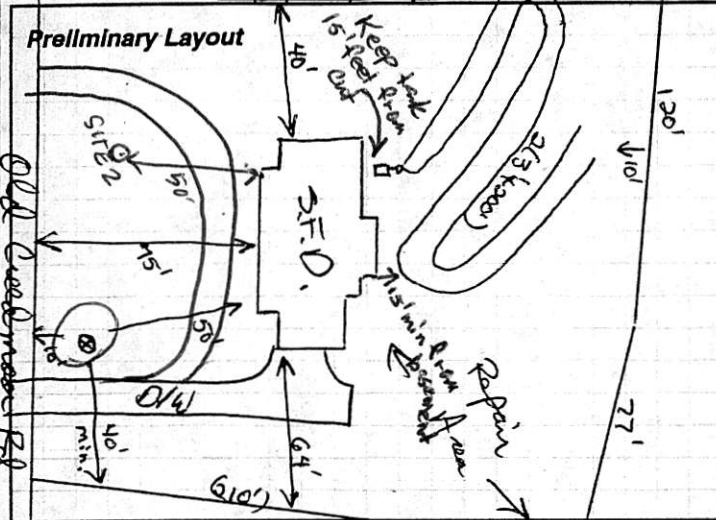

Sewage System Specifications

Repair [] Original Permit No. _____

* Garbage Disposal Unit Yes [] No [X] per owner 11-21-94

House [X] Mobile Home [] Business []

No. of Bedrooms 4 Lot Area .96

Size of Tank 1200 SRTC 12/19/98 gal.

* Comments: Keep system shallow! Place well 40' min from R.H. side property line, 50' min from House

Date: 11/21/99 Installed By: James Culley Approved By: James J. Manz R.S.

Well System

Individual [X] Semi-Public [] Public []
New [X] Replacement [] Repair []

Fee Paid: Yes [X] No []

Construction Compliance Yes [X] No []

Site Approved [X] []

Well Head Approved [X] []

Grouting Approved [X] []

Date Inspected 07-27-98 Sanitarian Martha Gregory

Bacteriological Results

Initial Sample: absent Date: 01-09-00

* Re-Sample #1 Date: _____

* Re-Sample #2 Date: _____

* Re-chlorination as required [] Yes [] No

* Fees for all resamples

All checks payable to: **Wake County Health Department**

Final Inspection

	Yes	No
Required Slab (N/A)	[X]	[]
Chlorinated	[X]	[]
Required Certificate	[]	[]
Variance (Explain)	[]	[]
WCHD I.D. Affixed <u>8692</u>	[X]	[]
Sample Collected	[X]	[]

Comments: _____

Well Installed By: Powell / Jenks

Date System Finalized 01-10-2000 Sanitarian Martha Gregory R.S.


This report is based in part on information provided by the homeowner or his/her representative in the application submitted for this permit. The sanitarian is not responsible for false or misleading information contained in the application. The sanitarian is also not responsible for concealed conditions on the property or for statements in this report that may have resulted from false or misleading statements provided to him in the application. Neither Wake County nor the sanitarian warrants that the septic tank system will continue to function satisfactorily in the future or that the water supply will remain potable.

COPY TO HEALTH DEPARTMENT

3002.017 - 5/14/93

239-85 LOT 10 BLACKHORSE RUN 0951322

1"=40'

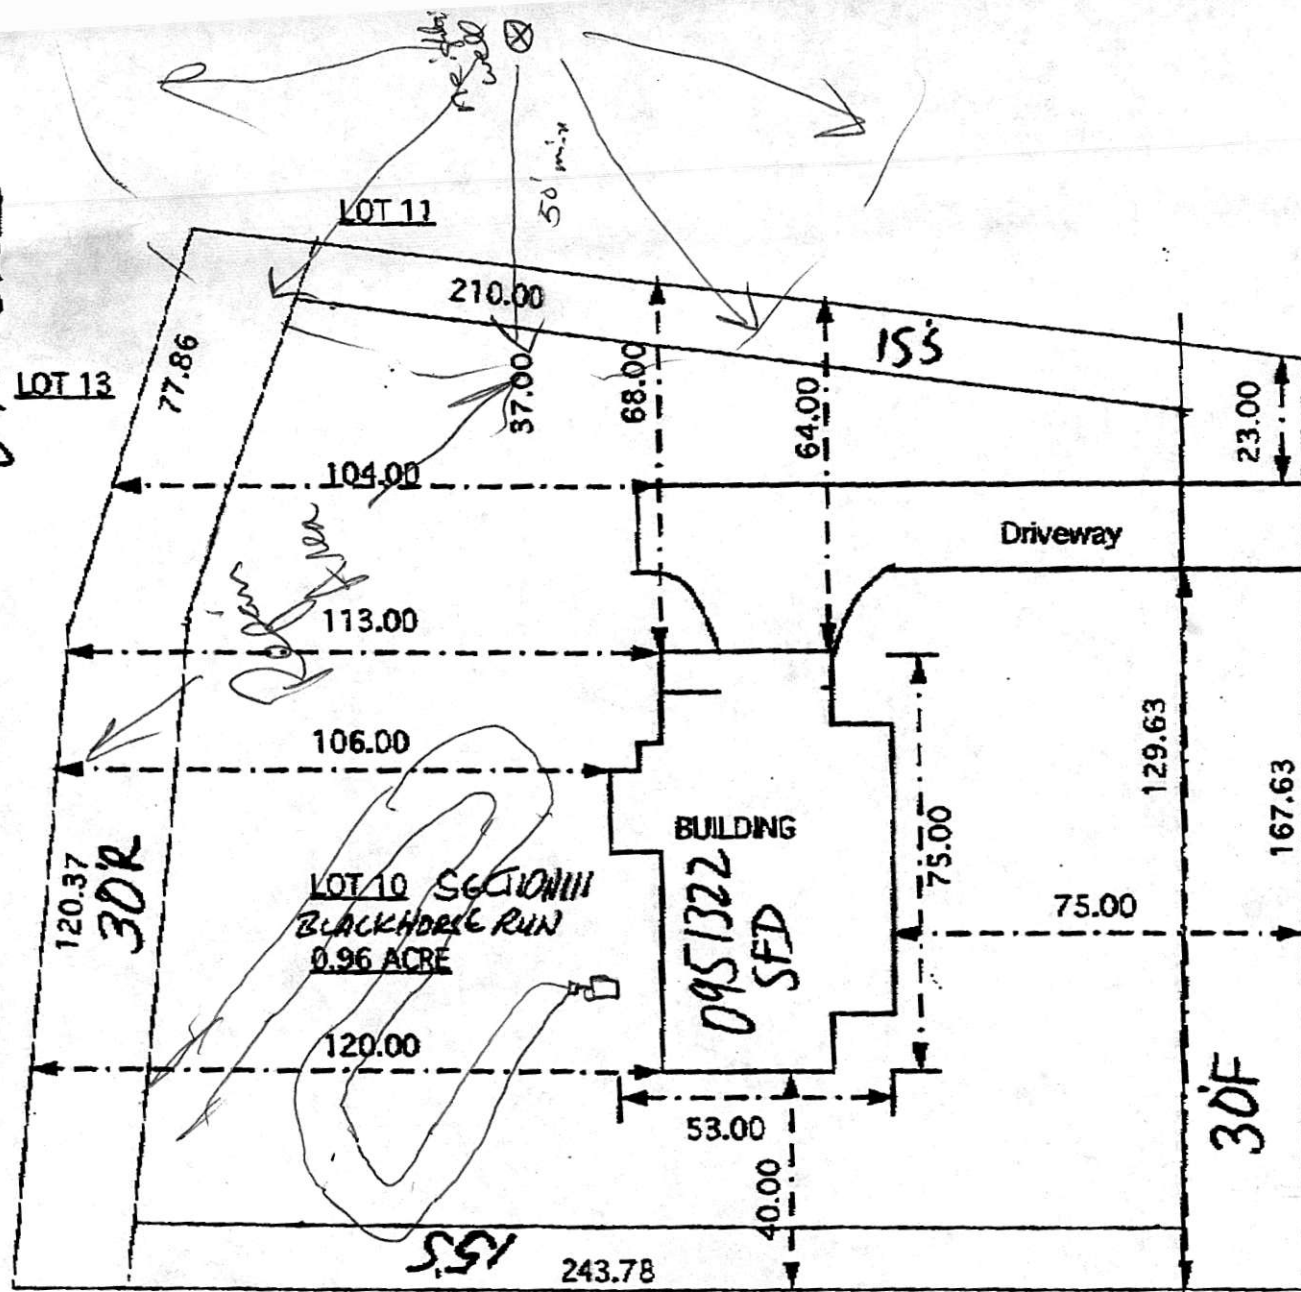

William A. Kerr
4113-102 Lake Lynn
Raleigh, NC 27613
Tel. 919 782 7729

Zoning R401H By Alvin McLean

Approved ✓ Date 10-28-94

Review ✓ Date 10-28-94

Reject ✓ Date 10-28-94

Front 30 Side 30 Corner 30

Comments:

I certify that the location of this structure is accurately shown. Failure to locate this structure in accordance with this plat plan could require relocation of the structure regardless of the degree of completion.

Signature William A. Kerr Date 10-28-94
Check one () Owner () Subcontractor () Other