

Environmental Services - Water Quality
Onsite Wastewater Scan Data Entry Form

PERMIT #: 0011643

PIN #: 2707183292

OP DATE: 0210911999

SYSTEM USE:

- ☒ House
☐ Mobile Home
☐ Business
☐ Other

SEWAGE TYPE:

- ☒ Domestic
☐ Industrial

PUMP/SIPHON?:

- ☐ Yes
☒ No

PRESSURE MANIFOLD:

- ☐ Yes
☒ No

SYSTEM TYPE:

- ☐ I
☒ II
☐ III
☐ IV
☐ V
☐ VI
☐ Other

SUB TYPE:

- ☒ A
☐ B
☐ C
☐ D
☐ E
☐ F
☐ G

NBR BEDROOMS:

- ☐ 1
☐ 2
☐ 3
☒ 4
☐ 5
☐ 6
☐ Other

MAINT. SCHEDULE:

- ☐ Yes
☒ No

CERT. OPERATOR

- ☐ Yes
☒ No

GT ST PT

- | | | | |
|-------------------------------------|-------------------------------------|-------------------------------------|------------------|
| ☐ | ☐ | ☐ | 750 |
| ☐ | ☐ | ☐ | 900 |
| ☐ | ☐ | ☐ | 1,000 |
| ☐ | ☒ | ☐ | 1,200 |
| ☐ | ☐ | ☐ | 1,500 |
| ☐ | ☐ | ☐ | 1,800 |
| ☐ | ☐ | ☐ | 2,100 |
| ☐ | ☐ | ☐ | 2,500 |
| ☐ | ☐ | ☐ | 3,000 |
| ☐ | ☐ | ☐ | 4,000 |
| ☐ | ☐ | ☐ | 5,000 |
| ☐ | ☐ | ☐ | 8,000 |
| ☐ | ☐ | ☐ | 10,000 |
| ☐ | ☐ | ☐ | Other |
| ☒ | | ☒ | None/NA GT or PT |

DRAINFIELD SIZE(SQ. FT.)

00945

W-13265

DRAIN TYPE:

- ☐ Stone
☐ EZ Flow
☒ Infiltrator
☐ Biodiffuser
☐ Cultec
☐ Drip
☐ Hancor
☐ Large Dia. Pipe
☐ Multi-Pipe
☐ Other

MAX DEPTH (IN.):

- ☐ 12 in. or less
☐ 18 in. or less
☒ 24 in. or less
☐ 26 in. or less
☐ 28 in. or less
☐ 30 in. or less
☐ 32 in. or less
☐ 36 in. or less
☐ Other

STONE DEPTH (IN.):

- ☐ 8 in. or less
☒ 12 in. or less
☐ 18 in. or less
☐ 24 in. or less
☐ Other

TRENCHES:

- ☒ Individual
☐ Bed

TRENCH WIDTH (IN.):

- ☐ 12 in. or less
☐ 18 in.
☐ 24 in.
☒ 36 in.
☐ 6 ft. or less
☐ 9 ft. or less
☐ Other

B.W 11/18/13

WAKE COUNTY DEPARTMENT OF ENVIRONMENTAL SERVICES WELL AND SEWAGE SITE LOCATION PERMIT

NO PERMIT(S) FOR CONSTRUCTION, LOCATION OR RELOCATION ACTIVITY SHALL BE ISSUED

UNTIL AN AUTHORIZATION FOR WASTEWATER SYSTEM CONSTRUCTION HAS BEEN ISSUED

PERMIT VOID IF NOT IN COMPLIANCE WITH ZONING REGULATIONS AND/ OR IF SITE IS ALTERED OR INTENDED USE CHANGED

PERMIT#: D011643 STATUS: A APP DATE: 08/18/1998 BLDG PERMIT#: 0990643
 APPLICANT: OLDE HERITAGE BLDR DAY PHONE: (919) 269 - 4555
 ADDRESS: 1006 N ARENDELL AVE FAX#: (919) 269 - 9445
 CITY: ZEBULON STATE: NC ZIP: 27597
 OWNER: OLDE HERITAGE BUILDERS & DAY PHONE: (999) 999 - 9999
 ADDRESS: 1006 N ARENDELL AVE FAX#: (999) 999 - 9999
 CITY: ZEBULON STATE: NC ZIP: 27597
 HD USE CD: 101 ONE-FAMILY HOUSE ORIG PERMIT#: REC?: Y
 EXIST USE: TAX MAP#: 0338
 BEDROOMS: 4 BSMT: N #EMPLOYEES: 0 WATER: I WASTEWATER: I GARB DISPOSAL: N
 TOWNSHIP: 09 LITTLE RIVER JURIS: WC ZON: R30 PIN: 2707.01 18 3292 000
 SUBD#: S 000 000 00 SUBD NAME: LOT-SEC: ACRE: 1.95
 IMPRV PRMT: ISSUED?: Y DATE: 09/24/1998 BY: RJD TYPE SYSTEM: II PUMP:
 CNSTR AUTH: ISSUED?: Y DATE: 09/24/1998 BY: RJD M/O:
 RECEIPT#: FEE: 290.00 OP DATE: BY:
 WATR SAMPL: REQ?: Y APPROVED?: DATE: PROPRIETARY SYS:
 ST#: 3728 MI: DIR: NAME: COUNTRY CLUB DIR: TYP: RD
 DIRECTIONS: NC96 OUT OF ZEBULON-RT PEARSON RD-LFT DUKES LAK
 E-RT COUNTRY CLUB RD -HSE 1/2 MI RT

IMPROVEMENT PERMIT

SIZE OF TANK 1200 ST PT GALS. TOTAL SQ. FT. 1260 DEPTH OF STONE 12 IN. MAX. DEPTH LINE 24 IN.

WASTEWATER: DOMESTIC ☒ INDUSTRIAL ☐

I.P. ISSUED BY

Ron Dudley R.S.

AUTHORIZATION FOR WASTEWATER SYSTEM CONSTRUCTION

VOID SIXTY (60) MONTHS FROM DATE OF ISSUANCE

AUTHORIZATION CONDITIONS

Contractor To Follow Contours, See Attached Site Plan For Wastewater System Design And Well Location. The wastewater system shall not be covered or placed into use until inspected by the Wake County Department of Environmental Services and an Operation Permit issued.

OTHER CONDITIONS:

SIZE OF TANK 1200 ST PT GALS. TOTAL SQ. FT. 1260 DEPTH OF STONE 12 IN. MAX. DEPTH LINE 24 IN.
 ST FILTER REQUIRED ☒ NUMBER OF TRENCHES 3 LENGTH OF TRENCHES 140 FT. WIDTH OF TRENCHES 3 FT.

C.A. ISSUED BY *Ron Dudley R.S.* INSTALLED BY *Brantley* CTR. I.D. #
 SEPTIC TANK FILTER USED *2182*
 INNOV. APPL. #: IWWS- DATE *2/9/99* INSTALLATION APPROVED BY *Glenn*

WELL SYSTEM = PRIVATE ☒ SEMI-PUBLIC ☐ NEW ☐ REPLACEMENT ☐ EXISTING ☐

WELL LOG INFORMATION = DEPTH 340' CASING DEPTH 50' YIELD 3gpm STATIC LEVEL 20'
 WELL CONTRACTOR *Lowndes* REG.# PUMP CONTRACTOR *American P.P.* REG.# 1822

CONSTRUCTION COMPLIANCE = GROUT APPROVED ☒ DATE 11/18/98 EHS *Joe Z. Wren* (partial)
 8789 WCHD ID # 182 WELLHEAD APPROVED ☐ DATE 5/15/99 EHS *Joe Z. Wren*
 NEGATIVE BACTERIOLOGICAL RESULTS ☒ DATE 5/15/99 EHS *Joe Z. Wren*
 SYSTEM FINALIZED ☒ DATE 5/23/99 EHS *Joe Z. Wren*

COMMENTS:

 This permit is based in part on information provided by the homeowner or his/her representative in the application submitted for this permit. The Environmental Health Specialist is not responsible for false or misleading information contained in the application. The Environmental Health Specialist is also not responsible for concealed conditions on the property or for statements in this report that may have resulted from false or misleading statements provided to him in the application. Neither Wake County nor the Environmental Health Specialist warrants that the septic tank system will continue to function satisfactorily in the future or that the water supply will remain potable.

Pin 270701 18 3292

I certify that the location of this structure is accurately shown. Failure to locate this structure in accordance with this plot plan could require relocation of the structure regardless of its degree of completion.

Signature _____ Date _____
 Check one () Owner () Builder/Contractor: () Other




Reading R-30 By Challand
 Approve _____ Date 8/18/98
 Revise _____ Use LOT
 Just _____ MBL _____
 Front 70 Rear 30
 Side 10 Corner _____

Orange card given
 sent to engineering

Zelken NC 27597

#990643 3728 Country Club Rd 25

D011643

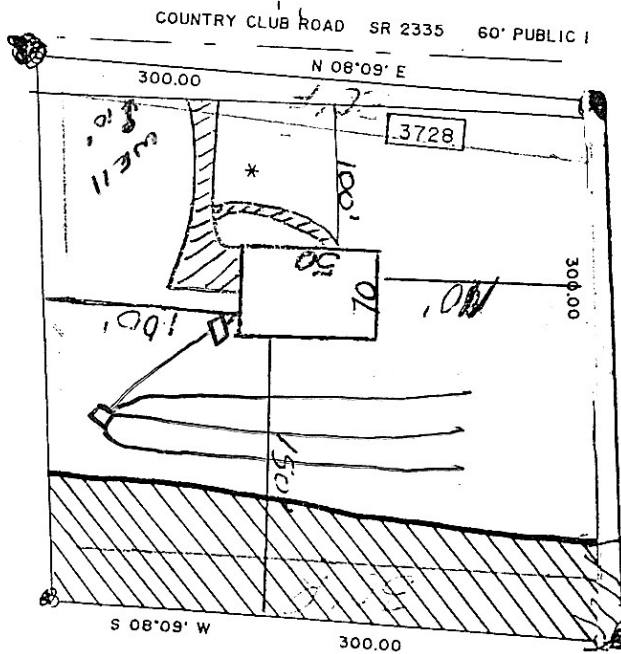

Sheet 3

1" = 100'

Chadley
 Old Highway Builders

