

Environmental Services - Water Quality
Onsite Wastewater Scan Data Entry Form

PERMIT #: **C 0 0 6 0 8 2**

PIN #: **2 7 0 7 5 6 2 6 0 5**

OP DATE: **0 9 / 0 5 / 1 9 9 1**

SYSTEM USE:

- ☒ House
☐ Mobile Home
☐ Business
☐ Other

SEWAGE TYPE:

- ☒ Domestic
☐ Industrial

PUMP/SIPHON?:

- ☐ Yes
☒ No

PRESSURE MANIFOLD:

- ☐ Yes
☒ No

SYSTEM TYPE:

- ☐ I
☒ II
☐ III
☐ IV
☐ V
☐ VI
☐ Other

SUB TYPE:

- ☒ A
☐ B
☐ C
☐ D
☐ E
☐ F
☐ G

NBR BEDROOMS:

- ☐ 1
☐ 2
☒ 3
☐ 4
☐ 5
☐ 6
☐ Other

MAINT. SCHEDULE:

- ☐ Yes
☒ No

CERT. OPERATOR

- ☐ Yes
☒ No

GT ST PT SIZE

- | | | | |
|--------------------------|-------------------------------------|--------------------------|------------------|
| ☐ | ☐ | ☐ | 750 |
| ☐ | ☐ | ☐ | 900 |
| ☐ | ☒ | ☐ | 1,000 |
| ☐ | ☐ | ☐ | 1,200 |
| ☐ | ☐ | ☐ | 1,500 |
| ☐ | ☐ | ☐ | 1,800 |
| ☐ | ☐ | ☐ | 2,100 |
| ☐ | ☐ | ☐ | 2,500 |
| ☐ | ☐ | ☐ | 3,000 |
| ☐ | ☐ | ☐ | 4,000 |
| ☐ | ☐ | ☐ | 5,000 |
| ☐ | ☐ | ☐ | 8,000 |
| ☐ | ☐ | ☐ | 10,000 |
| ☐ | ☐ | ☐ | Other |
| ☐ | ☐ | ☐ | None/NA GT or PT |

DRAINFIELD SIZE(SQ. FT.)

0 1 1 0 0

DRAIN TYPE:

- ☒ Stone
☐ EZ Flow
☐ Infiltrator
☐ Biodiffuser
☐ Cultec
☐ Drip
☐ Hancor
☐ Large Dia. Pipe
☐ Multi-Pipe
☐ Other

MAX DEPTH (IN.):

- ☐ 12 in. or less
☐ 18 in. or less
☐ 24 in. or less
☒ 26 in. or less
☐ 28 in. or less
☐ 30 in. or less
☐ 32 in. or less
☐ 36 in. or less
☐ Other

STONE DEPTH (IN.):

- ☐ 8 in. or less
☒ 12 in. or less
☐ 18 in. or less
☐ 24 in. or less
☐ Other

TRENCHES:

- ☒ Individual
☐ Bed

TRENCH WIDTH (IN.):

- ☐ 12 in. or less
☐ 18 in.
☐ 24 in.
☒ 36 in.
☐ 6 ft. or less
☐ 9 ft. or less
☐ Other

2707562605

WAKE COUNTY HEALTH DEPARTMENT WELL AND SEWAGE SITE LOCATION PERMIT

Tax Map No. 339 Parcel No. 36 No. C 06082

Contractor: _____ Operation Permit []

Owner: William H. West, Jr. Date: 9-22-88

Location/Address: 19424 Northmanor

Subdivision Name: Northmanor Lot No. 11 Section or Block No. 1001

Zoning: Wake Township: Little River 10/5 discuss applic location 1/11/88 REVISED DRP


Sewage System

Repair [] Original Permit No. _____
 Garbage Disposal Unit Yes [] No [x]
 House [x] Mobile Home [] Business []
 No. Bedrooms 3 Lot Area 3.03
 Size of Tank 1000 gal.
 Nitrification Line 3 lines (3x123) 1100 sq. ft.
 Depth of Stone: 12" [x] Max. Depth of Trenches: 26 in.
 Riser and Baffle Required [x] Pump Required []

Improvement Permit

*Permit Void 36 months from date of Issuance
 *Permit Void if not in compliance with zoning regulations
 *Permit may be voided if site alterations made

Layout By: D.R. Parnell Jr.

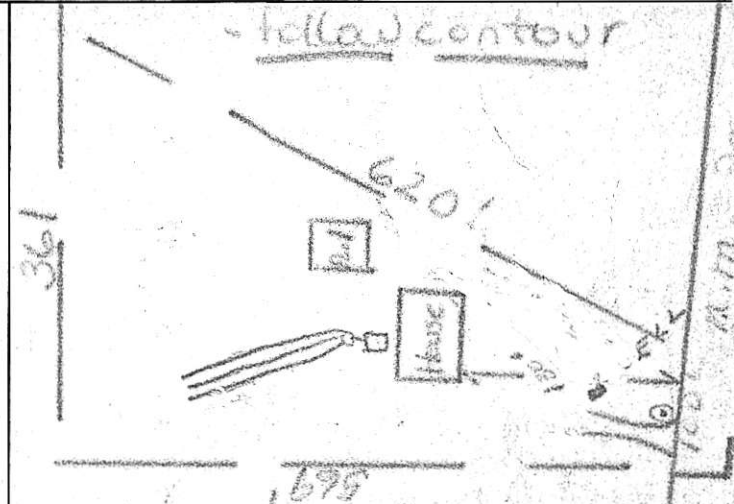

9-5-91

Date

Bobby DRIVER

Installed By

Kon Dudley

Approved By

Well System

Individual [x] Semi-Public [] Public []
 New [x] Replacement [] Repair []
 Fee Paid Yes [x] No []
 Construction Compliance Yes No
 Site Approved [x] []
 Well Head Approved [x] []
 Grouting Approved [x] []

5-10-94

Date Inspected

U.F.O. R.S.

Sanitarian

Final Inspection Yes No
 Required Slab [x] []
 Chlorinated [x] []
 Required Certificate [x] []
 Variance (Explain) [x] []
 WCHD I.D. Affixed # 4544 [x] []
 Sample Collected [x] []

**Well permit void 36 months from issuance date

Bacteriological Results

Initial Sample: 1159 Date: 6-27-94
 *Re-sample #1 _____ Date: _____
 *Re-sample #2 _____ Date: _____
 Re-chlorination as required Yes [] No []
 Comments: _____

*\$10.00 fee for all re-samples

All checks payable to: **Wake County Health Department**

Well Installed By: DAVIS WELL


6-28-94

Date System Finalized

U.F.O. R.S.

Sanitarian

This report is based in part on information provided by the homeowner or his/her representative in the application submitted for this permit. The sanitarian is not responsible for false or misleading information contained in the application. The sanitarian is also not responsible for concealed conditions of the property or for statements in this report that may have resulted from false or misleading statements provided to him in the application. Neither Wake County nor the sanitarian warrants that the septic tank system will continue to function satisfactorily in the future or that the water supply will remain potable.

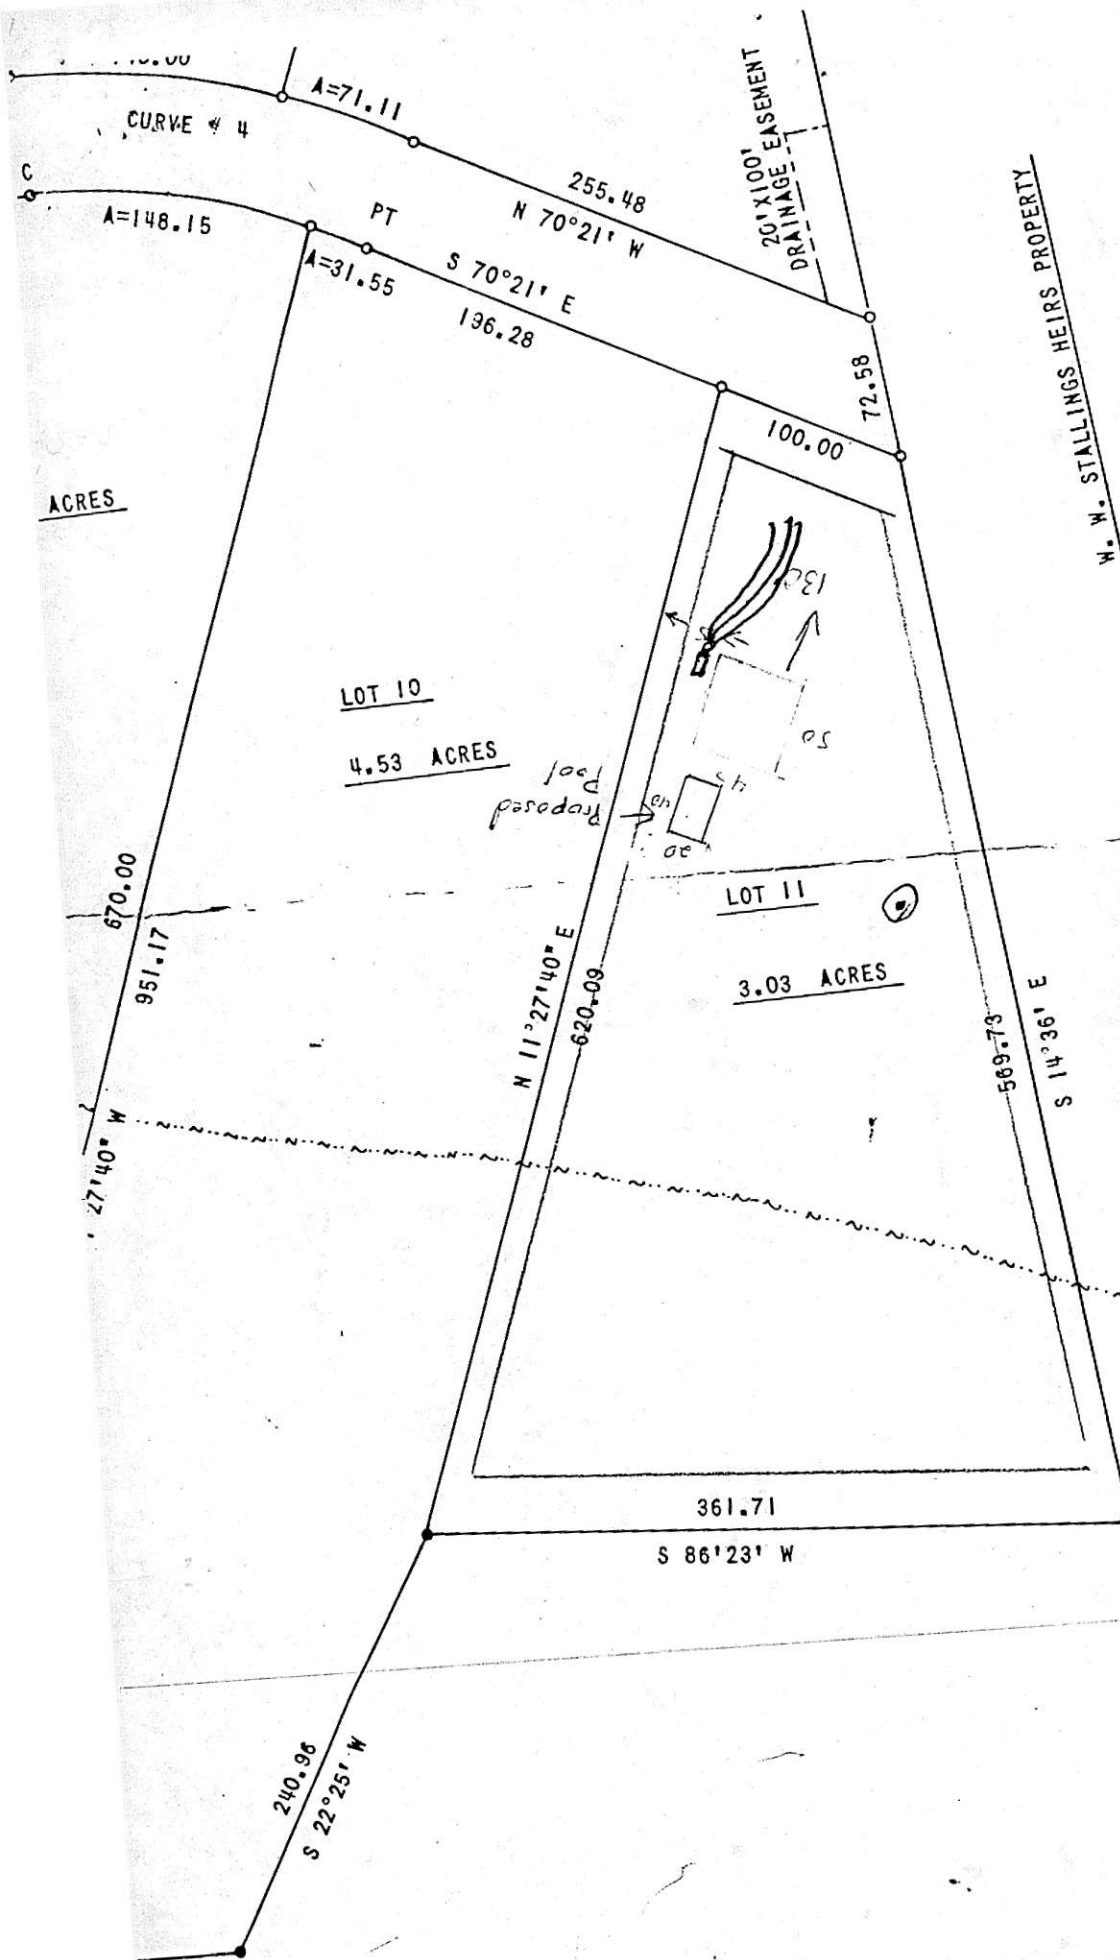

This is not a site plan until the proposed structure and any other existing structures are accurately drawn in to scale. Indicate the distances to the nearest property lines, lot dimensions and driveway.

