

Environmental Services - Water Quality
Onsite Wastewater Scan Data Entry Form

PERMIT #: 0013638

PIN #: 1782079040

OP DATE: 0912211992

SYSTEM USE:

- ☒ House
☐ Mobile Home
☐ Business
☐ Other

SEWAGE TYPE:

- ☒ Domestic
☐ Industrial

PUMP/SIPHON?:

- ☐ Yes
☒ No

PRESSURE MANIFOLD:

- ☐ Yes
☒ No

SYSTEM TYPE:

- ☐ I
☒ II
☐ III
☐ IV
☐ V
☐ VI
☐ Other

SUB TYPE:

- ☒ A
☐ B
☐ C
☐ D
☐ E
☐ F
☐ G

NBR BEDROOMS:

- ☐ 1
☐ 2
☒ 3
☐ 4
☐ 5
☐ 6
☐ Other

MAINT. SCHEDULE:

- ☐ Yes
☒ No

CERT. OPERATOR

- ☐ Yes
☒ No

GT ST PT

- ☐ ☐ ☐
☐ ☐ ☐
☐ ☒ ☐
☐ ☐ ☐
☐ ☐ ☐
☒ ☐ ☒

SIZE

- 750
900
1,000
1,200
1,500
1,800
2,100
2,500
3,000
4,000
5,000
8,000
10,000
Other
None/NA GT or PT

DRAINFIELD SIZE(SQ. FT.)

01920

DRAIN TYPE:

- ☒ Stone
☐ EZ Flow
☐ Infiltrator
☐ Biodiffuser
☐ Cultec
☐ Drip
☐ Hancor
☐ Large Dia. Pipe
☐ Multi-Pipe
☐ Other

MAX DEPTH (IN.):

- ☐ 12 in. or less
☐ 18 in. or less
☒ 24 in. or less
☐ 26 in. or less
☐ 28 in. or less
☐ 30 in. or less
☐ 32 in. or less
☐ 36 in. or less
☐ Other

STONE DEPTH (IN.):

- ☐ 8 in. or less
☒ 12 in. or less
☐ 18 in. or less
☐ 24 in. or less
☐ Other

TRENCHES:

- ☒ Individual
☐ Bed

TRENCH WIDTH (IN.):

- ☐ 12 in. or less
☐ 18 in.
☐ 24 in.
☒ 36 in.
☐ 6 ft. or less
☐ 9 ft. or less
☐ Other

WAKE COUNTY HEALTH DEPARTMENT WELL AND SEWAGE SITE, LOCATION

ALL PERMITS VOID 60 MONTHS FROM DATE OF ISSUANCE

Tax Map No. 616 Parcel No. 83

Improvement Permit
Well Permit No. **C 13638**

Zoning Wake Township Marks Creek

Operation Permit []

Owner/Contractor: Heritage Construction Co.

Date: 1-30-92

Location/Address: 7317 Hunt Valley Tr: 64E TR 1003 TR Hunt Valley Tr
3rd on R.


S.R. # 1003

Subdivision Name: Stewarts Ridge

Lot No. 67

Section or Block No. _____

Preliminary Layout

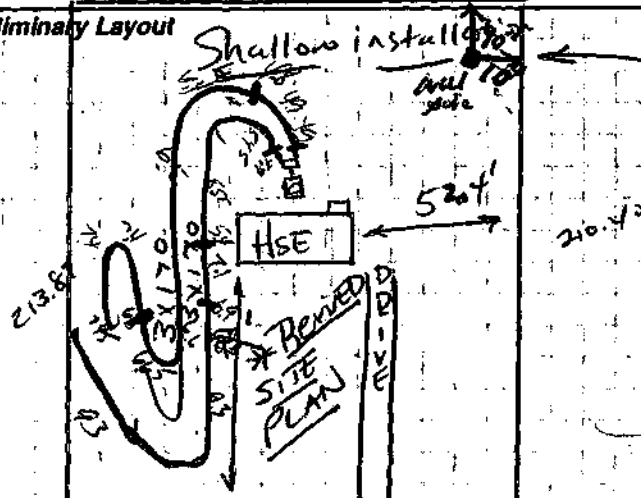

Final Layout

Well site is to be 10' off back
and side property lines as shown
in diagram.

Sewage System Specifications

Repair [] Original Permit No. _____

Garbage Disposal Unit Yes [] No ☒

House ☒ Mobile Home [] Business []

No. of Bedrooms 3 Lot Area _____

Size of Tank 1000 7-14-90 gal.

Comments: Shallow placed conventional system.

Nitrification Line 2 x (3' x 170') sq. ft.

Depth of Stone: 12" ☒ Max Depth of Trenches: 24 in.

Riser and Baffle Required ☒ Pump Required []

Permit void if not in compliance with zoning regulations

Permits may be voided if site is altered or intended use changed

Layout by: Andre C. Preece

Date: Sept. 22, 1992 Installed By: Rusty Phillips Approved By: Andre C. Preece, R.S.

Individual [] Well System
New [] Semi-Public []
Fee Paid: Yes [] Replacement []
Construction Compliance Yes [] No []
Site Approved []
Well Head Approved []
Grouting Approved []

Date Inspected _____

Sanitarian _____

Bacteriological Results

Initial Sample: _____ Date: _____

* Re-Sample #1 _____ Date: _____

* Re-Sample #2 _____ Date: _____

* Re-chlorination as required [] Yes [] No

* Fees for all resamples

All checks payable to: Wake County Health Department

Final Inspection Yes No

Required Slab [] []

Chlorinated [] []

Required Certificate [] []

Variance (Explain) [] []

WCHD I.D. Affixed [] []

Sample Collected [] []

Comments: _____

Well Installed By: _____

Date System Finalized _____

Sanitarian _____

This report is based in part on information provided by the homeowner or his/her representative in the application submitted for this permit. The sanitarian is not responsible for false or misleading information contained in the application. The sanitarian is also not responsible for concealed conditions on the property or for statements in this report that may have resulted from false or misleading statements provided to him in the application. Neither Wake County nor the sanitarian warrants that the septic tank system will continue to function satisfactorily in the future or that the water supply will remain potable.

COPY TO HEALTH DEPARTMENT