

Environmental Services - Water Quality
Onsite Wastewater Scan Data Entry Form

PERMIT #: **B 0 2 2 5 7 1**

PIN #: **1 7 8 5 5 7 1 2 4 1**

OP DATE: **0 7 / 2 8 / 1 9 8 2**

SYSTEM USE:

- ☒ House
☐ Mobile Home
☐ Business
☐ Other

SEWAGE TYPE:

- ☒ Domestic
☐ Industrial

PUMP/SIPHON?:

- ☐ Yes
☒ No

PRESSURE MANIFOLD:

- ☐ Yes
☒ No

SYSTEM TYPE:

- ☐ I
☒ II
☐ III
☐ IV
☐ V
☐ VI
☐ Other

SUB TYPE:

- ☒ A
☐ B
☐ C
☐ D
☐ E
☐ F
☐ G

NBR BEDROOMS:

- ☐ 1
☐ 2
☒ 3
☐ 4
☐ 5
☐ 6
☐ Other

MAINT. SCHEDULE:

- ☐ Yes
☒ No

CERT. OPERATOR

- ☐ Yes
☒ No

GT ST PT

- | | | | |
|-------------------------------------|-------------------------------------|-------------------------------------|------------------|
| ☐ | ☐ | ☐ | 750 |
| ☐ | ☒ | ☐ | 900 |
| ☐ | ☐ | ☐ | 1,000 |
| ☐ | ☐ | ☐ | 1,200 |
| ☐ | ☐ | ☐ | 1,500 |
| ☐ | ☐ | ☐ | 1,800 |
| ☐ | ☐ | ☐ | 2,100 |
| ☐ | ☐ | ☐ | 2,500 |
| ☐ | ☐ | ☐ | 3,000 |
| ☐ | ☐ | ☐ | 4,000 |
| ☐ | ☐ | ☐ | 5,000 |
| ☐ | ☐ | ☐ | 8,000 |
| ☐ | ☐ | ☐ | 10,000 |
| ☐ | ☐ | ☐ | Other |
| ☒ | ☐ | ☒ | None/NA GT or PT |

DRAINFIELD SIZE(SQ. FT.)

0 1 0 0 2

DRAIN TYPE:

- ☒ Stone
☐ EZ Flow
☐ Infiltrator
☐ Biodiffuser
☐ Cultec
☐ Drip
☐ Hancor
☐ Large Dia. Pipe
☐ Multi-Pipe
☐ Other

MAX DEPTH (IN.):

- ☐ 12 in. or less
☐ 18 in. or less
☐ 24 in. or less
☐ 26 in. or less
☐ 28 in. or less
☐ 30 in. or less
☐ 32 in. or less
☐ 36 in. or less
☒ Other

STONE DEPTH (IN.):

- ☐ 8 in. or less
☒ 12 in. or less
☐ 18 in. or less
☐ 24 in. or less
☐ Other

TRENCHES:

- ☐ Individual
☒ Bed

TRENCH WIDTH (IN.):

- ☐ 12 in. or less
☐ 18 in.
☐ 24 in.
☐ 36 in.
☒ 6 ft. or less
☐ 9 ft. or less
☐ Other

NAC

WAKE COUNTY HEALTH DEPARTMENT SEPTIC TANK LAYOUT AND PERMIT

1785 57 1241

TAX MAP NO. 447 PARCEL NO. 48(5)

PERMIT NO. B 22571

CONTRACTOR DRIVER REALTY

OWNER _____

DATE 5/4/82

LOCATION Go 64 onto 97 Left on 42329

S. R. NO. #2329

SUBDIVISION NAME _____ LOT NO. _____ SECTION OR BLOCK NO. _____

REPAIR ☐ ORIGINAL PERMIT NO. _____

GARBAGE DISPOSAL UNIT YES ☐ NO ☒

HOUSE ☒ MOBILE HOME ☐ BUSINESS ☐

NO. BEDROOMS 3 BR LOT AREA 40,000

SIZE OF TANK 900 gal.

NITRIFICATION LINE 1002/167X6 sq. ft.


DEPTH OF STONE IN LINES: 12" ☐ 18" ☐

RISER AND BAFFLE REQUIRED ☐ PUMP REQUIRED ☐

WATER SUPPLY: INDIVIDUAL ☐ PUBLIC ☐ OTHER ☐

- * PERMIT VOID 36 MONTHS FROM DATE OF ISSUANCE.
- * PERMIT VOID IF NOT IN COMPLIANCE WITH ZONING REGULATIONS
- * PERMIT MAY BE VOIDED IF SITE ALTERATIONS MADE

LAYOUT BY Robert Hays

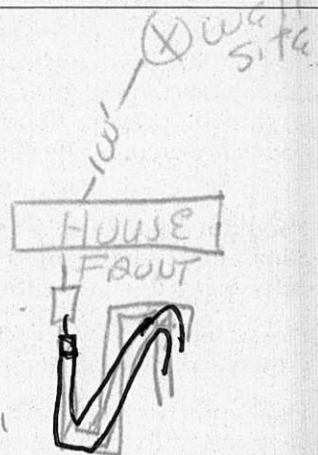

DATE 7/28/82
7/29/82

INSTALLED BY Edie Driver

APPROVED BY Robert Hays