


WAKE COUNTY DEPARTMENT OF ENVIRONMENTAL SERVICES WELL AND SEWAGE SITE LOCATION PERMIT
NO PERMIT(S) FOR CONSTRUCTION, LOCATION OR RELOCATION ACTIVITY SHALL BE ISSUED
UNTIL AN AUTHORIZATION FOR WASTEWATER SYSTEM CONSTRUCTION HAS BEEN ISSUED
PERMIT VOID IF NOT IN COMPLIANCE WITH ZONING REGULATIONS AND/ OR IF SITE IS ALTERED OR INTENDED USE CHANGED

PERMIT#: D025802 STATUS: A APP. DATE: 11/18/2002 BLDG. PERMIT#: 0031252
PIN: 1752.04 70 4959 000 TAX MAP: 0639 0000 RECORDED: Y ORIG. PERMIT#:
TOWNSHIP: 10 MARKS CREEK JURISDICTION: WC ZONING: R30
APPLICANT: CAPPS & ASSOCIATES
2901 DEER MANOR DR
RALEIGH, NC 27616
(919) 669 - 9207
USE: HD USE: 101 ONE-FAMILY HOUSE
EXIST USE:
DISPOSAL: BEDROOMS: 4 BASEMENT: Y #EMPLOYEES: 0 FOUND DRAIN: N
SITE: ADDRESS: 4613 CROSS BROOK LA
SUBDIVISION: MIAL PLANTATION LOT: 9 ACRES: 3.43
DIRECTION: POOLE RD E R GRASSHOPPER R BETHLEHEM L CROSS BR
OOK LN

IMPROVEMENT PERMIT

TANK SIZE: 1200 gal. PUMP Tank: 1200 gal. SQ FT: 1200 INNOVATIVE MAX DEPTH LINE: 18 in.
WASTEWATER: INDIVIDUAL SEWAGE: DOMESTIC TYPE SYSTEM: III G PUMP: Y P/M: N
DAILY FLOW: 480 gal/day DESIGN FEE REQ?: Y PAID?: Y WATER: COMMUNITY

COMMENTS:

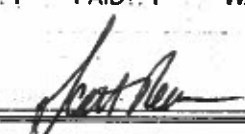IP ISSUED? Y DATE 01/09/2003 BY: (SCR)  PHONE#: 857-9355


AUTHORIZATION FOR WASTEWATER/WATER SYSTEM CONSTRUCTION

VOID SIXTY (60) MONTHS FROM DATE OF ISSUANCE

AUTHORIZATION CONDITIONS:

Contractors shall install system on contours, see attached site plan for wastewater system design and well location. No underground utilities, water lines or sprinkler systems may be located in the original system or repair areas. A septic tank filter with a riser for access is required. The wastewater system shall not be covered or placed into use until inspected by the Wake County Department of Environmental Services and an Operation Permit issued. **OTHER CONDITIONS:**
INITIAL SYSTEM PUMP TO 4 100' EZFLOW DRAIN LINES. CONTRACTOR MUST FOLLOW LAY OUT IN FIELD. TOP LINE STARTS APP. 125' FROM BACK RIGHT PROPERTY CORNER AS SHOWN ON SITE PLAN. 25% REDUCTION ALREADY TAKEN. REPAIR WILL REQUIRE PUMP SYSTEM TO AREA IN FRONT OF LOT. KEEP TANKS MIN. 15' FROM BASEMENT. CALL OFFICE WITH ANY QUESTIONS.

TANK SIZE: 1200 gal. PUMP TANK: 1200 gal. SQ FT: 1200 INNOVATIVE MAX DEPTH LINE: 18 in.
MAINT: N OPER: N L/O: Y TRENCH#: 4 LENGTH: 100 ft. WIDTH: 36 in. DESIGNER:
SUBFIELDS: _ DESIGN HEAD PRESSURE: _ DESIGN FLOW: _ gal/min DOSE VOLUME: _ gal.

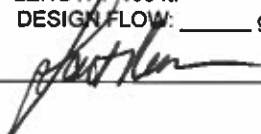CA ISSUED? Y DATE: 01/09/2003 BY: (SCR)  PHONE#: 857-9355

WAKE COUNTY DEPARTMENT OF ENVIRONMENTAL SERVICES WELL AND SEWAGE SITE LOCATION PERMIT
NO PERMIT(S) FOR CONSTRUCTION, LOCATION OR RELOCATION ACTIVITY SHALL BE ISSUED
UNTIL AN AUTHORIZATION FOR WASTEWATER SYSTEM CONSTRUCTION HAS BEEN ISSUED
PERMIT VOID IF NOT IN COMPLIANCE WITH ZONING REGULATIONS AND/ OR IF SITE IS ALTERED OR INTENDED USE CHANGED

PERMIT#: D025802 STATUS: A APP. DATE: 11/18/2002 BLDG. PERMIT#: 0031252
PIN: 1752.04 70 4959 000 TAX MAP: 0639 0000 RECORDED: Y ORIG. PERMIT#:
TOWNSHIP: 10 MARKS CREEK JURISDICTION: WC ZONING: R30
APPLICANT: CAPPS & ASSOCIATES
2901 DEER MANOR DR
RALEIGH, NC 27616
(919) 669 - 9207
USE: HD USE: 101 ONE-FAMILY HOUSE
EXIST USE:
DISPOSAL: BEDROOMS: 4 BASEMENT: Y #EMPLOYEES: 0
SITE: ADDRESS: 4613 CROSS BROOK LA
SUBDIVISION: MIAL PLANTATION LOT: 9 ACRES: 3.43
DIRECTION: POOLE RD E R GRASSHOPPER R BETHLEHEM L CROSS BR
OOK LN

Well System: WATER: COMMUNITY - TYPE: EXISTING

WELL LOG INFORMATION: DEPTH: _____ CASING DEPTH: _____ YIELD: _____ STATIC LEVEL: _____
WELL CONTRACTOR: _____ REG.# _____ PUMP CONTRACTOR: _____ REG.# _____
Construction Compliance GROUT APPROVED ☐ DATE _____ EHS _____
WELLHEAD APPROVED ☐ DATE _____ EHS _____
SYSTEM FINALIZED ☐ DATE _____ EHS _____

COMMENTS:

Operation Permit


DESIGN FLOW: _____ gal./min. ACTUAL FLOW: _____ INNOVATIVE LETTER: R

INSTALLED BY: Quality Landscape INSTALLATION APPROVED BY: [Signature]
PROPRIETARY SYSTEM: _____ FILTER NO. _____
COMMENTS:

OPERATIONS PERMIT ISSUED? Y OP DATE: 7/16/2003 BY: C. Eubanks [Signature]

This permit is based in part on information provided by the homeowner or his/her representative in the application submitted for this permit. The Environmental Health Specialist is not responsible for false or misleading information contained in the application. The Environmental Health Specialist is also not responsible for concealed conditions on the property or for statements in this report that may have resulted from false or misleading statements provided to him in the application. Neither Wake County nor the Environmental Health Specialist warrants that the septic tank system will continue to function satisfactorily in the future or that the water supply will remain potable.


BE	RADIUS	LENGTH	CHORD	CH.BEARING
-1	50.00'	52.36'	50.00'	S 82°52'48"W

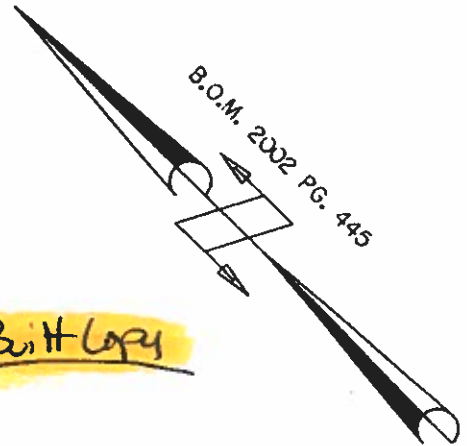

As Built Copy

S.T.
Mills-1200
STB-857
5-2-03

P.T.
Mills-1200
P.T.-120
5-6-03

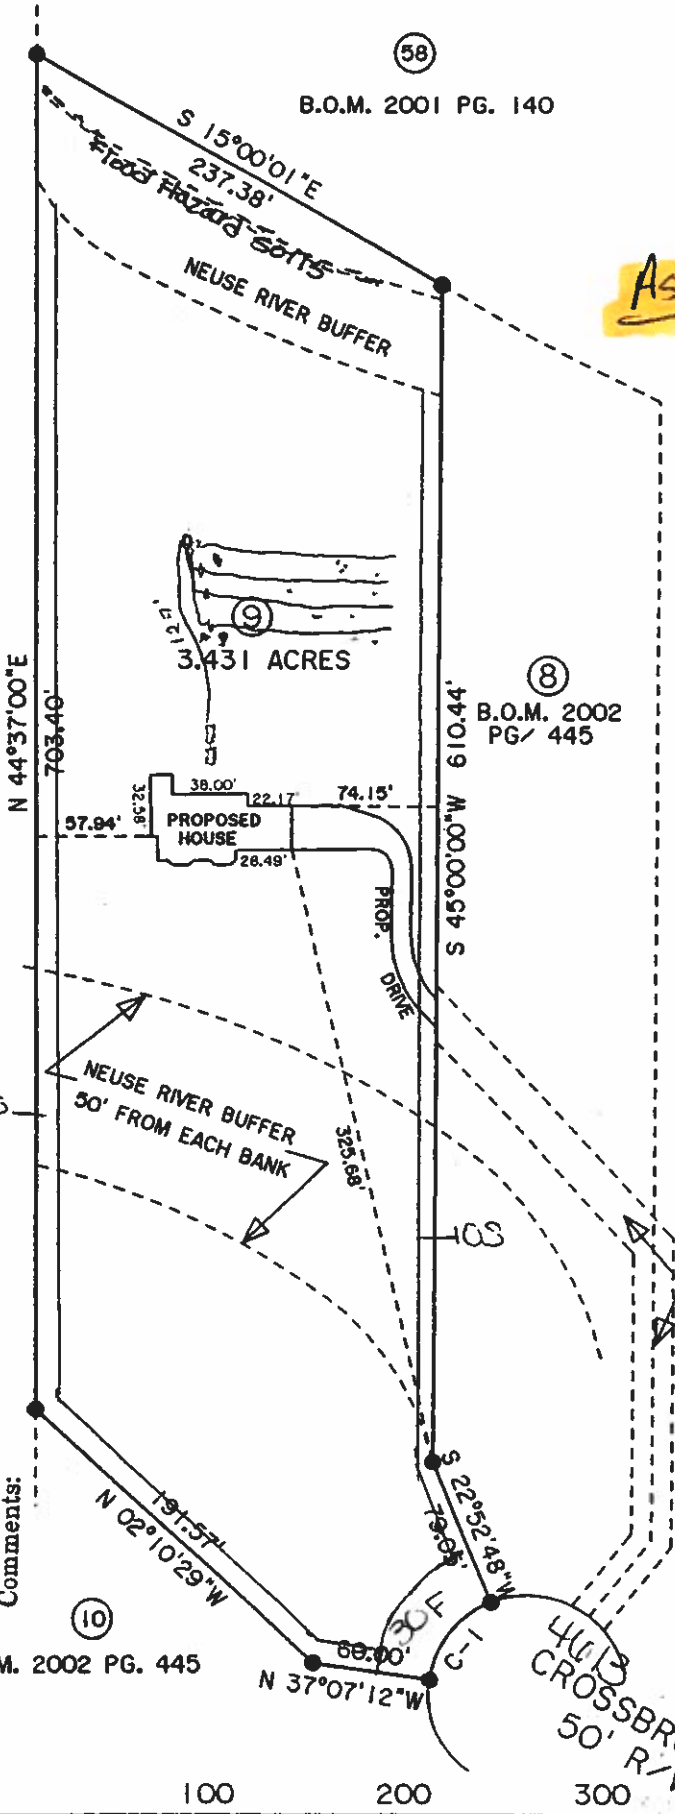

Pin: 1752.04.70.4959

I certify that the location of planned or existing structure(s) are accurately shown. I understand that to locate structures in accordance with this plot plan may require the relocation of structure(s) regardless degree of completion. I hereby grant permission to Municipal/County Representatives the right of entry to make evaluations or inspections upon this property.

Cindy J. Capps
Signature of Owner or Authorized Agent

⑦


B.O.M. 2002 PG. 445

0031252
D25802


IMPERVIOUS SURFACE:
HOUSE = 2332 SQ. FT.
DRIVEWAY = 2043 SQ. FT.
TOTAL IMP. = 4375 SQ. FT.
TOTAL AREA = 149454 SQ. FT.
2.9% TOTAL IMPERVIOUS

Approve ☒ Date 11.18.02
Revise ☐ Use ☐
Reject ☐ MBL
Front 30 Rear 30
Side 10 Corner
Comments:

B.O.M. 2002 PG. 445

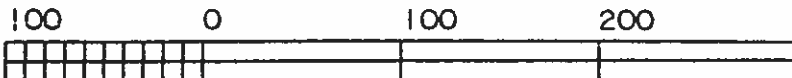

BE	RADIUS	LENGTH	CHORD	CH.BEARING
-1	50.00'	52.36'	50.00'	S 82°52'48"W

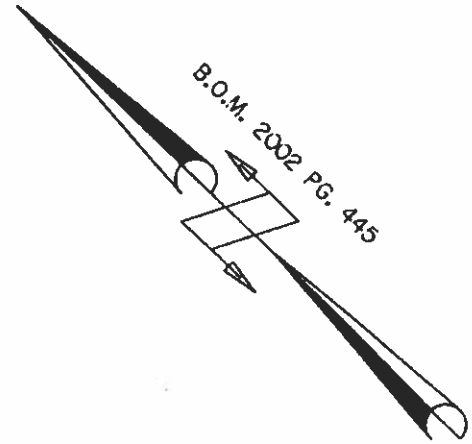

C.A. Site Plan

4 (3'x100') EzFlow drain lines

- contractor to follow lay out in field

- 1200 gal S.T. + P.T.


- Keep Tanks min. 15' from dwelling

- 18" Max trench depth

- Repair Area located in front portion of lot

Approve	✓	Date	11.8.02
Revise		Use	101
Reject		MBL	
Front	30	Rear	30
Side	10	Corner	

Comments:

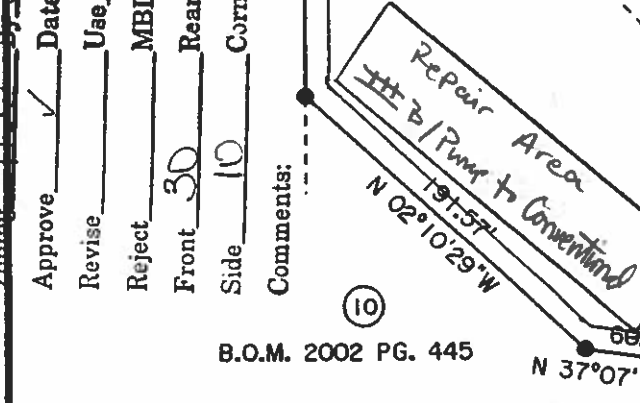

B.O.M. 2002 PG. 445

N 37°07'12"W

4613 CROSSBROOK LN.
50' R/W

Pin: 1752.04.70.4959

I certify that the location of planned or existing structure(s) are accurately shown. I understand the future to locate structures in accordance with this plot plan may require the relocation of structure(s) regardless degree of completion. I hereby grant permission to Municipal/County Representatives the right of entry to make evaluations or inspections upon this property.

Cindy J. Capps
Signature of Owner or Authorized Agent

⑦

B.O.M. 2002 PG. 445

0031252
D25802

20' JOINT DRIVEWAY AND ACCESS EASEMENT.

IMPERVIOUS SURFACE:
HOUSE = 2332 SQ. FT.
DRIVEWAY = 2043 SQ. FT.
TOTAL IMP. = 4375 SQ. FT.
TOTAL AREA = 149454 SQ. FT.
2.9% TOTAL IMPERVIOUS

