

* PERMIT VOID IF NOT IN COMPLIANCE WITH ZONING REGULATIONS

WAKE COUNTY HEALTH DEPARTMENT
SEPTIC TANK LAYOUT AND PERMIT

PERMIT NO. **B 502**

OWNER OR CONTRACTOR WILEY BROWN DATE 5-21-73


LOCATION 1109 Damascus Dr. PIN # 1765-58-7130 S.R. NO. 1013

SUBDIVISION NAME RIVERDALE LOT NO. 14 SECTION OR BLOCK NO. I

GARBAGE DISPOSAL UNIT YES ☐ NO ☒
HOUSE ☒ MOBILE HOME ☐ BUSINESS ☐
NO. BEDROOMS 3 LOT AREA 901
SIZE OF TANK 910 gal.
NITRIFICATION LINE 6' x 15' 910 sq. ft.
DEPTH OF STONE IN LINES: 12" ☒ 18" ☐
WATER SUPPLY: INDIVIDUAL ☐ PUBLIC ☒

* PERMIT VOID 12 MONTHS FROM DATE OF ISSUANCE.

LAYOUT BY M. Frank

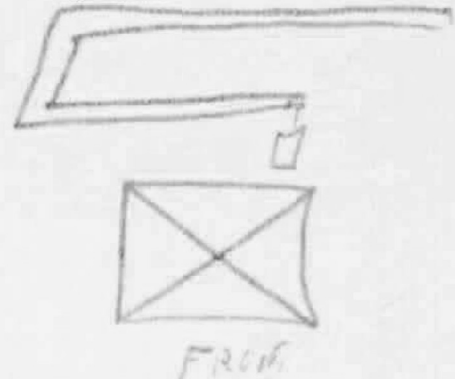

DATE 6-1-73

INSTALLED BY B. L. Conner

APPROVED BY M. Frank