

Environmental Services - Water Quality
Onsite Wastewater Scan Data Entry Form

PERMIT #: **C 0 0 7 0 5 7**

PIN #: **1 7 5 2 6 2 2 8 4 2**

OP DATE: **0 1 / 2 7 / 1 9 8 9**

SYSTEM USE:

- ☒ House
☐ Mobile Home
☐ Business
☐ Other

SEWAGE TYPE:

- ☒ Domestic
☐ Industrial

PUMP/SIPHON?:

- ☐ Yes
☒ No

PRESSURE MANIFOLD:

- ☐ Yes
☒ No

SYSTEM TYPE:

- ☐ I
☒ II
☐ III
☐ IV
☐ V
☐ VI
☐ Other

SUB TYPE:

- ☒ A
☐ B
☐ C
☐ D
☐ E
☐ F
☐ G

NBR BEDROOMS:

- ☐ 1
☐ 2
☒ 3
☐ 4
☐ 5
☐ 6
☐ Other

MAINT. SCHEDULE:

- ☐ Yes
☒ No

CERT. OPERATOR

- ☐ Yes
☒ No

GT ST PT SIZE

- | | | | |
|-------------------------------------|-------------------------------------|-------------------------------------|------------------|
| ☐ | ☐ | | 750 |
| ☐ | ☐ | ☐ | 900 |
| ☐ | ☒ | ☐ | 1,000 |
| ☐ | ☐ | ☐ | 1,200 |
| ☐ | ☐ | ☐ | 1,500 |
| ☐ | ☐ | ☐ | 1,800 |
| ☐ | ☐ | ☐ | 2,100 |
| ☐ | ☐ | ☐ | 2,500 |
| ☐ | ☐ | ☐ | 3,000 |
| ☐ | ☐ | ☐ | 4,000 |
| ☐ | ☐ | ☐ | 5,000 |
| ☐ | ☐ | ☐ | 8,000 |
| ☐ | ☐ | ☐ | 10,000 |
| ☐ | ☐ | ☐ | Other |
| ☒ | | ☒ | None/NA GT or PT |

DRAINFIELD SIZE(SQ. FT.)

0 1 1 0 0

DRAIN TYPE:

- ☒ Stone
☐ EZ Flow
☐ Infiltrator
☐ Biodiffuser
☐ Cultec
☐ Drip
☐ Hancor
☐ Large Dia. Pipe
☐ Multi-Pipe
☐ Other

MAX DEPTH (IN.):

- ☐ 12 in. or less
☐ 18 in. or less
☐ 24 in. or less
☐ 26 in. or less
☐ 28 in. or less
☐ 30 in. or less
☐ 32 in. or less
☐ 36 in. or less
☒ Other

STONE DEPTH (IN.):

- ☐ 8 in. or less
☐ 12 in. or less
☐ 18 in. or less
☐ 24 in. or less
☒ Other

TRENCHES:

- ☒ Individual
☐ Bed

TRENCH WIDTH (IN.):

- ☐ 12 in. or less
☐ 18 in.
☐ 24 in.
☒ 36 in.
☐ 6 ft. or less
☐ 9 ft. or less
☐ Other

WAKE COUNTY HEALTH DEPARTMENT WELL AND SEWAGE SITE, LOCATION PERMIT


Tax Map No. 037 Parcel No. 11 No. C 07057
 Contractor: _____ Operation Permit []
 Owner: ANDREW LEISTIKOW 266-5153 Date: 1-26-89
 Location/Address: CARRUTH RD. SK 1007 THR ON SR 2511
N 3 ON RIGHT S.R. # 2511
 Subdivision Name: GLEN MAR Lot No. 7 Section or Block No. _____
 Zoning: _____ Township: _____

Sewage System

Repair [] Original Permit No. B-34921
 Garbage Disposal Unit Yes [] No [☒]
 House [☒] Mobile Home [] Business []
 No. Bedrooms 3 Lot Area 1.95
 Size of Tank 1000 gal.
 Nitrification Line 1100 2 (3" x 185") sq. ft.
 Depth of Stone: 12" [] Max. Depth of Trenches: _____ in.
 Riser and Baffle Required [] Pump Required []

Improvement Permit

*Permit Void 36 months from date of issuance
 *Permit Void if not in compliance with zoning regulations
 *Permit may be voided if site alterations made
 Layout By: G. Dietrich

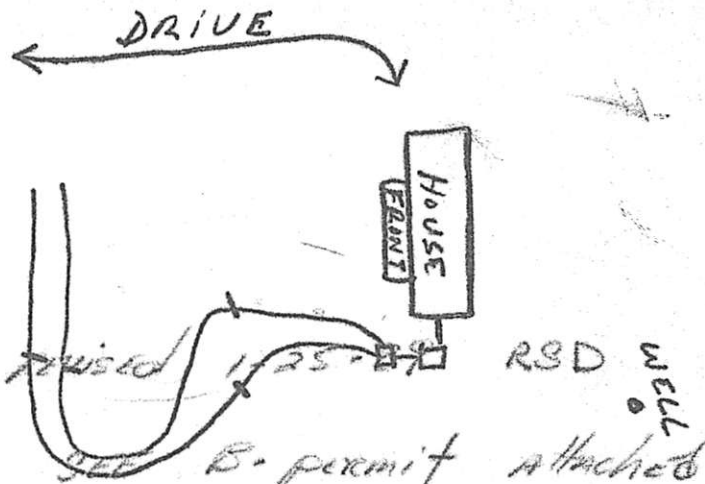

1-27-89

Date

SAM & CHARLES DAVIS

Installed By

Ron Dudley

Approved By

Well System

Individual [☒] Semi-Public [] Public []
 New [☒] Replacement [] Repair []
 Fee Paid Yes [☒] No []
 Construction Compliance Yes [☒] No []
 Site Approved [☒] []
 Well Head Approved [☒] []
 Grouting Approved [☒] []

Bacteriological Results

Initial Sample: NEG. Date: 8-2-89
 *Re-sample #1 _____ Date: _____
 *Re-sample #2 _____ Date: _____
 Re-chlorination as required Yes [] No []
 Comments: _____

*\$10.00 fee for all re-samples

All checks payable to: **Wake County Health Department**

Well Installed By: WATKINS Well Co.

8-4-89
 Date System Finalized

W. F. Quinn, R.S.
 Sanitarian

1-26-89 West Ramsey
 Date Inspected Sanitarian
 Final Inspection Yes [☒] No []
 Required Slab [☒] []
 Chlorinated [] []
 Required Certificate [] []
 Variance (Explain) [] []
 WCHD I.D. Affixed #1351 [☒] []
 Sample Collected [☒] []

**Well permit void 36 months from issuance date

This report is based in part on information provided by the homeowner or his/her representative in the application submitted for this permit. The sanitarian is not responsible for false or misleading information contained in the application. The sanitarian is also not responsible for concealed conditions on the property or for statements in this report that may have resulted from false or misleading statements provided to him in the application. Neither Wake County nor the sanitarian warrants that the septic tank system will continue to function satisfactorily in the future or that the water supply will remain potable.

FORMERLY
GLENN JACKSON

