

Environmental Services - Water Quality
Onsite Wastewater Scan Data Entry Form

PERMIT #: **G C 0 0 1 2 3**

PIN #: **0 7 7 3 8 9 1 5 1 1**

OP DATE: **0 6 / 0 6 / 1 9 6 8**

SYSTEM USE:

- ☒ House
☐ Mobile Home
☐ Business
☐ Other

SEWAGE TYPE:

- ☒ Domestic
☐ Industrial

PUMP/SIPHON?:

- ☐ Yes
☒ No

PRESSURE MANIFOLD:

- ☐ Yes
☒ No

SYSTEM TYPE:

- ☐ I
☒ II
☐ III
☐ IV
☐ V
☐ VI
☐ Other

SUB TYPE:

- ☒ A
☐ B
☐ C
☐ D
☐ E
☐ F
☐ G

NBR BEDROOMS:

- ☐ 1
☐ 2
☒ 3
☐ 4
☐ 5
☐ 6
☐ Other

MAINT. SCHEDULE:

- ☐ Yes
☒ No

CERT. OPERATOR

- ☐ Yes
☒ No

GT	ST	PT	SIZE
☐	☐		750
☐	☐	☐	900
☐	☒	☐	1,000
☐	☐	☐	1,200
☐	☐	☐	1,500
☐	☐	☐	1,800
☐	☐	☐	2,100
☐	☐	☐	2,500
☐	☐	☐	3,000
☐	☐	☐	4,000
☐	☐	☐	5,000
☐	☐	☐	8,000
☐	☐	☐	10,000
☐	☐	☐	Other
☒		☒	None/NA GT or PT

DRAINFIELD SIZE(SQ. FT.)

0 0 9 0 0

DRAIN TYPE:

- ☒ Stone
☐ EZ Flow
☐ Infiltrator
☐ Biodiffuser
☐ Cultec
☐ Drip
☐ Hancor
☐ Large Dia. Pipe
☐ Multi-Pipe
☐ Other

MAX DEPTH (IN.):

- ☐ 12 in. or less
☐ 18 in. or less
☐ 24 in. or less
☐ 26 in. or less
☐ 28 in. or less
☐ 30 in. or less
☐ 32 in. or less
☐ 36 in. or less
☒ Other

STONE DEPTH (IN.):

- ☐ 8 in. or less
☐ 12 in. or less
☐ 18 in. or less
☐ 24 in. or less
☒ Other

TRENCHES:

- ☐ Individual
☒ Bed

TRENCH WIDTH (IN.):

- ☐ 12 in. or less
☐ 18 in.
☐ 24 in.
☐ 36 in.
☒ 6 ft. or less
☐ 9 ft. or less
☐ Other

NA

Approved F&A
2/17/69

WAKE COUNTY HEALTH DEPARTMENT
SEPTIC TANK LAYOUT AND PERMIT

PERMIT NO. 122

OWNER W. A. Brown

DATE 12/12/67

GENERAL CONTRACTOR T. H. Beckner - Builder

LOCATION Lot 20 Strother Sub-division - Bashford Rd. - 381-067882-203

BEDROOMS 3 LOT AREA 20,000 Sq. Ft.

BASE DISPOSAL UNIT No (135")

C. TEST (1) 45 (2) 48 (3) (20.3) Left - 108' IPH

SIZE OF TANK 1000 gal. Tank gal

RIFICATION LINE 900 Sq. Ft. (21.50' x 6') sq. ft.

D FILTER _____ sq. ft.

WATER SUPPLY: Drilled well


Type

Approved

-Brown-

Driller

DESIGNED BY H. L. Jones

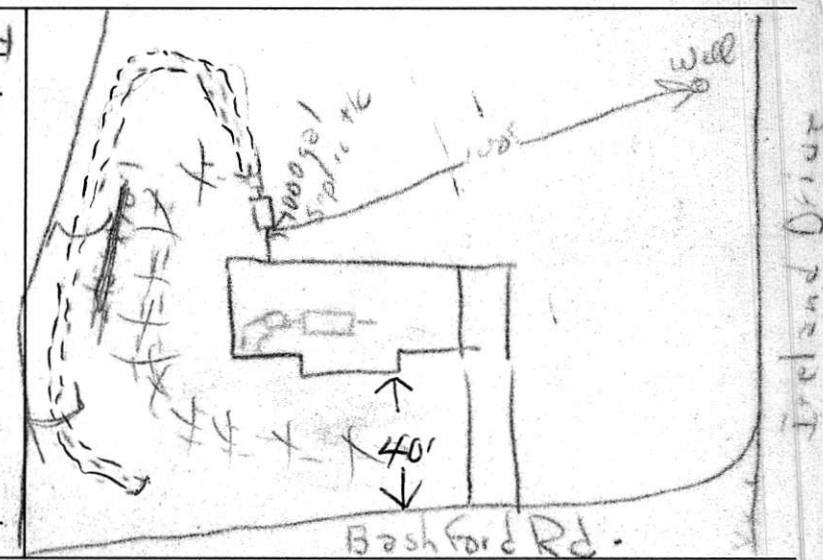

DATE 2/6/68

Installed By Kornegay Septic Works
INSTALLED BY

Approved By H. L. Jones
APPROVED BY