

**Environmental Services - Water Quality
Onsite Wastewater Scan Data Entry Form**

PERMIT #: 0004962 PIN #: 1740494824

OP DATE: 101311988

SYSTEM USE: ☒ House ☐ Mobile Home ☐ Business ☐ Other
 SEWAGE TYPE: ☒ Domestic ☐ Industrial
 PUMP/SIPHON?: ☐ Yes ☒ No
 PRESSURE MANIFOLD: ☐ Yes ☒ No

SYSTEM TYPE: ☐ I ☒ II ☐ III ☐ IV ☐ V ☐ VI ☐ Other
 SUB TYPE: ☒ A ☐ B ☐ C ☐ D ☐ E ☐ F ☐ G
 NBR BEDROOMS: ☐ 1 ☐ 2 ☒ 3 ☐ 4 ☐ 5 ☐ 6 ☐ Other
 MAINT. SCHEDULE: ☐ Yes ☒ No
 CERT. OPERATOR: ☐ Yes ☒ No

GT ☐ ST ☐ PT ☐ SIZE 750 ☐ 900 ☐ 1,000 ☐ 1,200 ☐ 1,500 ☐ 1,800 ☐ 2,100 ☐ 2,500 ☐ 3,000 ☐ 4,000 ☐ 5,000 ☐ 8,000 ☐ 10,000 ☐ Other ☒ None/NA GT or PT
 DRAINFIELD SIZE(SQ. FT.) 01100
 DRAIN TYPE: ☒ Stone ☐ EZ Flow ☐ Infiltrator ☐ Biodiffuser ☐ Cultec ☐ Drip ☐ Hancor ☐ Large Dia. Pipe ☐ Multi-Pipe ☐ Other

MAX DEPTH (IN.): ☐ 12 in. or less ☐ 18 in. or less ☐ 24 in. or less ☒ 26 in. or less ☐ 28 in. or less ☐ 30 in. or less ☐ 32 in. or less ☐ 36 in. or less ☐ Other
 STONE DEPTH (IN.): ☐ 8 in. or less ☒ 12 in. or less ☐ 18 in. or less ☐ 24 in. or less ☐ Other
 TRENCHES: ☒ Individual ☐ Bed
 TRENCH WIDTH (IN.): ☐ 12 in. or less ☐ 18 in. ☐ 24 in. ☒ 36 in. ☐ 6 ft. or less ☐ 9 ft. or less ☐ Other

RB
10/28/13

WAKE COUNTY HEALTH DEPARTMENT WELL AND SEWAGE SITE, LOCATION PERMIT

Tax Map No. 709 Parcel No. 11 No. C 04962

Contractor: W. L. Moore Operation Permit []

Owner: W. L. Moore Date: May 10 1988

Location/Address: 1651 S. D. Moore S.R. # 542

Subdivision Name: W. L. Moore Lot No. 1 Section or Block No. 1

Zoning: Sub C Township: 11

Sewage System

Repair [] Original Permit No.

Garbage Disposal Unit Yes [] No [] ☒

House [] Mobile Home [] Business []

No. Bedrooms 3 Lot Area 4000 gal.

Size of Tank 2113 x 1153 1100 sq. ft.

Nitrification Line 2113 x 1153 Max. Depth of Trenches: 26 1/2 in.

Depth of Stone/12" 2113 Max. Depth of Trenches: 26 1/2 in.

Riser and Baffle Required [] Pump Required []


Improvement Permit

*Permit Void 36 months from date of issuance

*Permit Void if not in compliance with zoning regulations

*Permit may be voided if site alterations made

Layout By: W. L. Moore

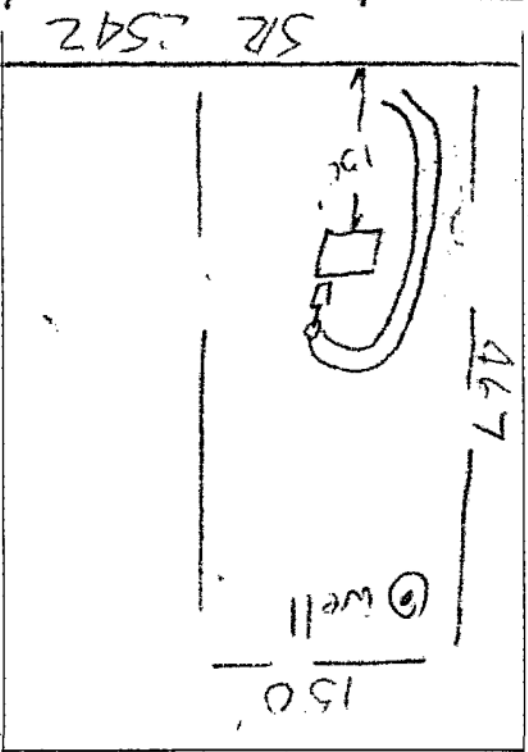

Date 9/7/88 Installed By W. L. Moore Approved By W. L. Moore

Well System

Individual [] Semi-Public [] Public []

New [] Replacement [] Repair []

Fee Paid Yes [] No []

Construction Compliance Yes [] No []

Site Approved []

Well Head Approved []

Grouting Approved []

Date Inspected

Final Inspection

Required Slab

Chlorinated

Required Certificate

Variance (Explain)

WCHD I.D. Affixed

Sample Collected

**Well permit void 36 months from issuance date

Sanitarian

Yes [] No []

Yes [] No []

Bacteriological Results

Initial Sample: Negative Date: 10-31-88

*Re-sample #1 Date:

*Re-sample #2 Date:

Re-chlorination as required Yes [] No []

Comments:

*\$10.00 fee for all re-samples

All checks payable to: **Wake County Health Department**

Well Installed By: Estes



10-31-88

Date System Finalized

Sanitarian

This report is based in part on information provided by the homeowner or his/her representative in the application submitted for this permit. The sanitarian is not responsible for false or misleading information contained in the application. The sanitarian is also not responsible for concealed conditions on the property or for statements in this report that may have resulted from false or misleading statements provided to him in the application. Neither Wake County nor the sanitarian warrants that the septic tank system will continue to function satisfactorily in the future or that the water supply will remain potable.

SHOW THE PROPERTY LINES OF THE LOT ON THE GRAPH BELOW, INCLUDING ROAD FRONTAGE

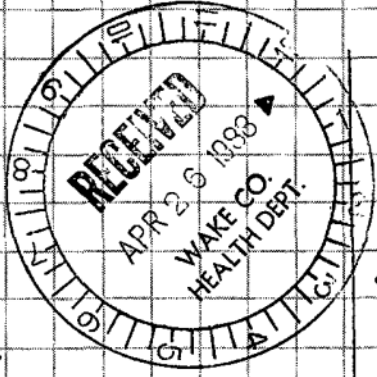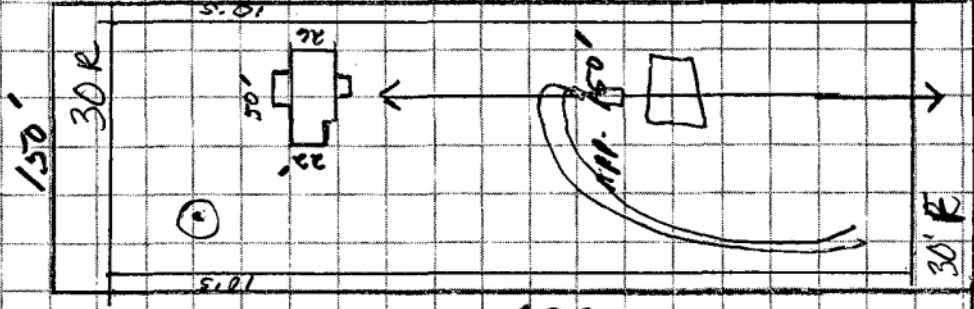

SL 2542

* SL2542 T/L 2320 ~~2320~~ LOT ON L

CONSTRUCTION CANNOT OCCUR WITHIN ANY REQUIRED YARD AS SHOWN

OFFICE USE ONLY

Comments:

Applicant _____ Tax Map 709 Parcel 11 Jurisdiction WAKE
 Building Permit # _____ Date _____ Zoning Approval By _____
 Improvement Permit # C04962 Date 5-10-88 Health Approval By Parrell

AS NEEDED

Lot Area 30,000 Sq. Ft. Lot Width 100 Ft. Corner Yard Setback 30 Ft.
Side Yard Setback 10 Ft. Rear Yard Setback 30 Ft. Front Yard Setback 30 Ft.

White: Health Department

Pink: Issuing Agent

HEALTH DEPARTMENT