

Environmental Services - Water Quality
Onsite Wastewater Scan Data Entry Form

PERMIT #: C005585

PIN #: 0790869690

OP DATE: 0813111988

SYSTEM USE:

- ☒ House
☐ Mobile Home
☐ Business
☐ Other

SEWAGE TYPE:

- ☒ Domestic
☐ Industrial

PUMP/SIPHON?:

- ☐ Yes
☒ No

PRESSURE MANIFOLD:

- ☐ Yes
☒ No

SYSTEM TYPE:

- ☐ I
☒ II
☐ III
☐ IV
☐ V
☐ VI
☐ Other

SUB TYPE:

- ☒ A
☐ B
☐ C
☐ D
☐ E
☐ F
☐ G

NBR BEDROOMS:

- ☐ 1
☐ 2
☒ 3
☐ 4
☐ 5
☐ 6
☐ Other

MAINT. SCHEDULE:

- ☐ Yes
☒ No

CERT. OPERATOR

- ☐ Yes
☒ No

GT ST PT

- | | | | |
|-------------------------------------|-------------------------------------|-------------------------------------|------------------|
| ☐ | ☐ | ☐ | 750 |
| ☐ | ☐ | ☐ | 900 |
| ☐ | ☒ | ☐ | 1,000 |
| ☐ | ☐ | ☐ | 1,200 |
| ☐ | ☐ | ☐ | 1,500 |
| ☐ | ☐ | ☐ | 1,800 |
| ☐ | ☐ | ☐ | 2,100 |
| ☐ | ☐ | ☐ | 2,500 |
| ☐ | ☐ | ☐ | 3,000 |
| ☐ | ☐ | ☐ | 4,000 |
| ☐ | ☐ | ☐ | 5,000 |
| ☐ | ☐ | ☐ | 8,000 |
| ☐ | ☐ | ☐ | 10,000 |
| ☐ | ☐ | ☐ | Other |
| ☒ | | ☒ | None/NA GT or PT |

DRAINFIELD SIZE(SQ. FT.)

01100

DRAIN TYPE:

- ☒ Stone
☐ EZ Flow
☐ Infiltrator
☐ Biodiffuser
☐ Cultec
☐ Drip
☐ Hancor
☐ Large Dia. Pipe
☐ Multi-Pipe
☐ Other

MAX DEPTH (IN.):

- ☐ 12 in. or less
☐ 18 in. or less
☐ 24 in. or less
☐ 26 in. or less
☐ 28 in. or less
☒ 30 in. or less
☐ 32 in. or less
☐ 36 in. or less
☐ Other

STONE DEPTH (IN.):

- ☐ 8 in. or less
☒ 12 in. or less
☐ 18 in. or less
☐ 24 in. or less
☐ Other

TRENCHES:

- ☒ Individual
☐ Bed

TRENCH WIDTH (IN.):

- ☐ 12 in. or less
☐ 18 in.
☐ 24 in.
☒ 36 in.
☐ 6 ft. or less
☐ 9 ft. or less
☐ Other

mg
3/10/15

WAKE COUNTY HEALTH DEPARTMENT WELL AND SEWAGE SITE, LOCATION PERMIT

Tax Map No. 702 Parcel No. 430 No. C 05585

Contractor: _____ Operation Permit []

Owner: Douglas Woodard Date: MAY 26, 1988

Location/Address: 1701 Wilger Court

Subdivision Name: Colonial Heights S.R. # 4015

Lot No. 20 Section or Block No. _____

Zoning: WAKE Township: SWIFT CREEK BLD# 088329Z

M/075 SUMIC 2/22/88 411P

Sewage System

Repair [] Original Permit No. _____

Garbage Disposal Unit Yes [] No []

House [] Mobile Home [] Business []

No. Bedrooms 3 Lot Area 0.918

Size of Tank 1000 gal.

Nitrification Line 2(3' x 185') = 1100 sq. ft.

Depth of Stone: 12" [] Max. Depth of Trenches: 30 in.

Riser and Baffle Required [] Pump Required []


Improvement Permit

*Permit Void 36 months from date of issuance

*Permit Void if not in compliance with zoning regulations

*Permit may be voided if site alterations made

Laid out By: Robert G. Archer R.S.

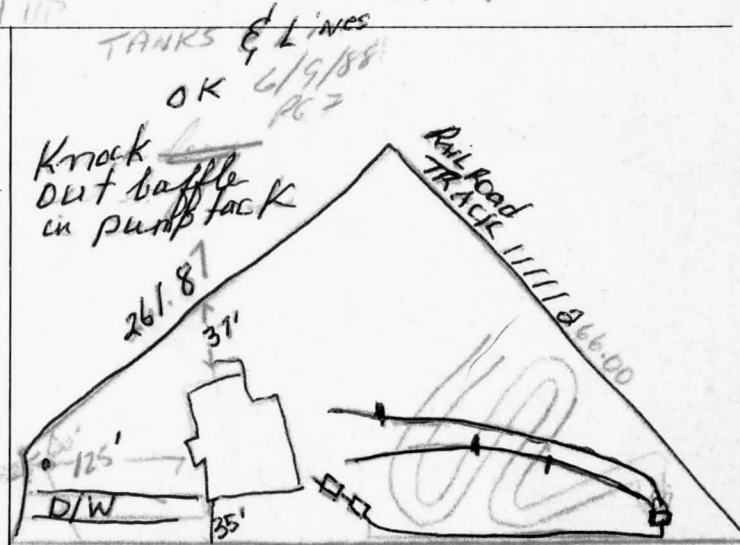

Date 8/26/88 Installed By DRMOND GRADING Approved By DAVID BROWN

Well System

Individual [] Semi-Public [] Public []

New [] Replacement [] Repair []

Fee Paid Yes [] No []

Construction Compliance Yes No

Site Approved [] []

Well Head Approved [] []

Grouting Approved [] []

Date Inspected 6-17-88 Sanitarian Shirley B. Fanning

Final Inspection Yes No

Required Slab [] []

Chlorinated [] []

Required Certificate [] []

Variance (Explain) [] []

WCHD I.D. Affixed [] []

Sample Collected 8-29 [] []

**Well permit void 36 months from issuance date

Bacteriological Results

Initial Sample: Neg 2.2 mpr Date: 8-31-88

*Re-sample #1 _____ Date: _____

*Re-sample #2 _____ Date: _____

Re-chlorination as required Yes [] No []

Comments: _____


*\$10.00 fee for all re-samples

All checks payable to: **Wake County Health Department**

Well Installed By: GOLDSTON WELL DRILLING

Date System Finalized 8-31-88 Sanitarian Shirley B. Fanning

This report is based in part on information provided by the homeowner or his/her representative in the application submitted for this permit. The sanitarian is not responsible for false or misleading information contained in the application. The sanitarian is also not responsible for concealed conditions on the property or for statements in this report that may have resulted from false or misleading statements provided to him in the application. Neither Wake County nor the sanitarian warrants that the septic tank system will continue to function satisfactorily in the future or that the water supply will remain potable.

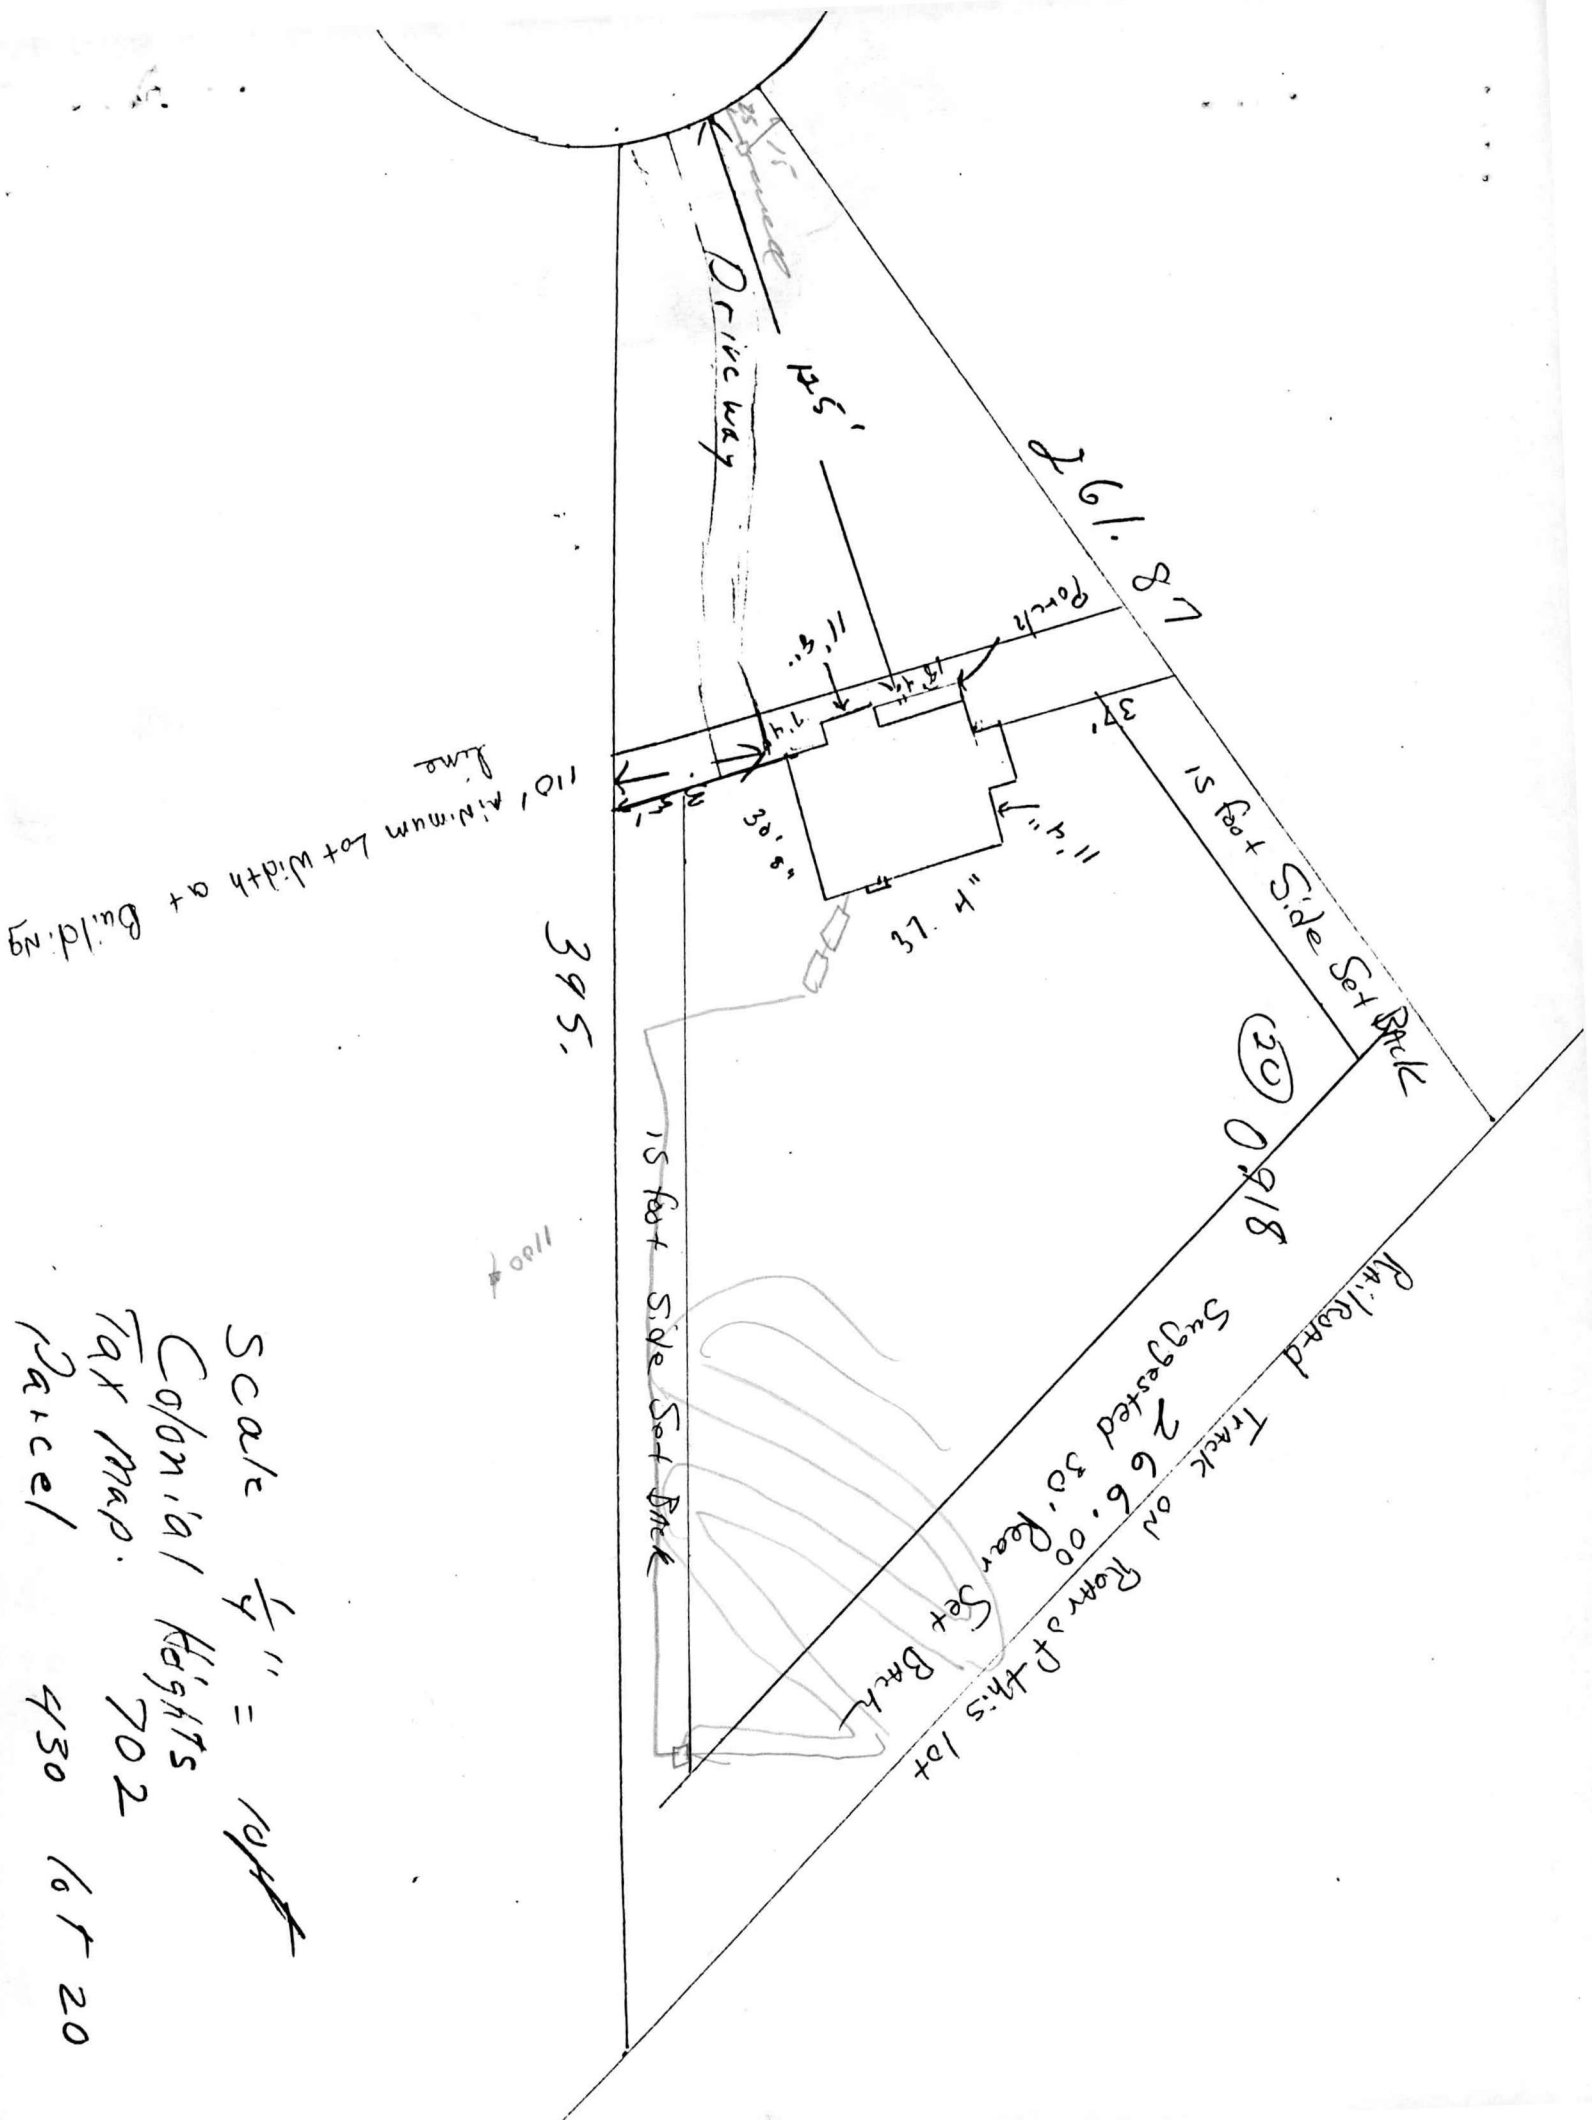

Scale $\frac{1}{4}'' = 10'$
 Colonial Heights
 Tax Map. 702
 Parcel 430 lot 20

110' minimum lot width at Building Line

Rail Road Track on Rear of this lot
 Suggested 30' Rear Set Back
 266.00
 (20) 0.918
 15 foot Side Set Back
 15 foot Side Set Back