

Environmental Services - Water Quality
Onsite Wastewater Scan Data Entry Form

PERMIT #: **B 0 I I 5 0 4**

PIN #: **I 7 4 0 5 2 4 0 I 3**

OP DATE: **0 6 / I 5 / I 9 7 8**

SYSTEM USE:

- ☒ House
☐ Mobile Home
☐ Business
☐ Other

SEWAGE TYPE:

- ☒ Domestic
☐ Industrial

PUMP/SIPHON?:

- ☐ Yes
☒ No

PRESSURE MANIFOLD:

- ☐ Yes
☒ No

SYSTEM TYPE:

- ☐ I
☒ II
☐ III
☐ IV
☐ V
☐ VI
☐ Other

SUB TYPE:

- ☒ A
☐ B
☐ C
☐ D
☐ E
☐ F
☐ G

NBR BEDROOMS:

- ☐ 1
☐ 2
☒ 3
☐ 4
☐ 5
☐ 6
☐ Other

MAINT. SCHEDULE:

- ☐ Yes
☒ No

CERT. OPERATOR

- ☐ Yes
☒ No

GT ST PT SIZE

- | | | | |
|-------------------------------------|-------------------------------------|-------------------------------------|------------------|
| ☐ | ☐ | ☐ | 750 |
| ☐ | ☒ | ☐ | 900 |
| ☐ | ☐ | ☐ | 1,000 |
| ☐ | ☐ | ☐ | 1,200 |
| ☐ | ☐ | ☐ | 1,500 |
| ☐ | ☐ | ☐ | 1,800 |
| ☐ | ☐ | ☐ | 2,100 |
| ☐ | ☐ | ☐ | 2,500 |
| ☐ | ☐ | ☐ | 3,000 |
| ☐ | ☐ | ☐ | 4,000 |
| ☐ | ☐ | ☐ | 5,000 |
| ☐ | ☐ | ☐ | 8,000 |
| ☐ | ☐ | ☐ | 10,000 |
| ☐ | ☐ | ☐ | Other |
| ☒ | ☐ | ☒ | None/NA GT or PT |

DRAINFIELD SIZE(SQ. FT.)

0 0 9 0 0

DRAIN TYPE:

- ☒ Stone
☐ EZ Flow
☐ Infiltrator
☐ Biodiffuser
☐ Cultec
☐ Drip
☐ Hancor
☐ Large Dia. Pipe
☐ Multi-Pipe
☐ Other

MAX DEPTH (IN.):

- ☐ 12 in. or less
☐ 18 in. or less
☐ 24 in. or less
☐ 26 in. or less
☐ 28 in. or less
☐ 30 in. or less
☐ 32 in. or less
☐ 36 in. or less
☒ Other

STONE DEPTH (IN.):

- ☐ 8 in. or less
☒ 12 in. or less
☐ 18 in. or less
☐ 24 in. or less
☐ Other

TRENCHES:

- ☒ Individual
☐ Bed

TRENCH WIDTH (IN.):

- ☐ 12 in. or less
☐ 18 in.
☐ 24 in.
☒ 36 in.
☐ 6 ft. or less
☐ 9 ft. or less
☐ Other

* PERMIT VOID IF NOT IN COMPLIANCE WITH ZONING REGULATIONS

1740 52 4013

TAX MAP NO. 731

PARCEL NO. 10

WAKE COUNTY HEALTH DEPARTMENT
SEPTIC TANK LAYOUT AND PERMIT

PERMIT NO. B

OWNER OR CONTRACTOR Master Builders & Realty DATE 5-9-78

LOCATION Sunnybrook Rd - TL Rock Quarry Rd - TL SR1004 - 1/4 mile past

SR2558 on left - just before Pine Hollow GC (Johnston Co. Line) S. R. NO. 1004

SUBDIVISION NAME Swade E. Barbour LOT NO. 1 Prop. LANE SECTION OR BLOCK NO. New section

GARBAGE DISPOSAL UNIT YES ☐ NO ☒

HOUSE ☒ MOBILE HOME ☐ BUSINESS ☐

NO. BEDROOMS 3 LOT AREA 0.737 ac.

SIZE OF TANK 900 gal.

NITRIFICATION LINE 2 (3' x 150') 900 sq. ft.


DEPTH OF STONE IN LINES: 12" ☒ 18" ☐

WATER SUPPLY: INDIVIDUAL ☒ PUBLIC ☐

* PERMIT VOID 12 MONTHS FROM DATE OF ISSUANCE.

* Need copy of subdivision survey prior to issuance of COC.

LAYOUT BY D. Flower

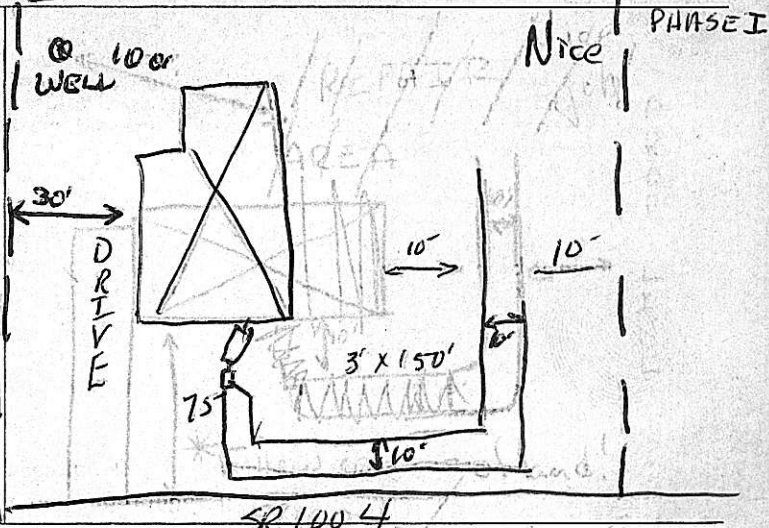

6-15-78

DATE

D. Flower Master Builders

INSTALLED BY

Swade E. Barbour

APPROVED BY