

Environmental Services - Water Quality
Onsite Wastewater Scan Data Entry Form

PERMIT #: **WA I 5 7 8 8**

PIN #: **I 6 0 9 4 5 8 2 7 0**

OP DATE: **0 6 / I 3 / 2 0 I 7**

SYSTEM USE:

- ☒ House
☐ Mobile Home
☐ Business
☐ Other

SEWAGE TYPE:

- ☒ Domestic
☐ Industrial

PUMP/SIPHON?:

- ☐ Yes
☒ No

PRESSURE MANIFOLD:

- ☐ Yes
☒ No

SYSTEM TYPE:

- ☐ I
☒ II
☐ III
☐ IV
☐ V
☐ VI
☐ Other

SUB TYPE:

- ☒ A
☐ B
☐ C
☐ D
☐ E
☐ F
☐ G

NBR BEDROOMS:

- ☐ 1
☐ 2
☐ 3
☒ 4
☐ 5
☐ 6
☐ Other

MAINT. SCHEDULE:

- ☐ Yes
☒ No

CERT. OPERATOR

- ☐ Yes
☒ No

GT ST PT SIZE

- | | | | |
|-------------------------------------|-------------------------------------|-------------------------------------|------------------|
| ☐ | ☐ | | 750 |
| ☐ | ☐ | ☐ | 900 |
| ☐ | ☐ | ☐ | 1,000 |
| ☐ | ☒ | ☐ | 1,200 |
| ☐ | ☐ | ☐ | 1,500 |
| ☐ | ☐ | ☐ | 1,800 |
| ☐ | ☐ | ☐ | 2,100 |
| ☐ | ☐ | ☐ | 2,500 |
| ☐ | ☐ | ☐ | 3,000 |
| ☐ | ☐ | ☐ | 4,000 |
| ☐ | ☐ | ☐ | 5,000 |
| ☐ | ☐ | ☐ | 8,000 |
| ☐ | ☐ | ☐ | 10,000 |
| ☐ | ☐ | ☐ | Other |
| ☒ | | ☒ | None/NA GT or PT |

DRAINFIELD SIZE(SQ. FT.)

0 I 4 4 0

DRAIN TYPE:

- ☒ Stone
☐ EZ Flow
☐ Infiltrator
☐ Biodiffuser
☐ Cultec
☐ Drip
☐ Hancor
☐ Large Dia. Pipe
☐ Multi-Pipe
☐ Other

MAX DEPTH (IN.):

- ☐ 12 in. or less
☐ 18 in. or less
☒ 24 in. or less
☐ 26 in. or less
☐ 28 in. or less
☐ 30 in. or less
☐ 32 in. or less
☐ 36 in. or less
☐ Other

STONE DEPTH (IN.):

- ☐ 8 in. or less
☒ 12 in. or less
☐ 18 in. or less
☐ 24 in. or less
☐ Other

TRENCHES:

- ☒ Individual
☐ Bed

TRENCH WIDTH (IN.):

- ☐ 12 in. or less
☐ 18 in.
☐ 24 in.
☒ 36 in.
☐ 6 ft. or less
☐ 9 ft. or less
☐ Other

AL 3

CURVE	RADIUS	LENGTH	DELTA	CHORD	CH.BEARING
C-1	375.00'	146.37'	22°21'49"	145.44'	N 74°48'52"E


Revised

NOTES/LEGEND

AREA BY COORDINATES
NO NCGS CONTROL FOUND WITHIN 2000'
PROPERTY SUBJECT TO ABOVE AND BELOW
GROUND UTILITIES AND/OR EASEMENTS.
EIP - EXISTING IRON PIPE
ISS - IRON STAKE SET
WM - WATER METER
CATV - CABLE TV PEDESTAL
HVAC - HEAT/AIR UNIT

THIS LOT IS NOT LOCATED IN A
FLOOD HAZARD AREA PER
F.E.M.A. MAP #3720160900J
EFF. DATE: 5/2/2006 ZONE X

VICINITY MAP NTS

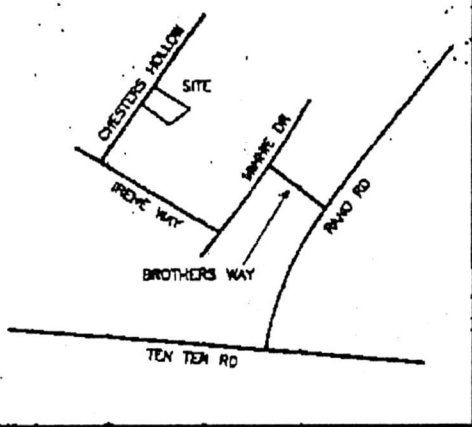

CHESTERS HOLLOW DRIVE
1012
50' PUBLIC R/W

S 83°13'11"W
568.85'
TIE TO INTERSECTION
WITH IRENE WAY.

EIP
WM
CATV
EIP CONTROL
CORNER

72.5' EXIST TWO STORY
WOOD FRAME
HOME

FENCE OVER LINE
BY 1.5'

HVAC

CONC. DRIVE

SEPTIC
SYSTEM

SCREEN
PORCH

Repair
CHAIN LINK FENCE
area

0.837 ACRES
80,018 SF

UNSUITABLE SOILS LINE
PER B.M. 2000 PG. 1635

CL CREEK

N 86°47'22"W 288.53'

EIP
CONTROL
CORNER

PHYSICAL SURVEY FOR:
CARL & ALEXANDRA LINDAHL

Site plan approved as shown for 6.5' x 20.5' deck

Any changes to site plan voids approval. All setbacks apply
for septic systems and wells, regarding any pools, decks
additions and/or accessory structures. Applicant is responsible for
protecting all portions of the septic system, repair area and

1012 CHESTERS HOLLOW DRIVE
RALEIGH, NC 27603

LOT 98 WILDERS RIDGE - PHASE 4.
BOOK OF MAPS 2000 PAGE 1635
DEED BOOK 8991 PAGE 1579
PIN #1609458270 000
PANTHER BRANCH TOWNSHIP
WAKE COUNTY - NORTH CAROLINA
SCALE: 1" = 50' SEPTEMBER 10, 2013

Approved by [Signature] Date 6/13/17

Wake County Department of Environmental Services.
Water and Waste Water Section

BENTON DEWAR & ASSOCIATES
PROFESSIONAL LAND SURVEYOR
5920 HONEYCUTT ROAD
HOLLY SPRINGS, NC 27540
(919)-552-9813

13-73L
98WILDER/13/650



I, BENTON W. DEWAR CERTIFY THAT THIS PLAT WAS DRAWN UNDER
MY SUPERVISION FROM AN ACTUAL SURVEY MADE UNDER MY
SUPERVISION; THAT THE RATIO OF PRECISION IS 1:1;
THAT THE BOUNDARIES NOT SURVEYED ARE SHOWN AS BROKEN LINES
PLOTTED FROM INFORMATION FOUND IN BOOK 1635 DEED BOOK 8991
PAGE 1579; THAT THIS PLAT DOES NOT MEET SIZE REQUIREMENTS
FOR RECORDING IN THE REGISTER OF DEEDS, PER G.S. CHAPTER 45B
LICENCE NUMBER AND SEAL THIS 11th DAY OF SEP 2017

THIS PLAT IS OF A BOUNDARY SURVEY OF AN EXISTING
PARCEL OF LAND THAT IS REGULATED BY A COUNTY OR
MUNICIPALITY ORDINANCE THAT REGULATES PARCELS OF LAND

Zoning R800 By KAS
Approve X Date 6-8-17
Revise X Use 4347
Reject X Mbl. 1017
Front 40 Rear 30
Side 20 Corner 20
Comments:

1609458270
I certify that the location of planned or existing structure(s)
are accurately shown. I understand failure to locate
structures in accordance with this plot plan may
require the relocation of structure(s) regardless
degree of completion. I hereby grant permission to
Municipal/County Representatives the right of entry
to make evaluations or inspections upon this property.
[Signature]
Signature of Owner or Authorized Agent

(99)
WILLIAM GIAMMO
D.B. 14985 PG. 2425

0173900
W-15788