

Environmental Services - Water Quality
Onsite Wastewater Scan Data Entry Form

PERMIT #: D007433

PIN #: 1617312704

OP DATE: 0110511998

SYSTEM USE:

- ☒ House
☐ Mobile Home
☐ Business
☐ Other

SEWAGE TYPE:

- ☒ Domestic
☐ Industrial

PUMP/SIPHON?:

- ☐ Yes
☒ No

PRESSURE MANIFOLD:

- ☐ Yes
☒ No

SYSTEM TYPE:

- ☐ I
☒ II
☐ III
☐ IV
☐ V
☐ VI
☐ Other

SUB TYPE:

- ☒ A
☐ B
☐ C
☐ D
☐ E
☐ F
☐ G

NBR BEDROOMS:

- ☐ 1
☐ 2
☒ 3
☐ 4
☐ 5
☐ 6
☐ Other

MAINT. SCHEDULE:

- ☐ Yes
☒ No

CERT. OPERATOR

- ☐ Yes
☒ No

GT ST PT SIZE

- | | | | |
|-------------------------------------|-------------------------------------|-------------------------------------|------------------|
| ☐ | ☐ | ☐ | 750 |
| ☐ | ☐ | ☐ | 900 |
| ☐ | ☒ | ☐ | 1,000 |
| ☐ | ☐ | ☐ | 1,200 |
| ☐ | ☐ | ☐ | 1,500 |
| ☐ | ☐ | ☐ | 1,800 |
| ☐ | ☐ | ☐ | 2,100 |
| ☐ | ☐ | ☐ | 2,500 |
| ☐ | ☐ | ☐ | 3,000 |
| ☐ | ☐ | ☐ | 4,000 |
| ☐ | ☐ | ☐ | 5,000 |
| ☐ | ☐ | ☐ | 8,000 |
| ☐ | ☐ | ☐ | 10,000 |
| ☐ | ☐ | ☐ | Other |
| ☒ | | ☒ | None/NA GT or PT |

DRAINFIELD SIZE(SQ. FT.)

00900

DRAIN TYPE:

- ☒ Stone
☐ EZ Flow
☐ Infiltrator
☐ Biodiffuser
☐ Cultec
☐ Drip
☐ Hancor
☐ Large Dia. Pipe
☐ Multi-Pipe
☐ Other

MAX DEPTH (IN.):

- ☐ 12 in. or less
☐ 18 in. or less
☒ 24 in. or less
☐ 26 in. or less
☐ 28 in. or less
☐ 30 in. or less
☐ 32 in. or less
☐ 36 in. or less
☐ Other

STONE DEPTH (IN.):

- ☐ 8 in. or less
☒ 12 in. or less
☐ 18 in. or less
☐ 24 in. or less
☐ Other

TRENCHES:

- ☒ Individual
☐ Bed

TRENCH WIDTH (IN.):

- ☐ 12 in. or less
☐ 18 in.
☐ 24 in.
☒ 36 in.
☐ 6 ft. or less
☐ 9 ft. or less
☐ Other

CH

★ NOT FOR WASTEWATER SYSTEM CONSTRUCTION ★
WAKE COUNTY ENVIRONMENTAL HEALTH WELL AND SEWAGE SITE, LOCATION PERMIT

NO PERMIT(S) FOR CONSTRUCTION, LOCATION OR RELOCATION ACTIVITY SHALL BE ISSUED
 UNTIL AN AUTHORIZATION FOR WASTEWATER SYSTEM CONSTRUCTION HAS BEEN ISSUED.

Pin # 1617.03219386 ^{3/2704} Project # 098053198/490 Improvement Permit
 Tax Map No. 845 Parcel No. 16 Well Permit No. **D 7433**
 Zoning WAKE Township 15 Operation Permit []
 Owner/Contractor Comfort Homes Inc. Date: 9/17/97
 Location/Address: 6605 WINTERTON
50 Hwy S. T/R 42 Subd. on RT. S.R. # _____
 Subdivision Name: ST. JENS Lot No. 11 Section or Block No. _____


Tax Map No. 845
 Parcel No. 16

Preliminary Layout

SEE ATTACHED PLOT PLAN FOR WASTEWATER DISPOSAL SITE.

SEE CONSTRUCTION AUTHORIZATION FOR WASTEWATER SYSTEM DESIGN.

Final Layout

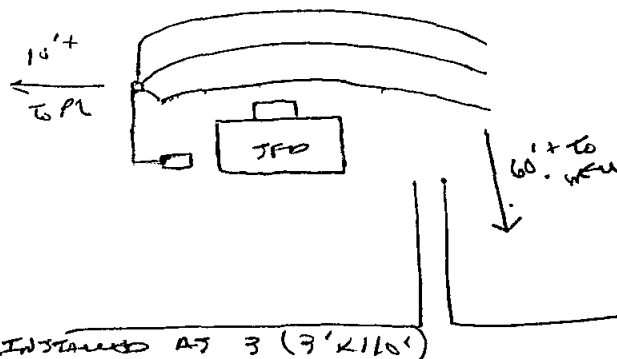

Sewage System Specifications

Repair [] Original Permit No. _____
 Garbage Disposal Unit Yes [] No [☒]
 House [☒] Mobile Home [] Business []
 No. of Bedrooms 3 Lot Area _____
 Size of Tank 1000 gal. MCB-11/12/97
 Wastewater: Sewage [☒] Industrial [] Comments: _____

Nitrification Line 2 (150' x 3') 900 sq. ft.
 Depth of Stone: 12" [☒] Max Depth of Trenches: 24 in.
 Riser and Baffle Required [☒] Pump Required []
 Permit void if not in compliance with zoning regulations
 Permits may be voided if site is altered or intended use changed
 Layout by: Ron Quelling R.S.

Date: 1/5/98 Installed By: BRANTIS BOWMAN Approved By: [Signature]

Well System
 Individual [☒] Semi-Public [] Public []
 New [☒] Replacement [] Repair []
 Fee Paid: Yes [☒] No []

Construction Compliance
 Yes No
 Site Approved [☒] []
 Well Head Approved [☒] []
 Grouting Approved [☒] []

Date Inspected 1/23/98

Sanitarian [Signature]

Bacteriological Results

Initial Sample: WQ Date: 2/2/98
 * Re-Sample #1 _____ Date: _____
 * Re-Sample #2 _____ Date: _____
 * Re-chlorination as required [] Yes [] No
 * Fees for all resamples

All checks payable to: **Wake County**

Final Inspection

	Yes	No
Required Slab	☒	[]
Chlorinated	☒	[]
Required Certificate	[]	[]
Variance (Explain)	[]	☒
WCHD I.D. Affixed <u>7492</u>	☒	[]
Sample Collected	[]	[]

Comments: _____

Well Installed By: Reliance Well

Date System Finalized 2/5/98

Sanitarian [Signature]

This report is based in part on information provided by the homeowner or his/her representative in the application submitted for this permit. The sanitarian is not responsible for false or misleading information contained in the application. The sanitarian is also not responsible for concealed conditions on the property or for statements in this report that may have resulted from false or misleading statements provided to him in the application. Neither Wake County nor the sanitarian warrants that the septic tank system will continue to function satisfactorily in the future or that the water supply will remain potable.

AUTHORIZATION FOR WASTEWATER SYSTEM CONSTRUCTION
VOID SIXTY (60) MONTHS FROM DATE OF ISSUANCE

DATE: 9/17/97 IMPROVEMENT PERMIT NO.: 1617.03219386 ^{D-7433}
TAX MAP NO.: 845 PARCEL NO.: 16 PIN NO.: 31-2704
OWNER/CONTRACTOR: SON-LAN BUILDERS
LOCATION/ADDRESS: 6605 WINTER TOW
SUBDIVISION NAME: ST. JENS
LOT NO.: 11 SECTION OR BLOCK NO.:
AUTHORIZATION ISSUED BY: Ron Dudley R.S.

AUTHORIZATION CONDITIONS

- 1 WASTEWATER SYSTEM CONSTRUCTION AND INSTALLATION MUST MEET ALL CONDITIONS AND SPECIFICATIONS AS SET FORTH IN IMPROVEMENT PERMIT NO. D-7433 AND THE ATTACHED SITE PLAN WITH SYSTEM DETAILS. CONSTRUCTION AND INSTALLATION MUST ALSO MEET ALL REQUIREMENTS SET FORTH IN THE "REGULATIONS GOVERNING SANITARY SEWAGE COLLECTION, TREATMENT, AND DISPOSAL IN WAKE COUNTY" AND ANY OTHER APPLICABLE RULES AND LAWS.
- 2 THE WASTEWATER SYSTEM SHALL NOT BE COVERED OR PLACED INTO USE UNTIL INSPECTED BY THE WAKE COUNTY ENVIRONMENTAL HEALTH AND AN OPERATION PERMIT ISSUED.
- 3 ANY ALTERATION IN SITE OR SOIL CONDITIONS (INCLUDING LOCATION OF STRUCTURES AND APPURTENANCES) OR MODIFICATION IN USE, DESIGN WASTEWATER FLOW, OR WASTEWATER CHARACTERISTICS AS SPECIFIED IN THE ASSOCIATED IMPROVEMENT PERMIT AND APPLICATION, MAY VOID THIS AUTHORIZATION AND ASSOCIATED PERMITS.
- 4 OTHER CONDITIONS: 1000 GAL. TANK 2 (150'x3')
24" DEPTH


PIN #: 1617.03219386 ³¹⁻²⁷⁰⁴

Zoning HD By JL
 Approve ✓ Date 08/14/07
 Revise ✓ Use 101
 Reject ✓ MFL ✓
 Front 30 Rear 30
 Side 10 Corner ✓
 Comments:

I certify that the location of planned or existing structure(s) are accurately shown. I understand failure to locate structures in accordance with this plot plan may require the relocation of structure(s) regardless degree of completion. I hereby grant permission to Municipal/County Representatives the right of entry to make evaluations or inspections upon this property.

Wendy Costa
 Signature of Owner or Authorized Agent

0005 Lot 11
 WINTER TON DRIVE

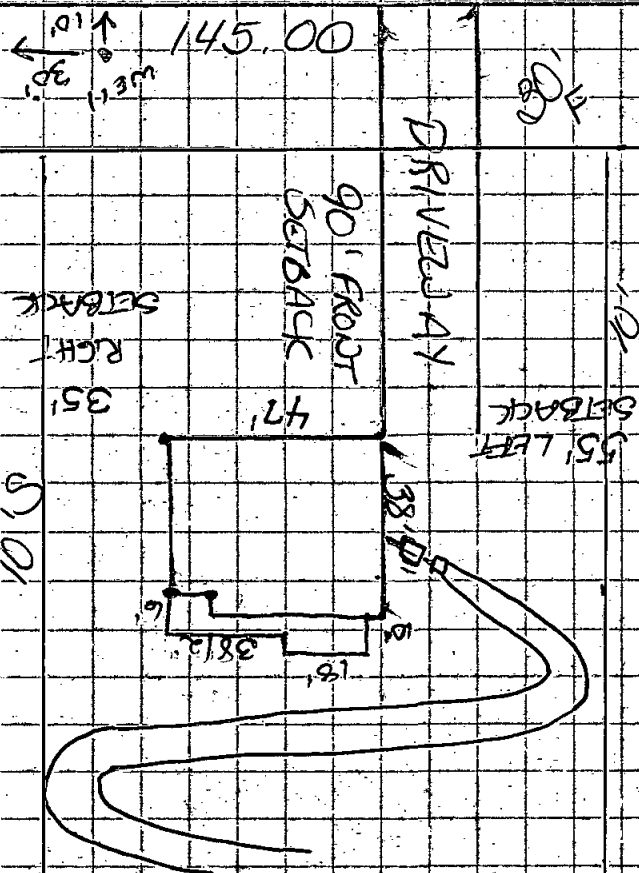

1" = 40'
 PIN # 1617-0321-9386
 0080531
 9817190
 D7433

1000 GAL TANK
 2(150' x 3')
 24" DEPTH
 *Would like to flow
 have gravity flow
 system! Will man
 house if needed.

5.00' x 11.00'

