

Environmental Services - Water Quality
Onsite Wastewater Scan Data Entry Form

PERMIT #: C019187

PIN #: 0699567142

OP DATE: 0211511995

SYSTEM USE:

- ☒ House
☐ Mobile Home
☐ Business
☐ Other

SEWAGE TYPE:

- ☒ Domestic
☐ Industrial

PUMP/SIPHON?:

- ☐ Yes
☒ No

PRESSURE MANIFOLD:

- ☐ Yes
☒ No

SYSTEM TYPE:

- ☐ I
☒ II
☐ III
☐ IV
☐ V
☐ VI
☐ Other

SUB TYPE:

- ☒ A
☐ B
☐ C
☐ D
☐ E
☐ F
☐ G

NBR BEDROOMS:

- ☐ 1
☐ 2
☒ 3
☐ 4
☐ 5
☐ 6
☐ Other

MAINT. SCHEDULE:

- ☐ Yes
☒ No

CERT. OPERATOR

- ☐ Yes
☒ No

GT	ST	PT	SIZE
☐	☐		750
☐	☐		900
☐	☒	☐	1,000
☐	☐	☐	1,200
☐	☐	☐	1,500
☐	☐	☐	1,800
☐	☐	☐	2,100
☐	☐	☐	2,500
☐	☐	☐	3,000
☐	☐	☐	4,000
☐	☐	☐	5,000
☐	☐	☐	8,000
☐	☐	☐	10,000
☐	☐	☐	Other
☒		☒	None/NA GT or PT

DRAINFIELD SIZE(SQ. FT.)

01026

DRAIN TYPE:

- ☒ Stone
☐ EZ Flow
☐ Infiltrator
☐ Biodiffuser
☐ Cultec
☐ Drip
☐ Hancor
☐ Large Dia. Pipe
☐ Multi-Pipe
☐ Other

MAX DEPTH (IN.):

- ☐ 12 in. or less
☐ 18 in. or less
☒ 24 in. or less
☐ 26 in. or less
☐ 28 in. or less
☐ 30 in. or less
☐ 32 in. or less
☐ 36 in. or less
☐ Other

STONE DEPTH (IN.):

- ☐ 8 in. or less
☒ 12 in. or less
☐ 18 in. or less
☐ 24 in. or less
☐ Other

TRENCHES:

- ☒ Individual
☐ Bed

TRENCH WIDTH (IN.):

- ☐ 12 in. or less
☐ 18 in.
☐ 24 in.
☒ 36 in.
☐ 6 ft. or less
☐ 9 ft. or less
☐ Other

B.W 9/23/14

WAKE COUNTY HEALTH DEPARTMENT WELL AND SEWAGE SITE, LOCATION PERMIT

ALL PERMITS VOID 60 MONTHS FROM DATE OF ISSUANCE

Pin # 0699.02 56 7142 Project # 0941797
 Tax Map No. 000 Parcel No. _____
 Zoning 40W Township PANTHER BRANCH
 Owner/Contractor: LYNN PARRISH BLURS.
 Location/Address: 1000 SOUTH KROLL CT.


Improvement Permit
 Well Permit No. **C 19187**
 Operation Permit []
 Date: 1/28/94

KB
1-2-15-95

Tax Map No.

Parcel No.

Subdivision Name: South Mountain Lot No. 1a Section or Block No. 1010
 S.R. # 1010

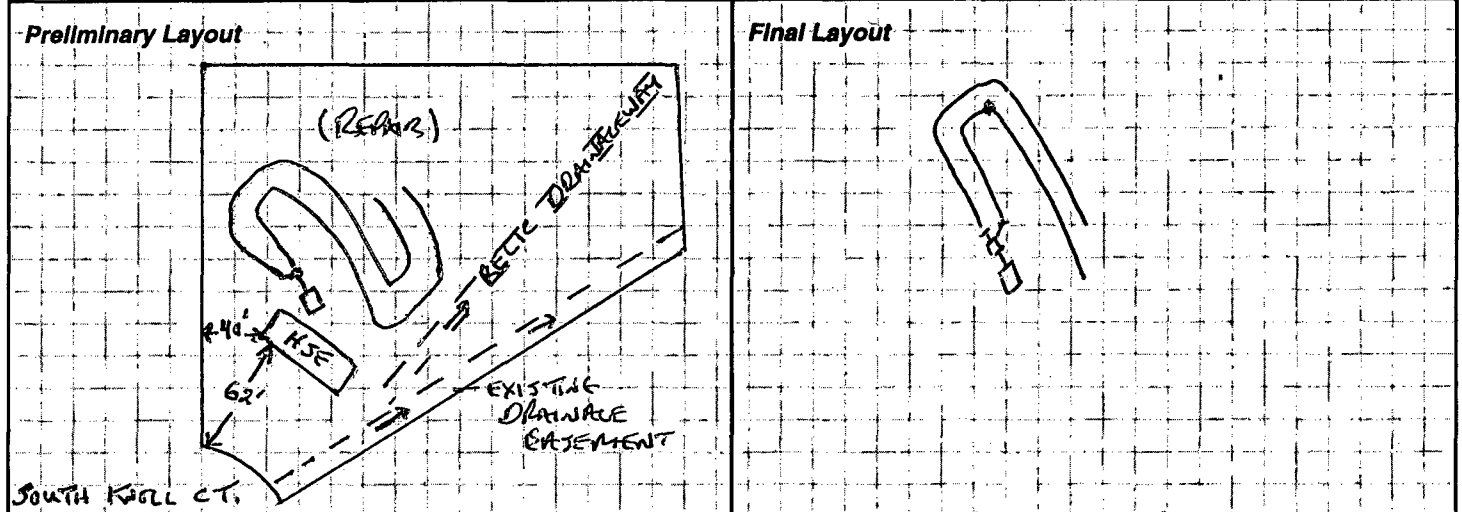

Sewage System Specifications Repair [] Original Permit No. _____ Garbage Disposal Unit Yes [] No [✓] House [✓] Mobile Home [] Business [] No. of Bedrooms <u>3</u> Lot Area <u>.96 AC</u> Size of Tank <u>55-1000</u> gal. Comments: <u>*5' IN OUT OF BETIC DRAINAGE - INSTALL ON CONTOUR</u>	Nitrification Line <u>2 (3' x 171') = 1026</u> sq. ft. Depth of Stone: 12" [✓] Max Depth of Trenches: <u>24</u> in. Riser and Baffle Required [✓] Pump Required [] ☐ Permit void if not in compliance with zoning regulations ☐ Permits may be voided if site is altered or intended use changed Layout by: <u>John E. Jones</u> EHSI
---	--

Date: 2-15-95 Installed By: Brantley Approved By: Andree C. Davis, R.S.

Well System Individual [] Semi-Public [] Public [✓] New [] Replacement [] Repair [] Fee Paid: Yes [] No [] Construction Compliance <table border="0"> <tr> <td>Site Approved</td> <td>Yes []</td> <td>No []</td> </tr> <tr> <td>Well Head Approved</td> <td>[]</td> <td>[]</td> </tr> <tr> <td>Grouting Approved</td> <td>[]</td> <td>[]</td> </tr> </table> Bacteriological Results Date Inspected _____ Sanitarian _____ Initial Sample: _____ Date: _____ * Re-Sample #1 _____ Date: _____ * Re-Sample #2 _____ Date: _____ * Re-chlorination as required [] Yes [] No * Fees for all resamples All checks payable to: Wake County Health Department	Site Approved	Yes []	No []	Well Head Approved	[]	[]	Grouting Approved	[]	[]	Final Inspection <table border="0"> <tr> <td></td> <td>Yes</td> <td>No</td> </tr> <tr> <td>Required Slab</td> <td>[]</td> <td>[]</td> </tr> <tr> <td>Chlorinated</td> <td>[]</td> <td>[]</td> </tr> <tr> <td>Required Certificate</td> <td>[]</td> <td>[]</td> </tr> <tr> <td>Variance (Explain)</td> <td>[]</td> <td>[]</td> </tr> <tr> <td>WCHD I.D. Affixed</td> <td>[]</td> <td>[]</td> </tr> <tr> <td>Sample Collected</td> <td>[]</td> <td>[]</td> </tr> </table> Comments: _____ Well Installed By: _____ Date System Finalized _____ Sanitarian _____		Yes	No	Required Slab	[]	[]	Chlorinated	[]	[]	Required Certificate	[]	[]	Variance (Explain)	[]	[]	WCHD I.D. Affixed	[]	[]	Sample Collected	[]	[]
Site Approved	Yes []	No []																													
Well Head Approved	[]	[]																													
Grouting Approved	[]	[]																													
	Yes	No																													
Required Slab	[]	[]																													
Chlorinated	[]	[]																													
Required Certificate	[]	[]																													
Variance (Explain)	[]	[]																													
WCHD I.D. Affixed	[]	[]																													
Sample Collected	[]	[]																													

This report is based in part on information provided by the homeowner or his/her representative in the application submitted for this permit. The sanitarian is not responsible for false or misleading information contained in the application. The sanitarian is also not responsible for concealed conditions on the property or for statements in this report that may have resulted from false or misleading statements provided to him in the application. Neither Wake County nor the sanitarian warrants that the septic tank system will continue to function satisfactorily in the future or that the water supply will remain potable.