



AOWE As-Built Overview

Client Information		Property Information	
Name	Drees On Your Lot	Address	9912 Sauls Road, Raleigh, NC 27603
Phone number	919-256-5457	Parcel ID	1607874114
Email Address	jharper@dreeshomes.com	Water Supply	Public
Facility Type	SFR – 5BR	New/Repair/Expansion?	New

System Information		Leach Field	
Daily Design Flow	600	Total Leach Line Length	600' (6 – 100' Lines)
# of Bedrooms	5	# of Laterals	6
LTAR	0.25	Trench Width	36"
Initial System Type	IIb	Maximum Trench Depth	18"
Repair System Classification	IIb	Manufacturer/Product	Infiltrator EZ-Flow
Subsurface Operator Required?	no	Distribution Device	Distribution Box

Septic Tank		Pump System	
Septic Tank Min. Capacity	1,500	Pump Tank Min. Capacity	N/A
Tank Manufacturer	HPPP-1500	Tank Manufacturer	N/A
Leak Test Required	Yes	Leak Test Required	N/A
Seam	Mid	Seam	N/A
Material	Concrete	Material	N/A
Access Risers	EZ-Set	Access Risers	N/A
Effluent Filter	Polylok PL-68	Pump Size	N/A
Other		Pump Manufacturer/Type	N/A



Maintenance Requirements

- Pump septic tank every 3-5 years or as necessary to ensure proper function.
- Clean effluent filter every 6 months or as necessary to ensure proper function.
- Please do not allow any traffic, construction, excavation, utilities, material storage, or any other disturbance to take place on the designated septic area or repair area. These activities may damage your septic system.
- All roof/gutter drains to be routed away from the drain field area..

Additional Notes:

Heath Clapp
AOWE Signature

3/24/2026
Date



Owners Acceptance of Wastewater System

I, Drees On Your Lot (Owner), accept the system as designed by

Agri-Waste Technology (AOWE), and installed by

Full Circle Environmental Services(Contractor).


Owner


Date

AOWE Statement

All reporting requirements in G.S. 130A-336.2(1) have been met. A list of these requirements may be found in G.S. 130A-336.2(1) *Alternative wastewater system approvals for nonengineered systems*.

v Soil and site features report included with initial NOI submittal.

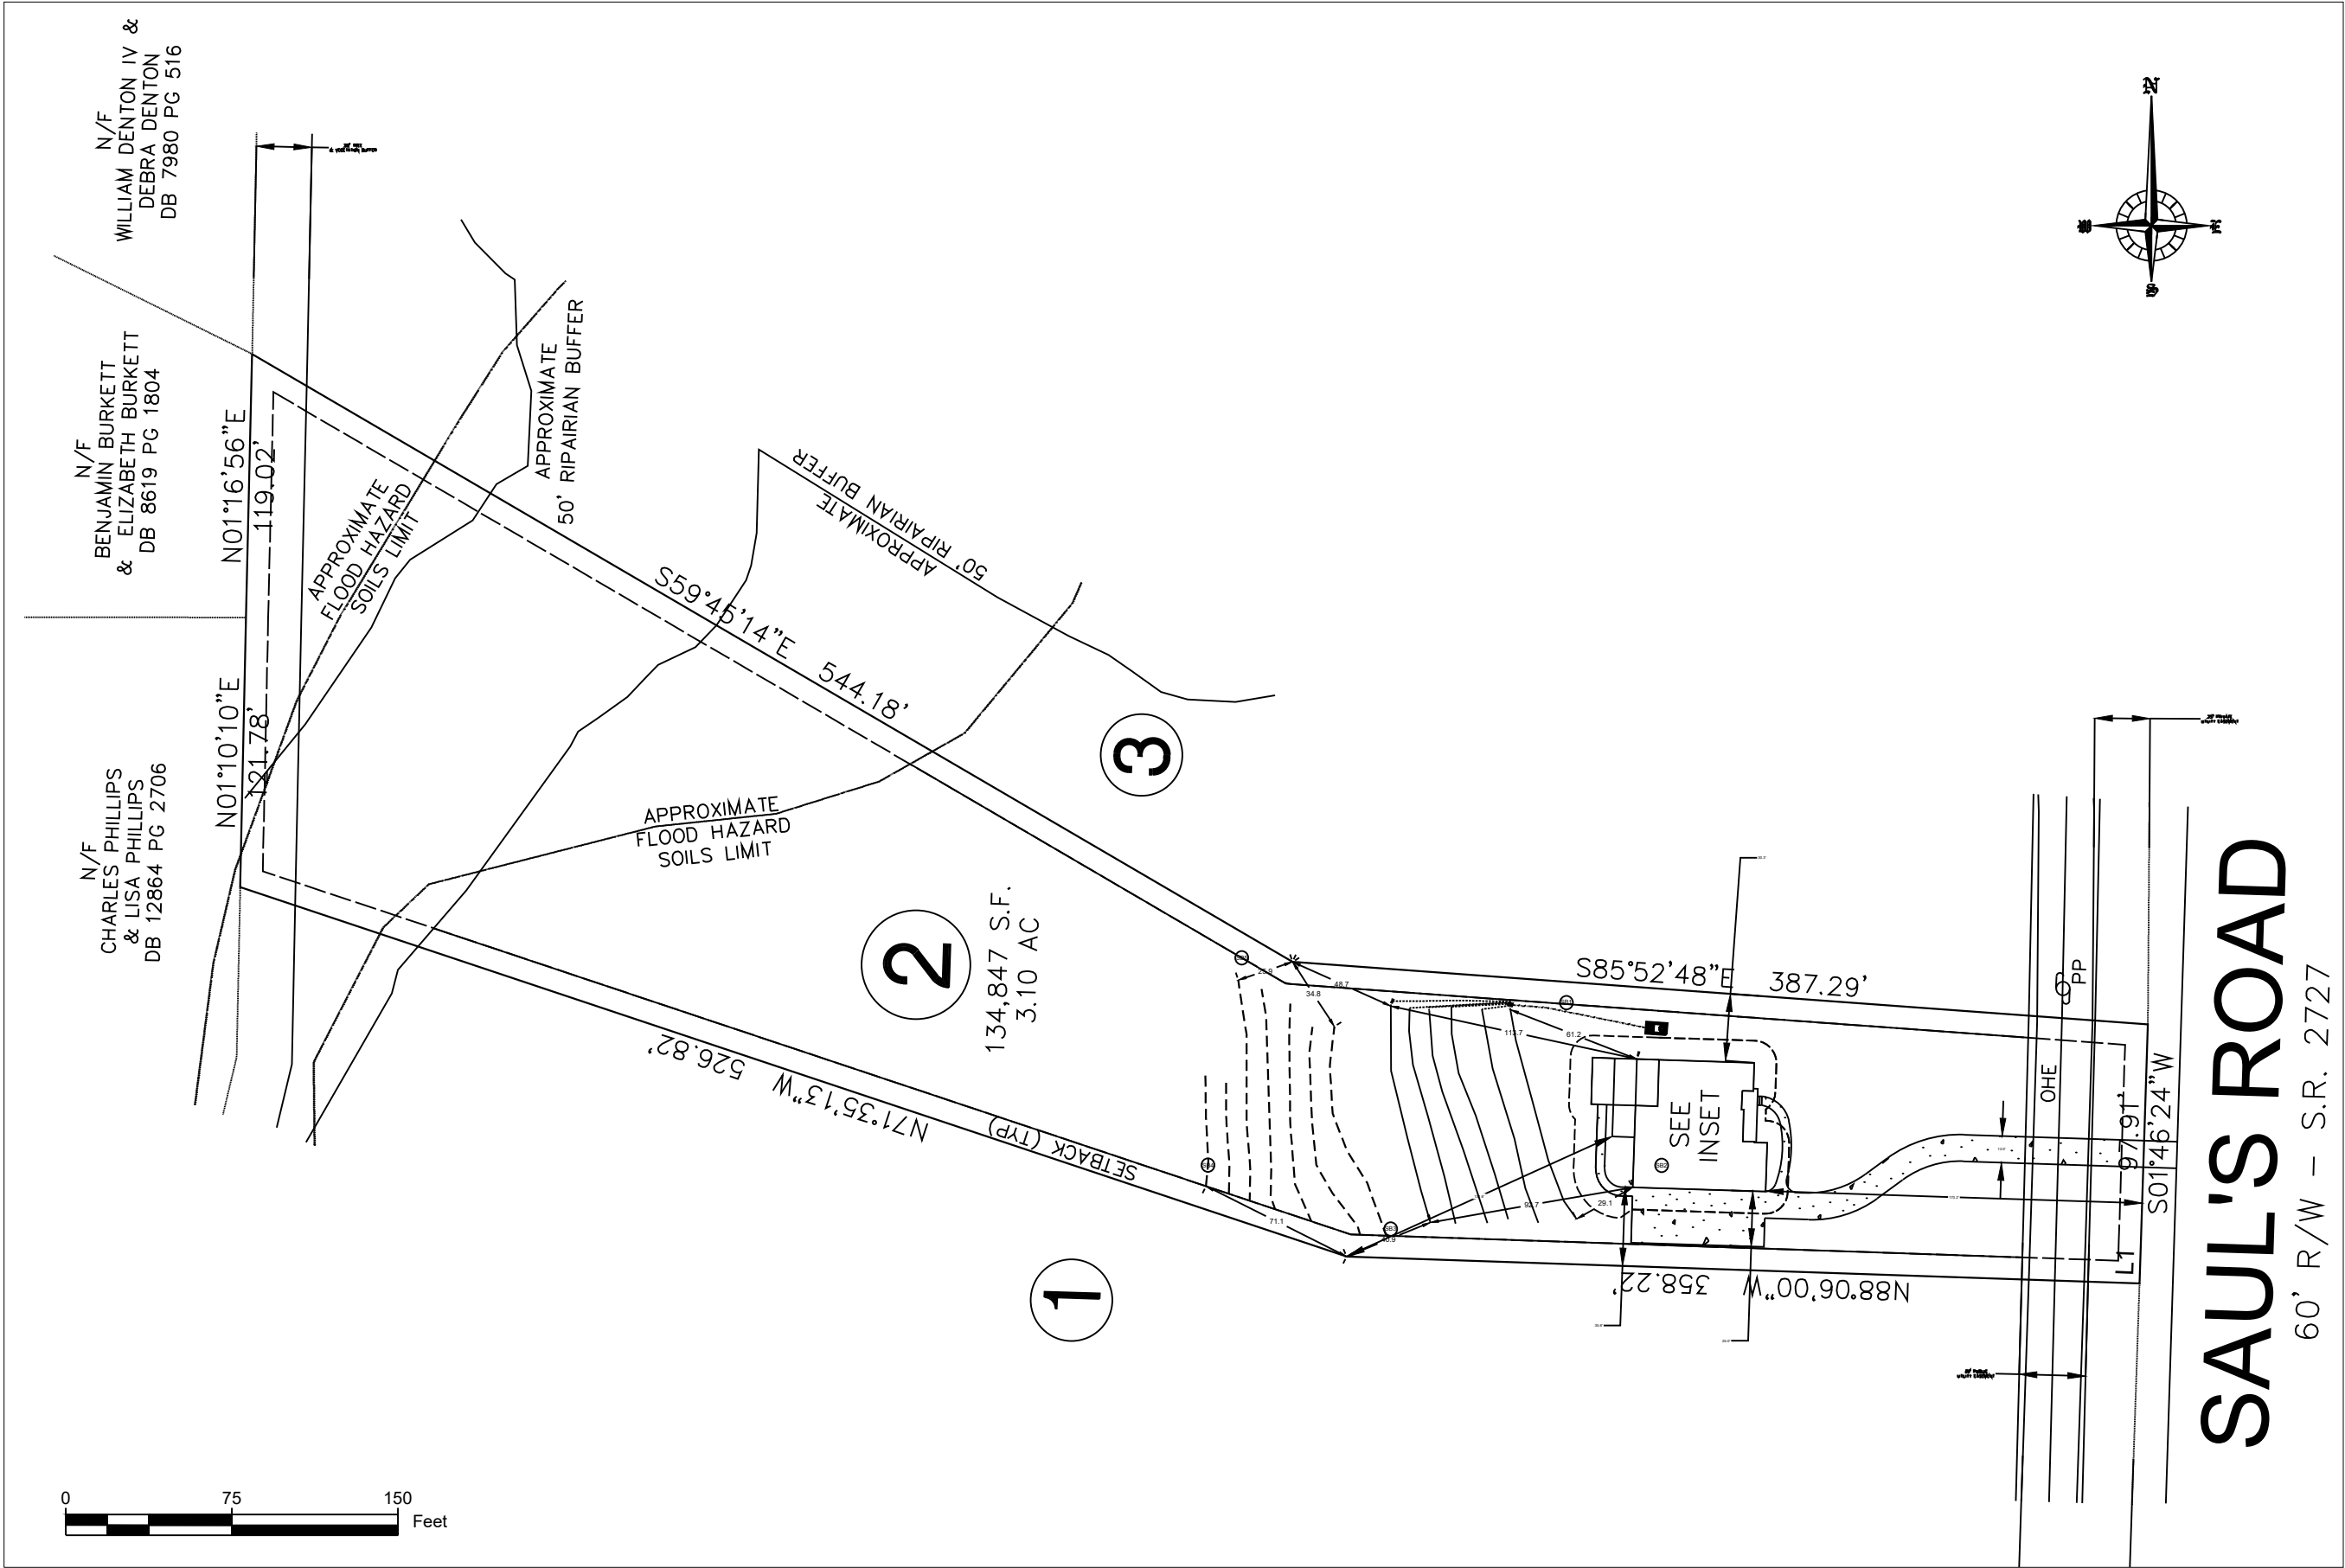

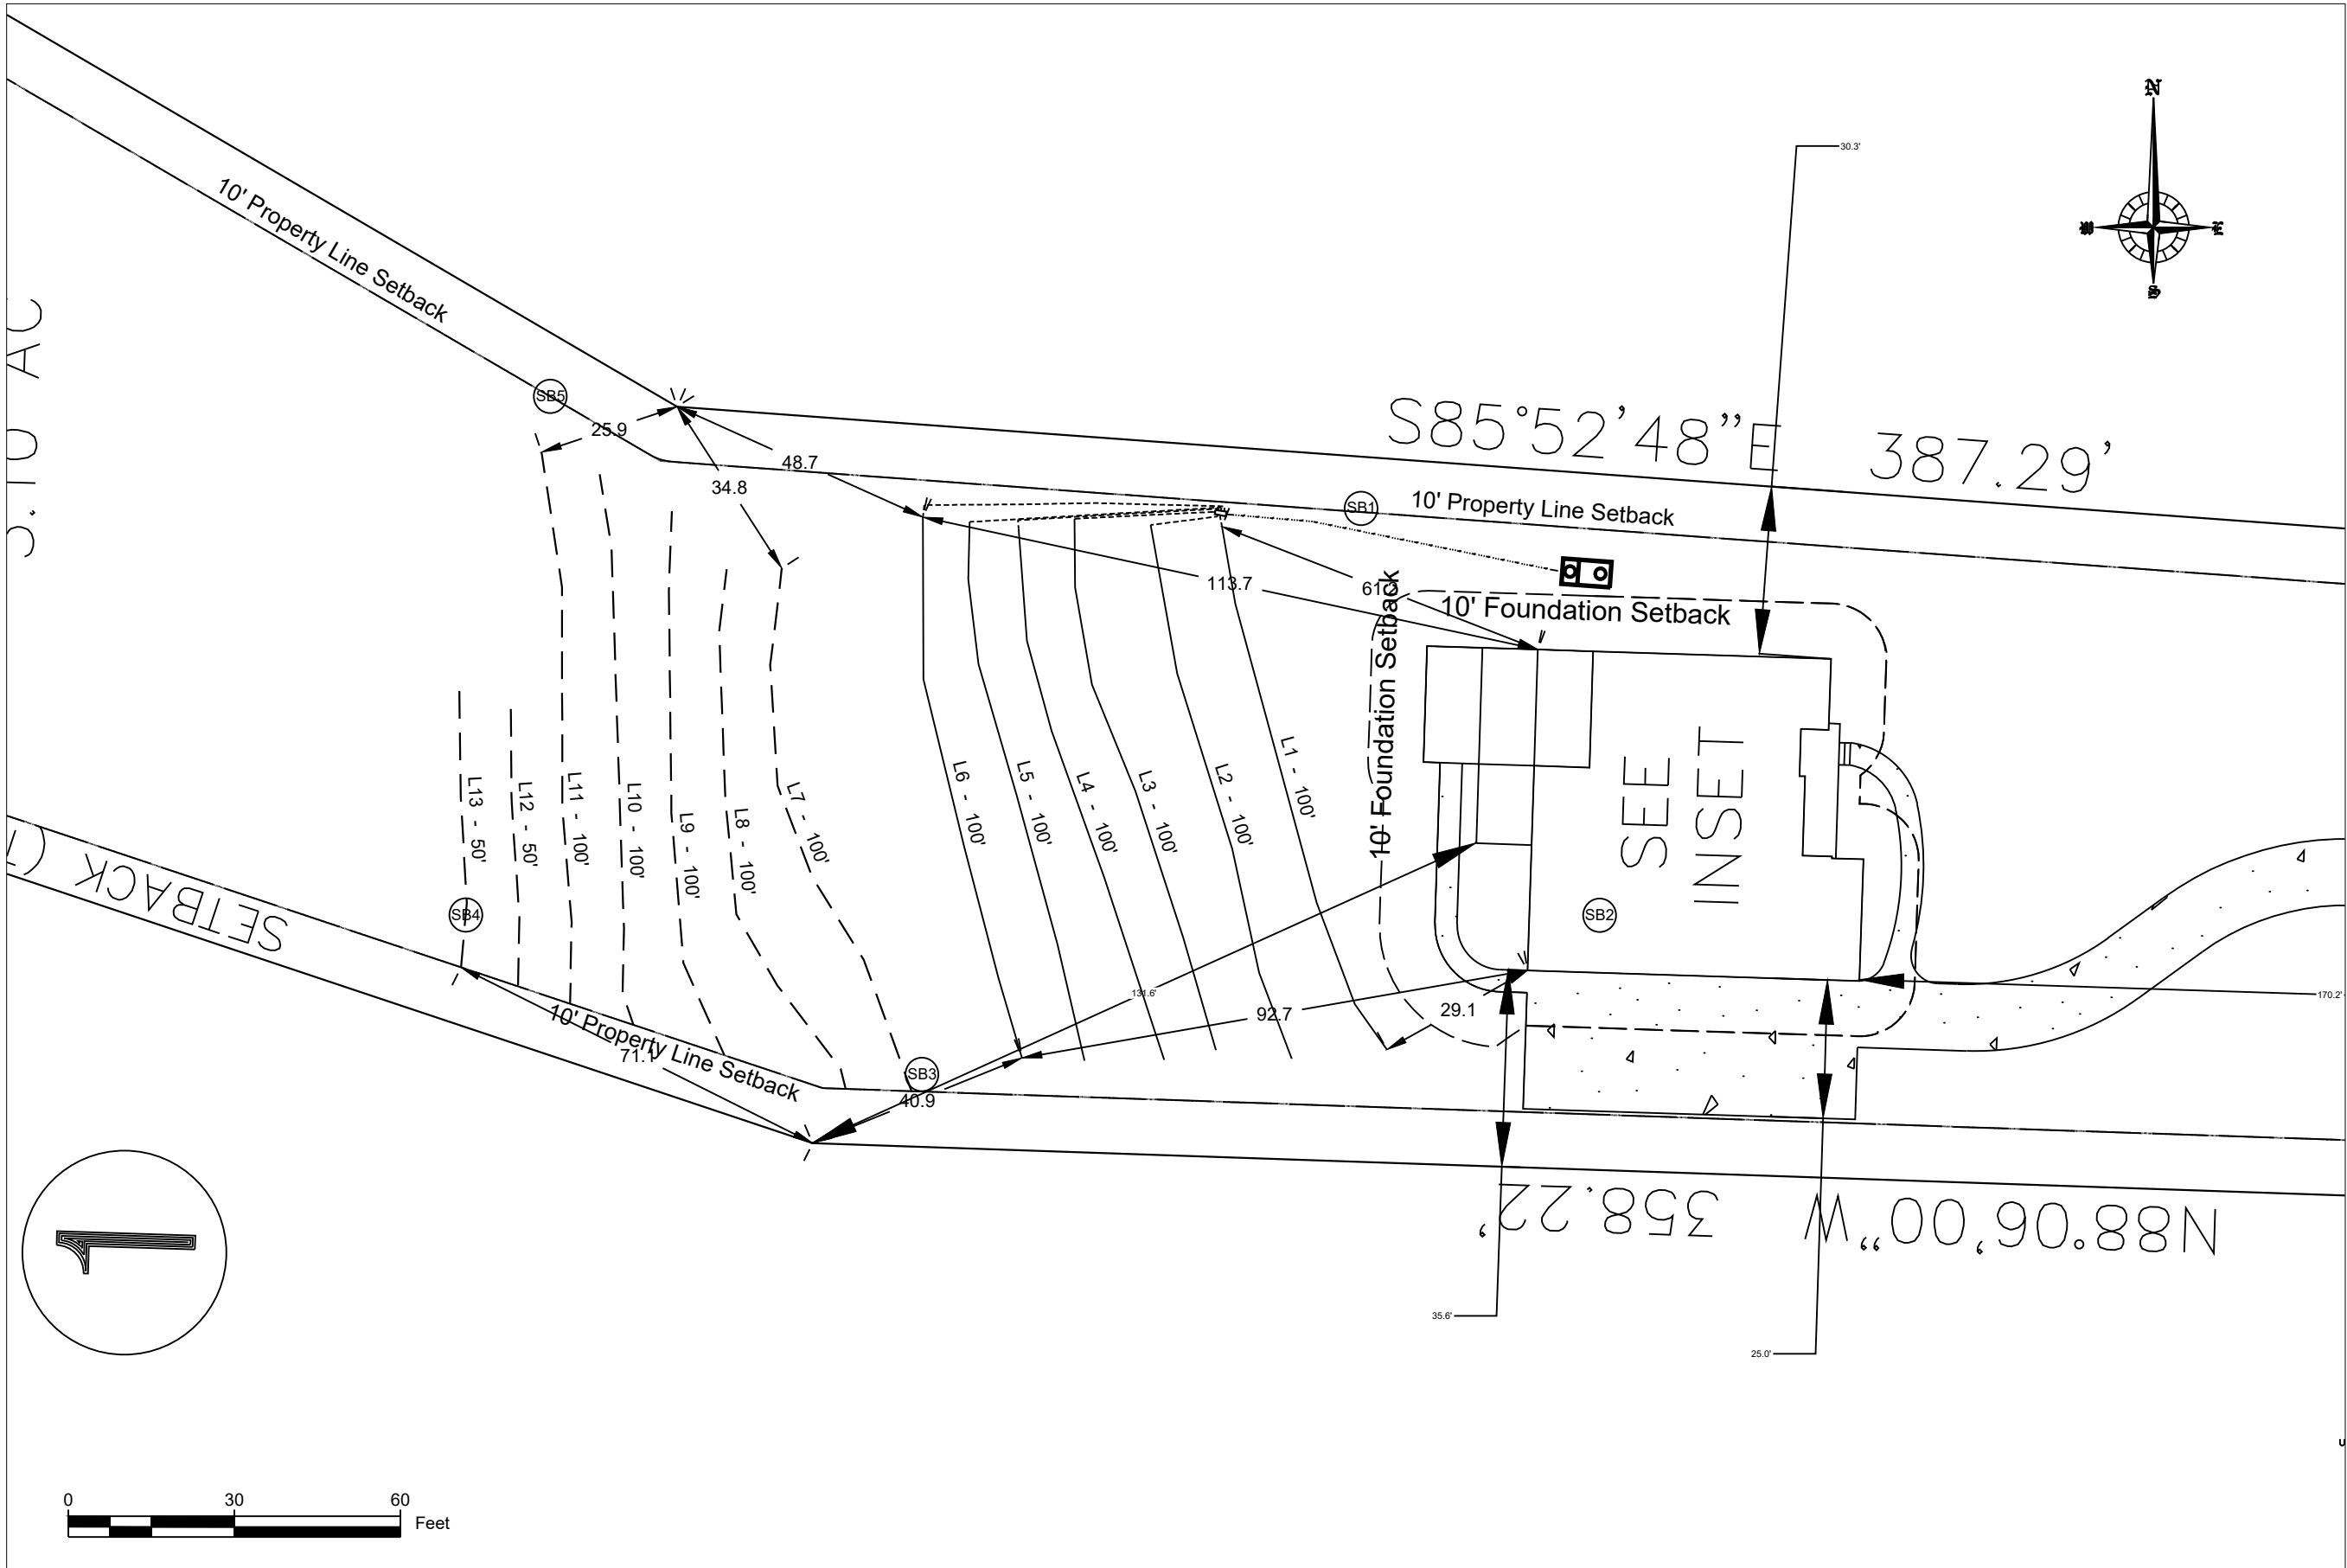

REV.	ISSUED DATE	DESCRIPTION

SHEET TITLE

Property Layout

DRAWN BY: H. Clapp	CREATED ON: 8/29/2025
REVISED BY: ####	REVISED ON: ####
RELEASED BY: ####	RELEASED ON: ####

DRAWING NUMBER

WW-2



CERTIFICATE OF LIABILITY INSURANCE

DATE (MM/DD/YYYY)

1/20/2026

THIS CERTIFICATE IS ISSUED AS A MATTER OF INFORMATION ONLY AND CONFERS NO RIGHTS UPON THE CERTIFICATE HOLDER. THIS CERTIFICATE DOES NOT AFFIRMATIVELY OR NEGATIVELY AMEND, EXTEND OR ALTER THE COVERAGE AFFORDED BY THE POLICIES BELOW. THIS CERTIFICATE OF INSURANCE DOES NOT CONSTITUTE A CONTRACT BETWEEN THE ISSUING INSURER(S), AUTHORIZED REPRESENTATIVE OR PRODUCER, AND THE CERTIFICATE HOLDER.

IMPORTANT: If the certificate holder is an ADDITIONAL INSURED, the policy(ies) must have ADDITIONAL INSURED provisions or be endorsed. If SUBROGATION IS WAIVED, subject to the terms and conditions of the policy, certain policies may require an endorsement. A statement on this certificate does not confer rights to the certificate holder in lieu of such endorsement(s).

PRODUCER Hartsfield & Nash Agency, Inc. 10405 Ligon Mill Rd., Ste H Wake Forest NC 27587	CONTACT NAME: Connie Garkalns PHONE (A/C, No, Ext): 984-235-4273 E-MAIL ADDRESS: connie@hn-ins.com	FAX (A/C, No): 919-556-8758
License#: 1000009111 AGRITEC-01		
INSURER(S) AFFORDING COVERAGE		NAIC #
INSURER A : Accident Fund		10166
INSURER B : Evanston Insurance Company		35378
INSURER C : SELECTIVE INSURANCE COMPANY		39926
INSURER D :		
INSURER E :		
INSURER F :		

COVERAGES**CERTIFICATE NUMBER:** 1861440469**REVISION NUMBER:**

THIS IS TO CERTIFY THAT THE POLICIES OF INSURANCE LISTED BELOW HAVE BEEN ISSUED TO THE INSURED NAMED ABOVE FOR THE POLICY PERIOD INDICATED. NOTWITHSTANDING ANY REQUIREMENT, TERM OR CONDITION OF ANY CONTRACT OR OTHER DOCUMENT WITH RESPECT TO WHICH THIS CERTIFICATE MAY BE ISSUED OR MAY PERTAIN, THE INSURANCE AFFORDED BY THE POLICIES DESCRIBED HEREIN IS SUBJECT TO ALL THE TERMS, EXCLUSIONS AND CONDITIONS OF SUCH POLICIES. LIMITS SHOWN MAY HAVE BEEN REDUCED BY PAID CLAIMS.

INSR LTR	TYPE OF INSURANCE	ADDL INSD	SUBR WVD	POLICY NUMBER	POLICY EFF (MM/DD/YYYY)	POLICY EXP (MM/DD/YYYY)	LIMITS
C	☒ COMMERCIAL GENERAL LIABILITY ☐ CLAIMS-MADE ☒ OCCUR GEN'L AGGREGATE LIMIT APPLIES PER: ☐ POLICY ☒ PRO-JECT ☐ LOC OTHER:			S 2253659	1/18/2026	1/18/2027	EACH OCCURRENCE \$ 2,000,000 DAMAGE TO RENTED PREMISES (Ea occurrence) \$ 300,000 MED EXP (Any one person) \$ 10,000 PERSONAL & ADV INJURY \$ 2,000,000 GENERAL AGGREGATE \$ 4,000,000 PRODUCTS - COMP/OP AGG \$ 4,000,000 \$
C	☒ AUTOMOBILE LIABILITY ☒ ANY AUTO ☐ OWNED AUTOS ONLY ☐ SCHEDULED AUTOS ☒ HIRED AUTOS ONLY ☒ NON-OWNED AUTOS ONLY			S 2253659	1/18/2026	1/18/2027	COMBINED SINGLE LIMIT (Ea accident) \$ 1,000,000 BODILY INJURY (Per person) \$ BODILY INJURY (Per accident) \$ PROPERTY DAMAGE (Per accident) \$ \$
C	☒ UMBRELLA LIAB ☒ OCCUR ☐ EXCESS LIAB ☐ CLAIMS-MADE DED RETENTION \$			S 2253659	1/18/2026	1/18/2027	EACH OCCURRENCE \$ 2,000,000 AGGREGATE \$ 2,000,000 \$
A	WORKERS COMPENSATION AND EMPLOYERS' LIABILITY ANY PROPRIETOR/PARTNER/EXECUTIVE OFFICER/MEMBER EXCLUDED? (Mandatory in NH) If yes, describe under DESCRIPTION OF OPERATIONS below	Y / N ☒ N	N / A	AFWCP10000307205	1/18/2026	1/18/2027	☒ PER STATUTE ☐ OTH-ER E.L. EACH ACCIDENT \$ 1,000,000 E.L. DISEASE - EA EMPLOYEE \$ 1,000,000 E.L. DISEASE - POLICY LIMIT \$ 1,000,000
B C	Prof & Pollution Liability Leased & Rented			MKL77ENV106760 S 2253659	8/22/2025 1/18/2026	8/22/2026 1/18/2027	Each Claim \$ 5,000,000 Equipment \$ 25,000

DESCRIPTION OF OPERATIONS / LOCATIONS / VEHICLES (ACORD 101, Additional Remarks Schedule, may be attached if more space is required)

CERTIFICATE HOLDER**CANCELLATION**

For Information Only
***Contact Agency
for Specific Holder
Wording***

SHOULD ANY OF THE ABOVE DESCRIBED POLICIES BE CANCELLED BEFORE THE EXPIRATION DATE THEREOF, NOTICE WILL BE DELIVERED IN ACCORDANCE WITH THE POLICY PROVISIONS.

AUTHORIZED REPRESENTATIVE

© 1988-2015 ACORD CORPORATION. All rights reserved.



CERTIFICATE OF LIABILITY INSURANCE

DATE (MM/DD/YYYY)

10/27/2025

THIS CERTIFICATE IS ISSUED AS A MATTER OF INFORMATION ONLY AND CONFERS NO RIGHTS UPON THE CERTIFICATE HOLDER. THIS CERTIFICATE DOES NOT AFFIRMATIVELY OR NEGATIVELY AMEND, EXTEND OR ALTER THE COVERAGE AFFORDED BY THE POLICIES BELOW. THIS CERTIFICATE OF INSURANCE DOES NOT CONSTITUTE A CONTRACT BETWEEN THE ISSUING INSURER(S), AUTHORIZED REPRESENTATIVE OR PRODUCER, AND THE CERTIFICATE HOLDER.

IMPORTANT: If the certificate holder is an **ADDITIONAL INSURED**, the policy(ies) must have **ADDITIONAL INSURED** provisions or be endorsed. If **SUBROGATION** IS **WAIVED**, subject to the terms and conditions of the policy, certain policies may require an endorsement. A statement on this certificate does not confer rights to the certificate holder in lieu of such endorsement(s).

PRODUCER Bearing Insurance Group, LLC P. O. Box 9953 Glen Allen VA 23058	CONTACT NAME: Blair Comer PHONE (A/C, No, Ext): 3362800317 E-MAIL ADDRESS: bcomer@bankersinsurance.net FAX (A/C, No):
License#: 6387078 FULLCIR-02	INSURER(S) AFFORDING COVERAGE INSURER A: Frankenmuth Insurance Company INSURER B: INSURER C: INSURER D: INSURER E: INSURER F:
INSURED Full Circle Environmental Services LLC 381 Cleveland Crossing Dr Garner NC 27529	NAIC # 13986

COVERAGES

CERTIFICATE NUMBER: 422747140

REVISION NUMBER:

THIS IS TO CERTIFY THAT THE POLICIES OF INSURANCE LISTED BELOW HAVE BEEN ISSUED TO THE INSURED NAMED ABOVE FOR THE POLICY PERIOD INDICATED. NOTWITHSTANDING ANY REQUIREMENT, TERM OR CONDITION OF ANY CONTRACT OR OTHER DOCUMENT WITH RESPECT TO WHICH THIS CERTIFICATE MAY BE ISSUED OR MAY PERTAIN, THE INSURANCE AFFORDED BY THE POLICIES DESCRIBED HEREIN IS SUBJECT TO ALL THE TERMS, EXCLUSIONS AND CONDITIONS OF SUCH POLICIES. LIMITS SHOWN MAY HAVE BEEN REDUCED BY PAID CLAIMS.

INSR LTR	TYPE OF INSURANCE	ADDL INSD	SUBR WVD	POLICY NUMBER	POLICY EFF (MM/DD/YYYY)	POLICY EXP (MM/DD/YYYY)	LIMITS
A	☒ COMMERCIAL GENERAL LIABILITY ☐ CLAIMS-MADE ☒ OCCUR GEN'L AGGREGATE LIMIT APPLIES PER: ☐ POLICY ☐ PRO-JECT ☐ LOC OTHER:			6744083	7/9/2025	7/9/2026	EACH OCCURRENCE \$ 1,000,000 DAMAGE TO RENTED PREMISES (Ea occurrence) \$ 1,000,000 MED EXP (Any one person) \$ 10,000 PERSONAL & ADV INJURY \$ 1,000,000 GENERAL AGGREGATE \$ 2,000,000 PRODUCTS - COMP/OP AGG \$ 2,000,000 \$
	AUTOMOBILE LIABILITY ☐ ANY AUTO ☐ OWNED AUTOS ONLY ☐ SCHEDULED AUTOS ☐ HIRED AUTOS ONLY ☐ NON-OWNED AUTOS ONLY						COMBINED SINGLE LIMIT (Ea accident) \$ BODILY INJURY (Per person) \$ BODILY INJURY (Per accident) \$ PROPERTY DAMAGE (Per accident) \$ \$
A	☒ UMBRELLA LIAB ☐ EXCESS LIAB ☐ OCCUR ☐ CLAIMS-MADE DED ☒ RETENTION \$ 10,000			6744083	7/9/2025	7/9/2026	EACH OCCURRENCE \$ 4,000,000 AGGREGATE \$ \$
A	WORKERS COMPENSATION AND EMPLOYERS' LIABILITY ANY PROPRIETOR/PARTNER/EXECUTIVE OFFICER/MEMBER EXCLUDED? (Mandatory in NH) If yes, describe under DESCRIPTION OF OPERATIONS below Y / N ☐ N / A			6744082	7/9/2025	7/9/2026	X PER STATUTE ☐ OTH-ER ☐ E.L. EACH ACCIDENT \$ 1,000,000 E.L. DISEASE - EA EMPLOYEE \$ 1,000,000 E.L. DISEASE - POLICY LIMIT \$ 1,000,000

DESCRIPTION OF OPERATIONS / LOCATIONS / VEHICLES (ACORD 101, Additional Remarks Schedule, may be attached if more space is required)

CERTIFICATE HOLDER**CANCELLATION**

Agri Waste Technology
501 N Salem Street, Suite 203
Apex NC 27502

SHOULD ANY OF THE ABOVE DESCRIBED POLICIES BE CANCELLED BEFORE THE EXPIRATION DATE THEREOF, NOTICE WILL BE DELIVERED IN ACCORDANCE WITH THE POLICY PROVISIONS.

AUTHORIZED REPRESENTATIVE

© 1988-2015 ACORD CORPORATION. All rights reserved.