

Environmental Services - Water Quality
Onsite Wastewater Scan Data Entry Form

PERMIT #: D007940

PIN #: 0697684883

OP DATE: 031311998

SYSTEM USE:

- ☒ House
☐ Mobile Home
☐ Business
☐ Other

SEWAGE TYPE:

- ☒ Domestic
☐ Industrial

PUMP/SIPHON?:

- ☐ Yes
☒ No

PRESSURE MANIFOLD:

- ☐ Yes
☒ No

SYSTEM TYPE:

- ☐ I
☒ II
☐ III
☐ IV
☐ V
☐ VI
☐ Other

SUB TYPE:

- ☒ A
☐ B
☐ C
☐ D
☐ E
☐ F
☐ G

NBR BEDROOMS:

- ☐ 1
☐ 2
☒ 3
☐ 4
☐ 5
☐ 6
☐ Other

MAINT. SCHEDULE:

- ☐ Yes
☒ No

CERT. OPERATOR

- ☐ Yes
☒ No

GT ST PT SIZE

- | | | | |
|-------------------------------------|-------------------------------------|-------------------------------------|------------------|
| ☐ | ☐ | ☐ | 750 |
| ☐ | ☐ | ☐ | 900 |
| ☐ | ☒ | ☐ | 1,000 |
| ☐ | ☐ | ☐ | 1,200 |
| ☐ | ☐ | ☐ | 1,500 |
| ☐ | ☐ | ☐ | 1,800 |
| ☐ | ☐ | ☐ | 2,100 |
| ☐ | ☐ | ☐ | 2,500 |
| ☐ | ☐ | ☐ | 3,000 |
| ☐ | ☐ | ☐ | 4,000 |
| ☐ | ☐ | ☐ | 5,000 |
| ☐ | ☐ | ☐ | 8,000 |
| ☐ | ☐ | ☐ | 10,000 |
| ☐ | ☐ | ☐ | Other |
| ☒ | | ☒ | None/NA GT or PT |

DRAINFIELD SIZE(SQ. FT.)

00900

DRAIN TYPE:

- ☐ Stone
☒ EZ Flow
☐ Infiltrator
☐ Biodiffuser
☐ Cultec
☐ Drip
☐ Hancor
☐ Large Dia. Pipe
☐ Multi-Pipe
☐ Other

MAX DEPTH (IN.):

- ☐ 12 in. or less
☐ 18 in. or less
☒ 24 in. or less
☐ 26 in. or less
☐ 28 in. or less
☐ 30 in. or less
☐ 32 in. or less
☐ 36 in. or less
☐ Other

STONE DEPTH (IN.):

- ☐ 8 in. or less
☐ 12 in. or less
☐ 18 in. or less
☐ 24 in. or less
☒ Other

TRENCHES:

- ☒ Individual
☐ Bed

TRENCH WIDTH (IN.):

- ☐ 12 in. or less
☐ 18 in.
☐ 24 in.
☐ 36 in.
☐ 6 ft. or less
☐ 9 ft. or less
☒ Other

[Handwritten signature]

★ NOT FOR WASTEWATER SYSTEM CONSTRUCTION ★
WAKE COUNTY ENVIRONMENTAL HEALTH WELL AND SEWAGE SITE, LOCATION PERMIT

No PERMIT(s) FOR CONSTRUCTION, LOCATION OR RELOCATION ACTIVITY SHALL BE ISSUED
 UNTIL AN AUTHORIZATION FOR WASTEWATER SYSTEM CONSTRUCTION HAS BEEN ISSUED.

Pin # 0697.02683404 Project # 0981156
 Tax Map No. _____ Parcel No. _____
 Zoning WAVE Township PARTNER BRANCH
 Owner/Contractor: LOUIS CLECHIA
 Location/Address: 936 E BRIDGE DRIVE

Improvement Permit
 Well Permit No. **D** -7940
 Operation Permit []
 Date: 11/10/97

Subdivision Name: WORTHINGTON Lot No. 87 Section or Block No. _____
 S.R. # _____

Preliminary Layout SEE ATTACHED PLOT PLAN FOR WASTEWATER DISPOSAL SITE. SEE CONSTRUCTION AUTHORIZATION FOR WASTEWATER SYSTEM DESIGN.	Final Layout * NOTE CHANGE IN DRIVEWAY LOCATION E2 FLOW IMPROVEMENT → 2 200 #
--	---

Sewage System Specifications Repair [] Original Permit No. _____ Garbage Disposal Unit Yes [] No [✓] House [✓] Mobile Home [] Business [] No. of Bedrooms <u>3</u> Lot Area <u>1.49 ac.</u> Size of Tank <u>1,000</u> gal. Wastewater: Sewage [✓] Industrial [] Comments: <u>IMPERATIVE THAT SEPTIC TANK BE SET SHALLOW TO MAINTAIN TRENCH DEPTH</u> Date: <u>3/31/98</u> Installed By: <u>TIM PERRY</u> Approved By: <u>RODNEY R/S</u>	Nitrification Line _____ sq. ft. Depth of Stone: 12" [✓] Max Depth of Trenches: <u>20</u> in. Riser and Baffle Required [✓] Pump Required [] • Permit void if not in compliance with zoning regulations • Permits may be voided if site is altered or intended use changed Layout by: <u>[Signature]</u>
---	---

Well System Individual [] Semi-Public [] Public [✓] New [] Replacement [] Repair [] Fee Paid: Yes [] No [] Construction Compliance <table style="width: 100%;"> <tr> <th></th> <th>Yes</th> <th>No</th> </tr> <tr> <td>Site Approved</td> <td>[]</td> <td>[]</td> </tr> <tr> <td>Well Head Approved</td> <td>[]</td> <td>[]</td> </tr> <tr> <td>Grouting Approved</td> <td>[]</td> <td>[]</td> </tr> </table> Date Inspected _____ Sanitarian _____ Bacteriological Results Initial Sample: _____ Date: _____ * Re-Sample #1 _____ Date: _____ * Re-Sample #2 _____ Date: _____ * Re-chlorination as required [] Yes [] No * Fees for all resamples All checks payable to: Wake County		Yes	No	Site Approved	[]	[]	Well Head Approved	[]	[]	Grouting Approved	[]	[]	Final Inspection <table style="width: 100%;"> <tr> <th></th> <th>Yes</th> <th>No</th> </tr> <tr> <td>Required Slab</td> <td>[]</td> <td>[]</td> </tr> <tr> <td>Chlorinated</td> <td>[]</td> <td>[]</td> </tr> <tr> <td>Required Certificate</td> <td>[]</td> <td>[]</td> </tr> <tr> <td>Variance (Explain)</td> <td>[]</td> <td>[]</td> </tr> <tr> <td>WCHD I.D. Affixed</td> <td>[]</td> <td>[]</td> </tr> <tr> <td>Sample Collected</td> <td>[]</td> <td>[]</td> </tr> </table> Comments: _____ Well Installed By: _____ Date System Finalized _____ Sanitarian _____		Yes	No	Required Slab	[]	[]	Chlorinated	[]	[]	Required Certificate	[]	[]	Variance (Explain)	[]	[]	WCHD I.D. Affixed	[]	[]	Sample Collected	[]	[]
	Yes	No																																
Site Approved	[]	[]																																
Well Head Approved	[]	[]																																
Grouting Approved	[]	[]																																
	Yes	No																																
Required Slab	[]	[]																																
Chlorinated	[]	[]																																
Required Certificate	[]	[]																																
Variance (Explain)	[]	[]																																
WCHD I.D. Affixed	[]	[]																																
Sample Collected	[]	[]																																

This report is based in part on information provided by the homeowner or his/her representative in the application submitted for this permit. The sanitarian is not responsible for false or misleading information contained in the application. The sanitarian is also not responsible for concealed conditions on the property or for statements in this report that may have resulted from false or misleading statements provided to him in the application. Neither Wake County nor the sanitarian warrants that the septic tank system will continue to function satisfactorily in the future or that the water supply will remain potable.

AUTHORIZATION FOR WASTEWATER SYSTEM CONSTRUCTION
VOID SIXTY(60) MONTHS FROM DATE OF ISSUANCE

0981156

DATE: <u>11/6/27</u>		IMPROVEMENT PERMIT NO.: <u>D-7940</u>	
TAX MAP NO.: _____	PARCEL NO.: _____	PIN NO.: <u>0697.02683404</u>	
OWNER/CONTRACTOR: <u>JOHN CRECHANO</u>			
LOCATION/ADDRESS: <u>936 EUBANK DRIVE</u>			
SUBDIVISION NAME: _____			
LOT NO.: _____		SECTION OR BLOCK NO.: _____	
AUTHORIZATION ISSUED BY: <u>[Signature]</u>			

PIN #:

AUTHORIZATION CONDITIONS

- 1 WASTEWATER SYSTEM CONSTRUCTION AND INSTALLATION MUST MEET ALL CONDITIONS AND SPECIFICATIONS AS SET FORTH IN IMPROVEMENT PERMIT NO. D-7940 AND THE ATTACHED SITE PLAN WITH SYSTEM DETAILS. CONSTRUCTION AND INSTALLATION MUST ALSO MEET ALL REQUIREMENTS SET FORTH IN THE "REGULATIONS GOVERNING SANITARY SEWAGE COLLECTION, TREATMENT, AND DISPOSAL IN WAKE COUNTY" AND ANY OTHER APPLICABLE RULES AND LAWS.
- 2 THE WASTEWATER SYSTEM SHALL NOT BE COVERED OR PLACED INTO USE UNTIL INSPECTED BY THE WAKE COUNTY DEPARTMENT OF HEALTH AND AN OPERATION PERMIT ISSUED.
- 3 ANY ALTERATION IN SITE OR SOIL CONDITIONS (INCLUDING LOCATION OF STRUCTURES AND APPURTENANCES) OR MODIFICATION IN USE, DESIGN WASTEWATER FLOW, OR WASTEWATER CHARACTERISTICS AS SPECIFIED IN THE ASSOCIATED IMPROVEMENT PERMIT AND APPLICATION, MAY VOID THIS AUTHORIZATION AND ASSOCIATED PERMITS.
- 4 OTHER CONDITIONS: _____

CONTRACTOR TO ESTABLISH AND FOLLOW CONTOUR
SEE ATTACHED PLOT PLAN FOR DESIGN AND LOCATION OF SYSTEM


SEPTIC TANK 1,000 gal.
PUMP TANK _____ gal.

MAXIMUM TRENCH DEPTH 20 inches
NUMBER OF TRENCHES 3
LENGTH OF TRENCHES 140 feet
WIDTH OF TRENCHES 3 feet
AMOUNT OF STONE * inches

*USE APPROPRIATE INNOVATIVE

CALL STEVE SMITH @ 856-7441 Prior
to Installation.

EVIDENCE

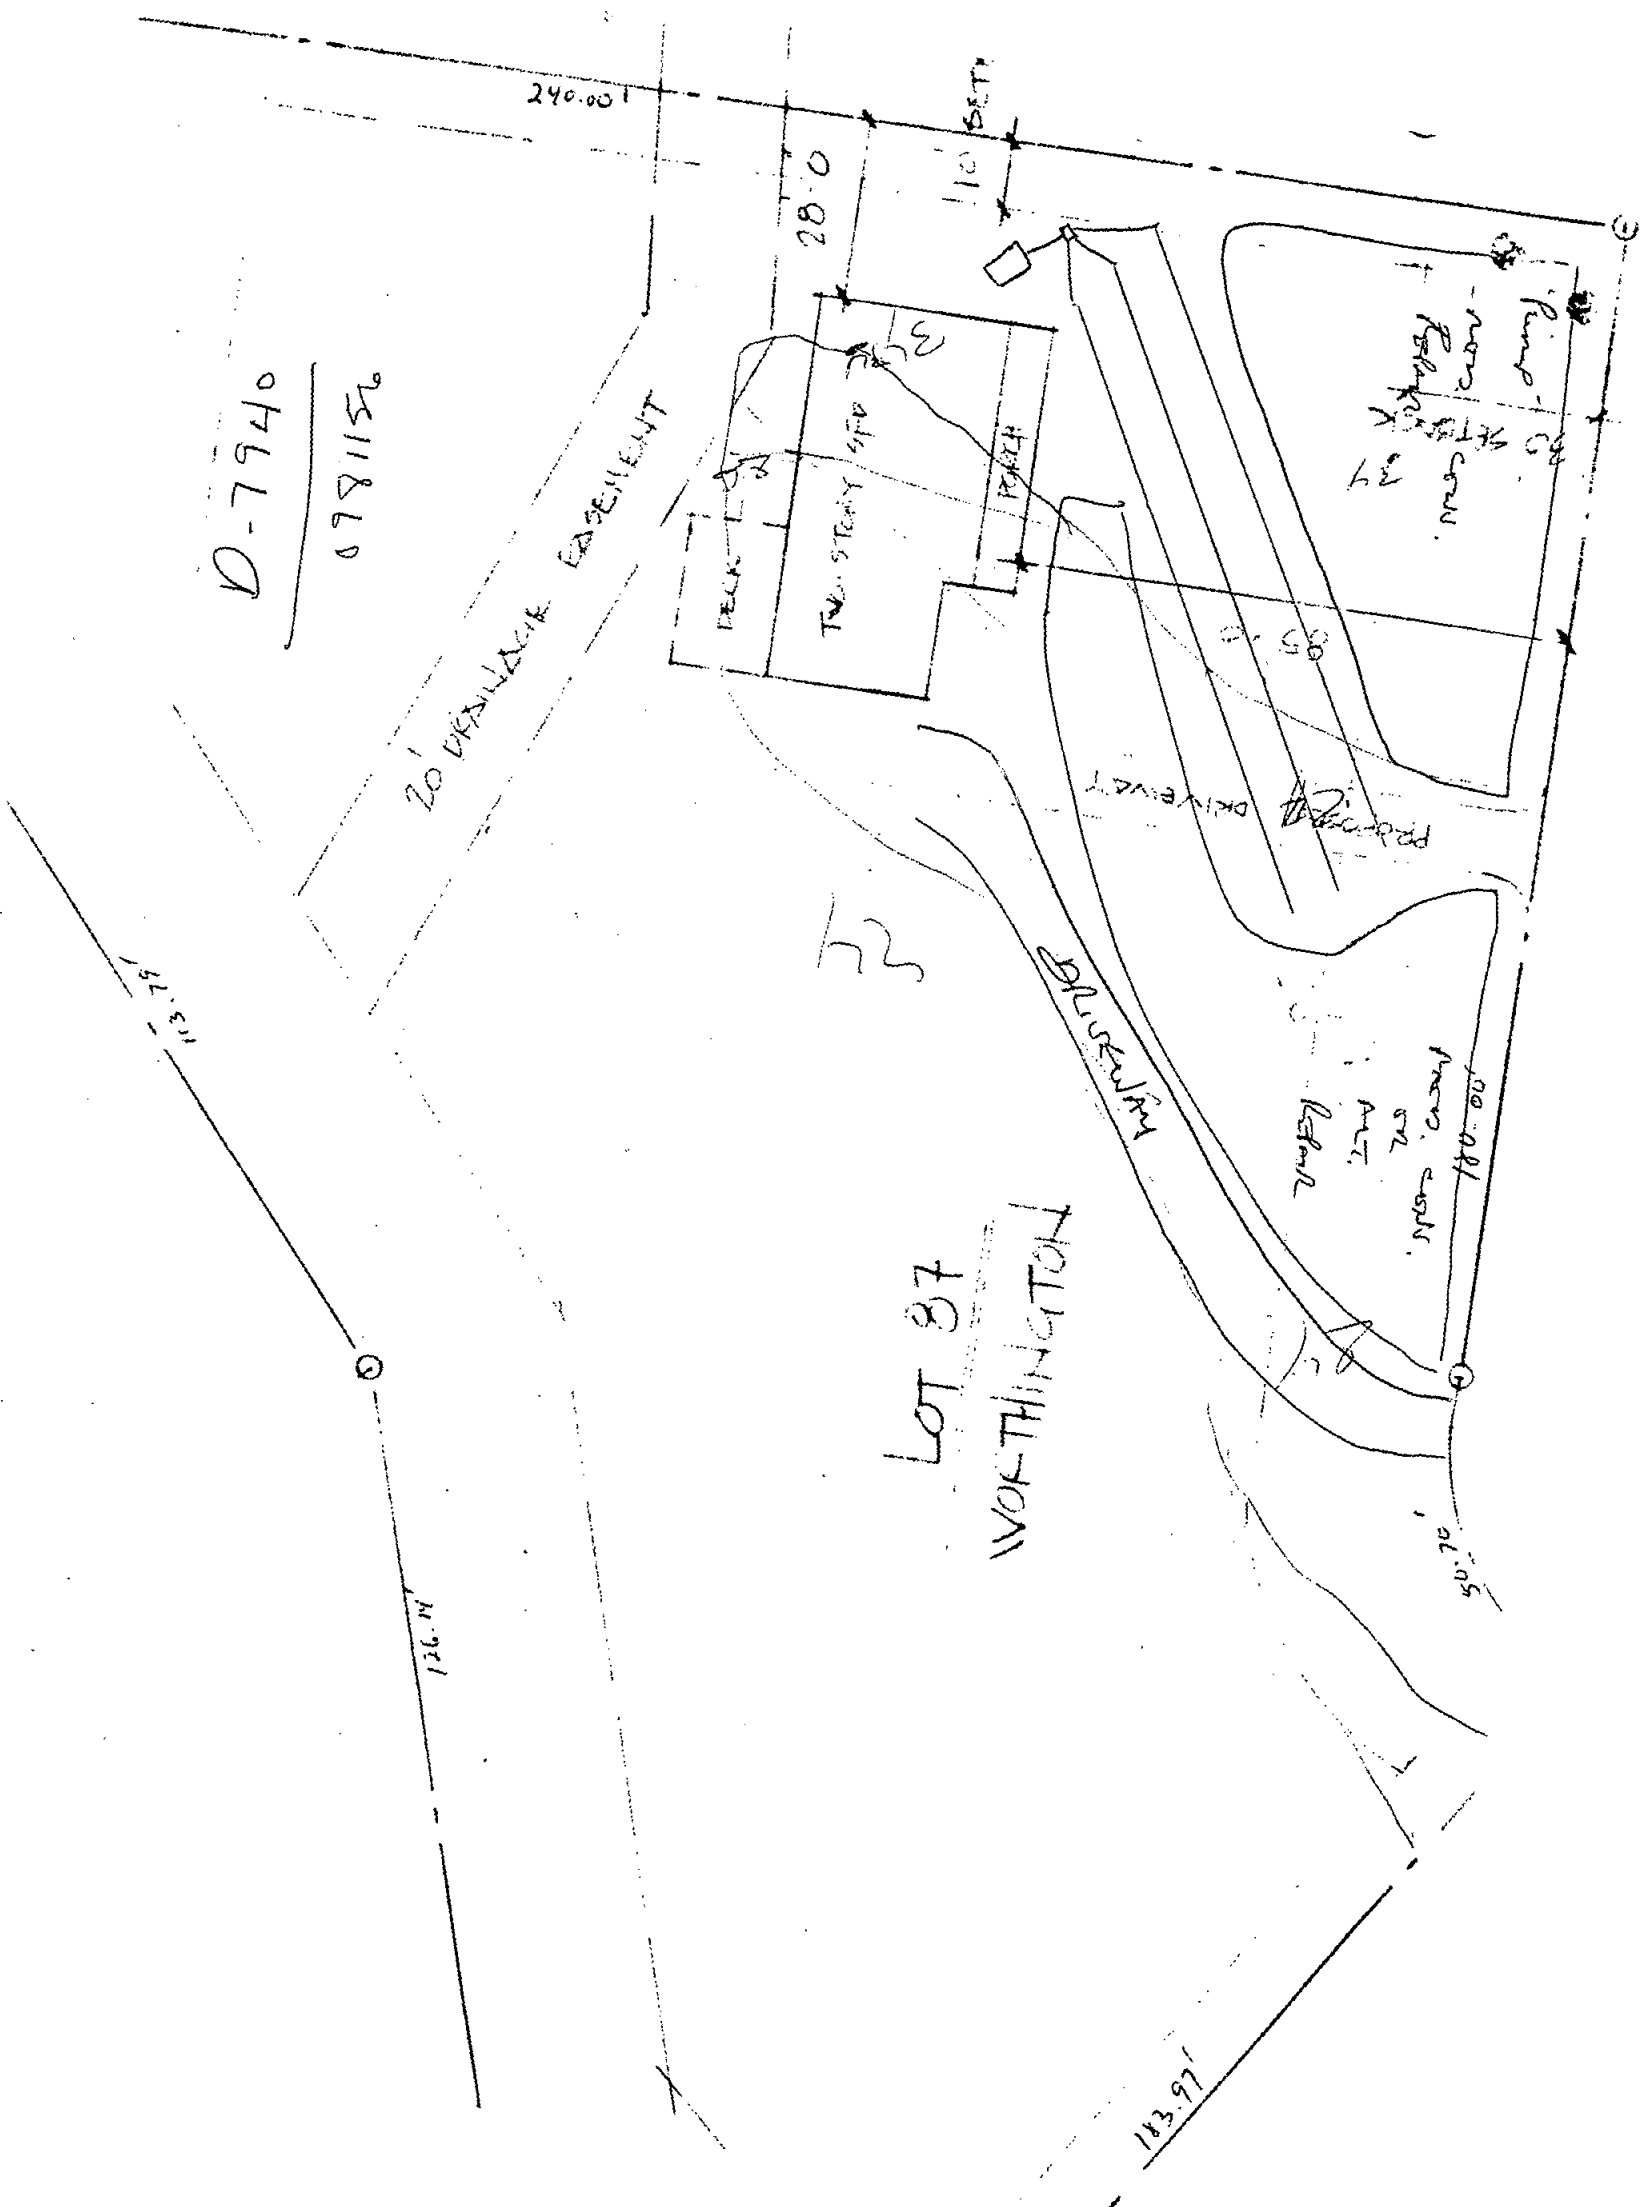

D-7940
0781156

LOT 37
WORTHINGTON

20' DRAINAGE EASEMENT

TR. STAIRS

DRIVEWAY

Pond

Pond

131.31'

126.00'

183.97'

100.00'

240.00'

28.0'

110' SETBACK

LOT 37

WORTHINGTON