

Environmental Services - Water Quality
Onsite Wastewater Scan Data Entry Form

PERMIT #: 1016484

PIN #: 0696792679

OP DATE: 0511811993

SYSTEM USE:

- ☒ House
☐ Mobile Home
☐ Business
☐ Other

SEWAGE TYPE:

- ☒ Domestic
☐ Industrial

PUMP/SIPHON?:

- ☐ Yes
☒ No

PRESSURE MANIFOLD:

- ☐ Yes
☒ No

SYSTEM TYPE:

- ☐ I
☒ II
☐ III
☐ IV
☐ V
☐ VI
☐ Other

SUB TYPE:

- ☒ A
☐ B
☐ C
☐ D
☐ E
☐ F
☐ G

NBR BEDROOMS:

- ☐ 1
☐ 2
☒ 3
☐ 4
☐ 5
☐ 6
☐ Other

MAINT. SCHEDULE:

- ☐ Yes
☒ No

CERT. OPERATOR

- ☐ Yes
☒ No

GT ST PT SIZE

- | | | | |
|-------------------------------------|-------------------------------------|-------------------------------------|------------------|
| ☐ | ☐ | ☐ | 750 |
| ☐ | ☐ | ☐ | 900 |
| ☐ | ☒ | ☐ | 1,000 |
| ☐ | ☐ | ☐ | 1,200 |
| ☐ | ☐ | ☐ | 1,500 |
| ☐ | ☐ | ☐ | 1,800 |
| ☐ | ☐ | ☐ | 2,100 |
| ☐ | ☐ | ☐ | 2,500 |
| ☐ | ☐ | ☐ | 3,000 |
| ☐ | ☐ | ☐ | 4,000 |
| ☐ | ☐ | ☐ | 5,000 |
| ☐ | ☐ | ☐ | 8,000 |
| ☐ | ☐ | ☐ | 10,000 |
| ☐ | ☐ | ☐ | Other |
| ☒ | | ☒ | None/NA GT or PT |

DRAINFIELD SIZE(SQ. FT.)

01035

DRAIN TYPE:

- ☒ Stone
☐ EZ Flow
☐ Infiltrator
☐ Biodiffuser
☐ Cultec
☐ Drip
☐ Hancor
☐ Large Dia. Pipe
☐ Multi-Pipe
☐ Other

MAX DEPTH (IN.):

- ☐ 12 in. or less
☐ 18 in. or less
☐ 24 in. or less
☐ 26 in. or less
☐ 28 in. or less
☐ 30 in. or less
☐ 32 in. or less
☐ 36 in. or less
☒ Other

STONE DEPTH (IN.):

- ☐ 8 in. or less
☒ 12 in. or less
☐ 18 in. or less
☐ 24 in. or less
☐ Other

TRENCHES:

- ☒ Individual
☐ Bed

TRENCH WIDTH (IN.):

- ☐ 12 in. or less
☐ 18 in.
☐ 24 in.
☒ 36 in.
☐ 6 ft. or less
☐ 9 ft. or less
☐ Other

11/18/14


WAKE COUNTY HEALTH DEPARTMENT WELL AND SEWAGE SITE, LOCATION PERMIT.

ALL PERMITS VOID 60 MONTHS FROM DATE OF ISSUANCE

Tax Map No. 858 Parcel No. 21(s) 9 32136 Improvement Permit
Well Permit No. **C 16484**
Zoning Wake Township Panther Branch Operation Permit []
Owner/Contractor: Harrison Jones Construction Co. Date: March 1, 1993
Location/Address: 6617 Wateroak Drive

S.R. # 42

Subdivision Name: Oak Hollow Lot No. 49 Section or Block No. _____

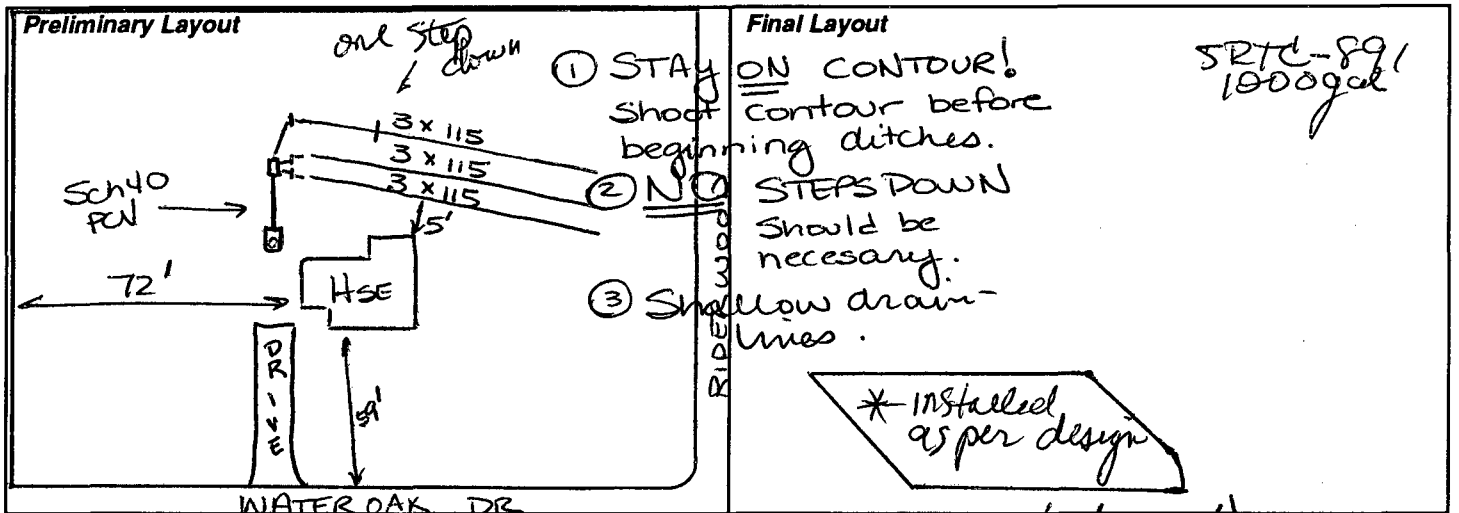

Sewage System Specifications

Repair [] Original Permit No. _____
Garbage Disposal Unit Yes [] No []
House ☒ Mobile Home [] Business []
No. of Bedrooms 3 Lot Area .69 A.
Size of Tank 1000 gal.
Comments: Read notes!

Nitrification Line 3X(3'X115')=1035 sq. ft.
Depth of Stone: 12" [] Max Depth of Trenches: _____ in.
Riser and Baffle Required [] Pump Required []
• Permit void if not in compliance with zoning regulations
• Permits may be voided if site is altered or intended use changed
Layout by: Andre C. Pierce, R.S.

Date: 5-18-93 Installed By: Don Wilson Approved By: Vincent J. Manzoni RS

Well System
Individual [] Semi-Public [] Public ☒
New [] Replacement [] Repair []
Fee Paid: Yes [] No []
Construction Compliance Yes [] No []
Site Approved []
Well Head Approved []
Grouting Approved []

Bacteriological Results
Date Inspected _____ Sanitarian _____
Initial Sample: _____ Date: _____
* Re-Sample #1 _____ Date: _____
* Re-Sample #2 _____ Date: _____
* Re-chlorination as required [] Yes [] No
* Fees for all resamples
All checks payable to: **Wake County Health Department**

Final Inspection

	Yes	No
Required Slab	[]	[]
Chlorinated	[]	[]
Required Certificate	[]	[]
Variance (Explain)	[]	[]
WCHD I.D. Affixed	[]	[]
Sample Collected	[]	[]

Comments: _____
Well Installed By: _____
Date System Finalized _____ Sanitarian _____

This report is based in part on information provided by the homeowner or his/her representative in the application submitted for this permit. The sanitarian is not responsible for false or misleading information contained in the application. The sanitarian is also not responsible for concealed conditions on the property or for statements in this report that may have resulted from false or misleading statements provided to him in the application. Neither Wake County nor the sanitarian warrants that the septic tank system will continue to function satisfactorily in the future or that the water supply will remain potable.

COPY TO HEALTH DEPARTMENT