

Environmental Services - Water Quality
Onsite Wastewater Scan Data Entry Form

PERMIT #: 0016473

PIN #: 1618617004

OP DATE: 0812712001

SYSTEM USE:

- ☒ House
☐ Mobile Home
☐ Business
☐ Other

SEWAGE TYPE:

- ☒ Domestic
☐ Industrial

PUMP/SIPHON?:

- ☐ Yes
☒ No

PRESSURE MANIFOLD:

- ☐ Yes
☒ No

SYSTEM TYPE:

- ☐ I
☐ II
☒ III
☐ IV
☐ V
☐ VI
☐ Other

SUB TYPE:

- ☐ A
☐ B
☐ C
☐ D
☐ E
☐ F
☒ G

NBR BEDROOMS:

- ☐ 1
☐ 2
☒ 3
☐ 4
☐ 5
☐ 6
☐ Other

MAINT. SCHEDULE:

- ☐ Yes
☒ No

CERT. OPERATOR

- ☐ Yes
☒ No

GT ST PT SIZE

- | | | | |
|-------------------------------------|-------------------------------------|-------------------------------------|------------------|
| ☐ | ☐ | ☐ | 750 |
| ☐ | ☐ | ☐ | 900 |
| ☐ | ☒ | ☐ | 1,000 |
| ☐ | ☐ | ☐ | 1,200 |
| ☐ | ☐ | ☐ | 1,500 |
| ☐ | ☐ | ☐ | 1,800 |
| ☐ | ☐ | ☐ | 2,100 |
| ☐ | ☐ | ☐ | 2,500 |
| ☐ | ☐ | ☐ | 3,000 |
| ☐ | ☐ | ☐ | 4,000 |
| ☐ | ☐ | ☐ | 5,000 |
| ☐ | ☐ | ☐ | 8,000 |
| ☐ | ☐ | ☐ | 10,000 |
| ☐ | ☐ | ☐ | Other |
| ☒ | | ☒ | None/NA GT or PT |

DRAINFIELD SIZE(SQ. FT.)

00900

DRAIN TYPE:

- ☐ Stone
☒ EZ Flow
☐ Infiltrator
☐ Biodiffuser
☐ Cultec
☐ Drip
☐ Hancor
☐ Large Dia. Pipe
☐ Multi-Pipe
☐ Other

MAX DEPTH (IN.):

- ☐ 12 in. or less
☐ 18 in. or less
☐ 24 in. or less
☐ 26 in. or less
☒ 28 in. or less
☐ 30 in. or less
☐ 32 in. or less
☐ 36 in. or less
☐ Other

STONE DEPTH (IN.):

- ☐ 8 in. or less
☒ 12 in. or less
☐ 18 in. or less
☐ 24 in. or less
☐ Other

TRENCHES:

- ☒ Individual
☐ Bed

TRENCH WIDTH (IN.):

- ☐ 12 in. or less
☐ 18 in.
☐ 24 in.
☒ 36 in.
☐ 6 ft. or less
☐ 9 ft. or less
☐ Other

CH

WAKE COUNTY DEPARTMENT OF ENVIRONMENTAL SERVICES WELL AND SEWAGE SITE LOCATION

PERMIT

NO PERMIT(S) FOR CONSTRUCTION, LOCATION OR RELOCATION ACTIVITY SHALL BE ISSUED
UNTIL AN AUTHORIZATION FOR WASTEWATER SYSTEM CONSTRUCTION HAS BEEN ISSUED

PERMIT VOID IF NOT IN COMPLIANCE WITH ZONING REGULATIONS AND/OR IF SITE IS ALTERED OR INTENDED USE CHANGED

PERMIT#: D016473 STATUS: A APP DATE: 11/23/1999 BLDG PERMIT#: 0001842

APPLICANT: ASHLEY TURNER HOMES DAY PHONE: (919) 550 - 8888

ADDRESS: PO BOX 160 FAX#: (999) 999 - 9999

CITY: CLAYTON STATE: NC ZIP: 27520

OWNER: PERRY DEVELOPMENT CO LLC DAY PHONE: (999) 999 - 9999

ADDRESS: 7670 BRYAN RD FAX#: (999) 999 - 9999

CITY: GARNER STATE: NC ZIP: 27529

HD USE CD: 101 ONE-FAMILY HOUSE ORIG PERMIT#: REC?: Y

EXIST USE: TAX MAP#: 0809 0000

BEDROOMS: 3 BSMT: N #EMPLOYEES: 0 WATER: C WASTEWATER: I GARB DISPOS: N

TOWNSHIP: 15 PANTHER BRANCH JURIS: WC ZON: R30 PIN: 1618.04 61 7004 000

SUBD#: S 000 000 00 SUBD NAME: STEVENS OAKS LOT-SEC: 58 ACRE: 0.47

IMPRV PRMT: ISSUED?: Y DATE: 03/15/2000 BY: KGD TYPE SYSTEM: III G PUMP:

CNSTR AUTH: ISSUED?: Y DATE: 03/15/2000 BY: KGD MAINT: N OPER: N

RECEIPT#: 0049460 FEE: 145.00 OP DATE: BY:

WATR SAMPL: REQ?: N APPROVED?: DATE: PROPRIETARY SYS: Y

ST#: 1009 MI: DIR: NAME: OPEN FIELD DR DIR: TYP: DR

DIRECTIONS: 50S-SUBDIV ON RT

IMPROVEMENT PERMIT

SIZE OF TANK 1000 ST PT GALS. TOTAL SQ. FT. 900 DEPTH OF STONE INNOV IN. MAX. DEPTH LINE 28 IN.

WASTEWATER: DOMESTIC ☒ INDUSTRIAL ☐

I.P. ISSUED BY

AUTHORIZATION FOR WASTEWATER SYSTEM CONSTRUCTION

VOID SIXTY (60) MONTHS FROM DATE OF ISSUANCE

AUTHORIZATION CONDITIONS

Contractor To Follow Contours, See Attached Site Plan For Wastewater System Design And Well Location. The wastewater system shall not be covered or placed into use until inspected by the Wake County Department of Environmental Services and an Operation Permit issued.

OTHER CONDITIONS: INNOV REQUEST DUE TO SPACE PROBLEMS REDUCTION ALREADY TAKEN NO UTILITIES TO CROSS SYSTEM

SIZE OF TANK 1000 ST PT GALS. TOTAL SQ. FT. 900 DEPTH OF STONE INNOV IN. MAX. DEPTH LINE 28 IN.

ST FILTER REQUIRED ☒ NUMBER OF TRENCHES 3 LENGTH OF TRENCHES 100 FT. WIDTH OF TRENCHES 3 FT.

C.A. ISSUED BY

INSTALLED BY

CTR. I.D. #

SEPTIC TANK FILTER USED

INNOV. APPRL. #: IWWS-

DATE 8/21/01

INSTALLATION APPROVED BY

WELL SYSTEM = PRIVATE ☐ SEMI-PUBLIC ☒ NEW ☐ REPLACEMENT ☐ EXISTING ☐

WELL LOG INFORMATION = DEPTH CASING DEPTH YIELD STATIC LEVEL

WELL CONTRACTOR REG.# PUMP CONTRACTOR REG.#

CONSTRUCTION COMPLIANCE = GROUT APPROVED ☐ DATE EHS

WCHD ID # WELLHEAD APPROVED ☐ DATE EHS

NEGATIVE BACTERIOLOGICAL RESULTS ☐ DATE EHS

SYSTEM FINALIZED ☐ DATE EHS

COMMENTS:

This permit is based in part on information provided by the homeowner or his/her representative in the application submitted for this permit. The Environmental Health Specialist is not responsible for false or misleading information contained in the application. The Environmental Health Specialist is also not responsible for concealed conditions on the property or for statements in this report that may have resulted from false or misleading statements provided to him in the application. Neither Wake County nor the Environmental Health Specialist warrants that the septic tank system will continue to function satisfactorily in the future or that the water supply will remain potable.

SURVEY FOR

W. CHASE HOMES

58, STEVENS OAKS, BM 1999 PG. 710

Revised

PANTHER BRANCH TOWNSHIP WAKE COUNTY NORTH CAROLINA

SCALE: 1" = 30'

CURVE	RADIUS	LENGTH	CHORD	BEARING
C-1	275.00'	29.34'	29.33'	N 86°25'56" W


0001842

D-16473

PERMANENT OPEN SPACE

S.T.
MCP-1000
STB-614
7/11/61

BM 1999 PG. 710

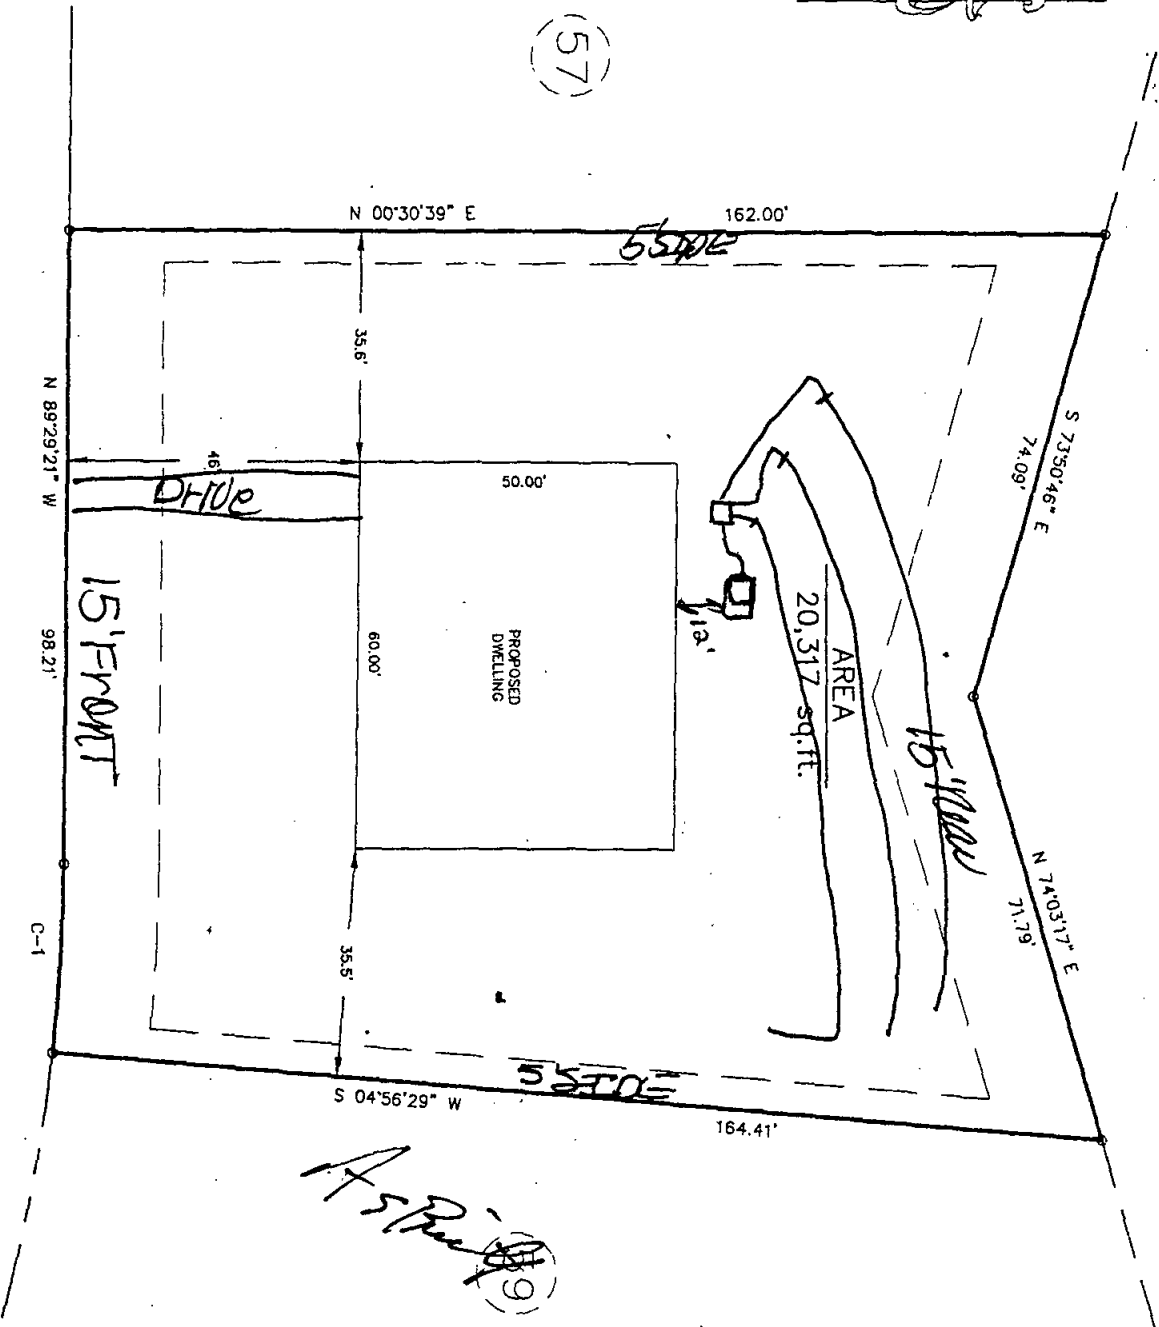

(57)

Asst. Surveyor

1009 OPEN FIELD DR.

PIN# 1618.0450R/M1009

I certify that the location of planned or existing structure(s) are accurately shown. I understand failure to locate structures in accordance with this plan may require the relocation of structure(s) regardless of degree of completion.

Comments:

Side
Front
Reject
Revise
Approve
Zoning

LEGEND
EP - EXISTING IRON PIPE
IP - IRON PIPE SET
NIF - NO IRON FOUND
PK - PK NAIL
RRS - RAILROAD SPIKE

W. CHASE HOMES

58, STEVENS OAKS, BM 1999 PG. 710

REVISED

PANTHER BRANCH TOWNSHIP WAKE COUNTY NORTH CAROLINA

SCALE: 1" = 30'


CURVE	RADIUS	LENGTH	CHORD	BEARING
C-1	275.00'	29.34'	29.33'	N 86°25'56" W

0001842

D-16473

PERMANENT OPEN SPACE

BM 1999 PG. 710

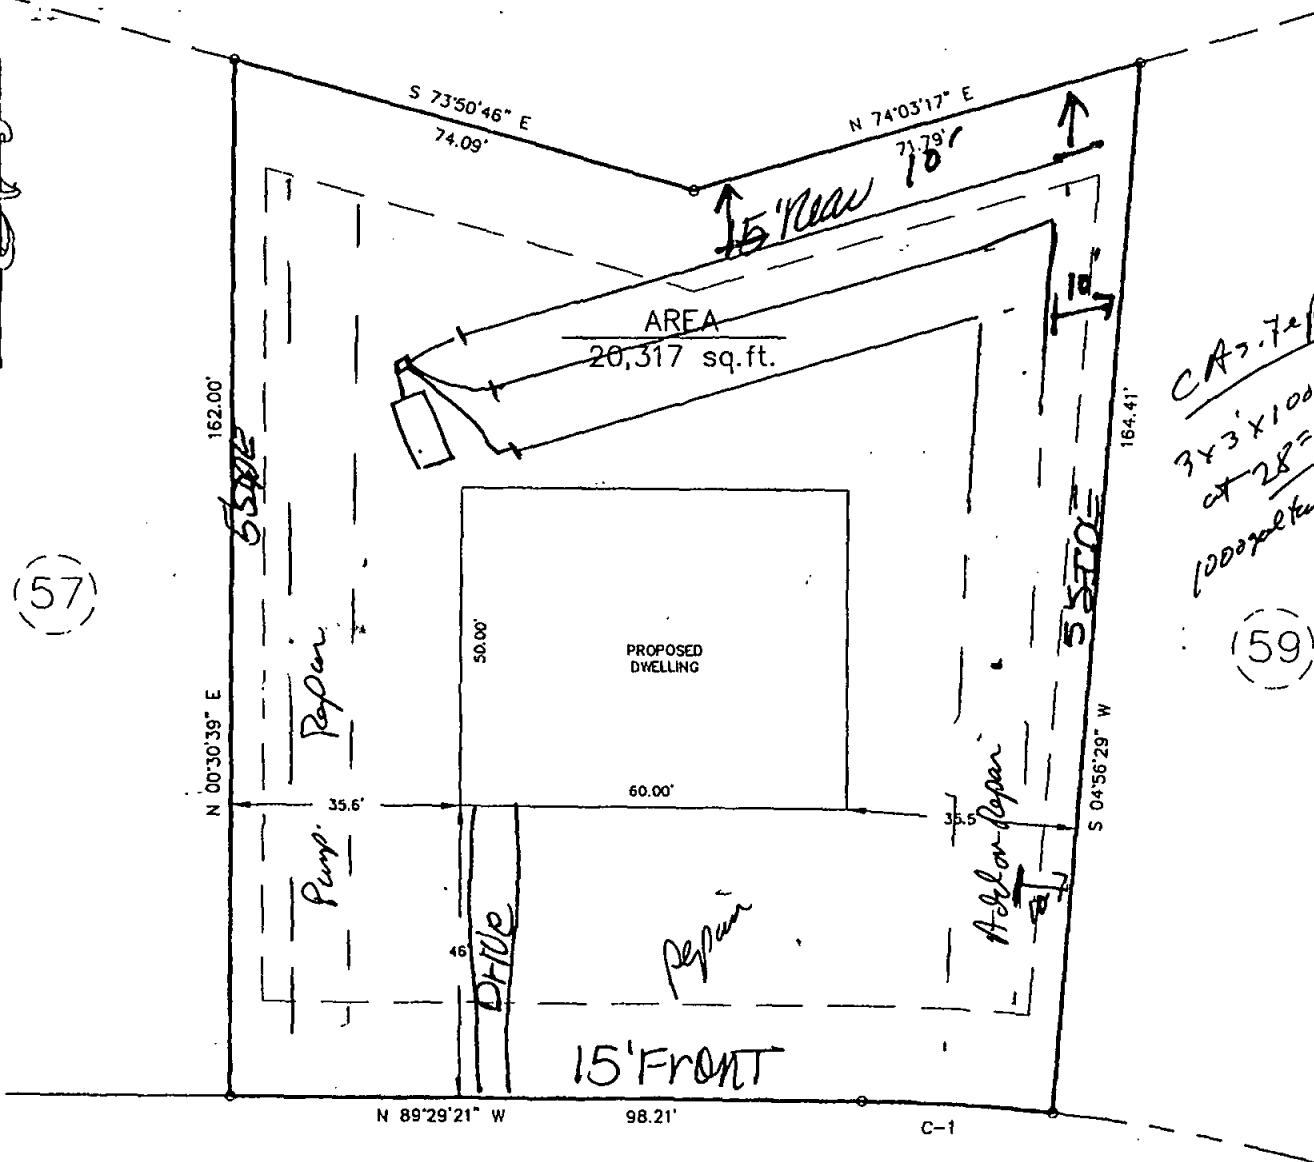

CA 3.7e plan
3x3'x100' Dunes
at 28"
1000 gal tank


1009 OPEN FIELD DR.

PIN# 1618-0450R/M009

I certify that the location of planned or existing structure(s) are accurately shown. I understand failure to locate structures in accordance with this plot plan may require the relocation of structure(s) regardless degree of completion.

Comments:

Side 5
Front 15
Reject 15
Revise 15
Approve 15
Zoning 15
LEGEND
EIP - EXISTING IRON PIPE
IPS - IRON PIPE SET
NIF - NO IRON FOUND
PK - PK NAIL
RRS - RAILROAD SPIKE

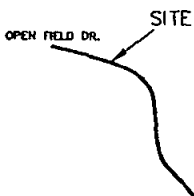


NC 50

WAKE COUNTY Department of Environmental Services

Water, Wastewater and Development Services

(919) 856-7400 FAX: (919) 856-7407

PO Box 550, Raleigh, NC 27602

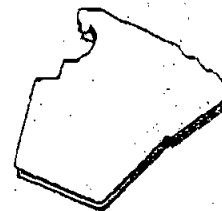

I, W. Chase Homes hereby request the chamber system or polystyrene aggregate system called E2 Lay to be used in my sewage disposal system. I understand that I will be granted a 25% reduction in the amount of required drainfield for my property. My property is located at Lot 58 Stevens Oaks

Christy D. D. Owner

3-16-00 Date

D# 16473

Bldg Permit # _____

PIN: _____

Generic Name

Proprietary Name

☐ Drip System	"Perc-Rite" Subsurface
☐ Chamber Trench Sys	"Infiltrator" Chambered
☐ Brunswick Bed/Fill Sys.	"Brunswick" Bed/Fill
☐ Chamber Trench Sys.	"Hanco EnviroChamber"
☐ Polystyrene Aggregate Tr	Houck Drainage Sys.
☐ Chamber Trench	"Contractor Model 75, 100, 125, and field drain"
☐ Polyethylene	Norwesco P.E. Tanks
☐ Sand Filter Pretreatment	Pressure Dosed Sand
☐ Chamber Trench	"Bio Diffuser" Low Profile
☐ Peat Filter Pret. Sys.	Purallo Peat Biofilter Sys.
☐ Fiberglass Reinforced Tanks	Fiberglass Reinforced Tanks

To protect and improve the quality of Wake County's environment and ensure a healthy future
for its citizens through responsible development.

TOTAL P.03