

Environmental Services - Water Quality
Onsite Wastewater Scan Data Entry Form

PERMIT #: 0015215

PIN #: 0679971948

OP DATE: 0911011992

SYSTEM USE:

- ☒ House
☐ Mobile Home
☐ Business
☐ Other

SEWAGE TYPE:

- ☒ Domestic
☐ Industrial

PUMP/SIPHON?:

- ☐ Yes
☒ No

PRESSURE MANIFOLD:

- ☐ Yes
☒ No

SYSTEM TYPE:

- ☐ I
☒ II
☐ III
☐ IV
☐ V
☐ VI
☐ Other

SUB TYPE:

- ☒ A
☐ B
☐ C
☐ D
☐ E
☐ F
☐ G

NBR BEDROOMS:

- ☐ 1
☐ 2
☒ 3
☐ 4
☐ 5
☐ 6
☐ Other

MAINT. SCHEDULE:

- ☐ Yes
☒ No

CERT. OPERATOR

- ☐ Yes
☒ No

GT	ST	PT	SIZE
☐	☐		750
☐	☐	☐	900
☐	☒	☐	1,000
☐	☐	☐	1,200
☐	☐	☐	1,500
☐	☐	☐	1,800
☐	☐	☐	2,100
☐	☐	☐	2,500
☐	☐	☐	3,000
☐	☐	☐	4,000
☐	☐	☐	5,000
☐	☐	☐	8,000
☐	☐	☐	10,000
☐	☐	☐	Other
☒		☒	None/NA GT or PT

DRAINFIELD SIZE(SQ. FT.)

01080

DRAIN TYPE:

- ☒ Stone
☐ EZ Flow
☐ Infiltrator
☐ Biodiffuser
☐ Cultec
☐ Drip
☐ Hancor
☐ Large Dia. Pipe
☐ Multi-Pipe
☐ Other

MAX DEPTH (IN.):

- ☐ 12 in. or less
☐ 18 in. or less
☐ 24 in. or less
☒ 26 in. or less
☐ 28 in. or less
☐ 30 in. or less
☐ 32 in. or less
☐ 36 in. or less
☐ Other

STONE DEPTH (IN.):

- ☐ 8 in. or less
☒ 12 in. or less
☐ 18 in. or less
☐ 24 in. or less
☐ Other

TRENCHES:

- ☒ Individual
☐ Bed

TRENCH WIDTH (IN.):

- ☐ 12 in. or less
☐ 18 in.
☐ 24 in.
☒ 36 in.
☐ 6 ft. or less
☐ 9 ft. or less
☐ Other

[Signature]
2/4/15


115
WAKE COUNTY HEALTH DEPARTMENT WELL AND SEWAGE SITE, LOCATION PERMIT
ALL PERMITS VOID 60 MONTHS FROM DATE OF ISSUANCE

Tax Map No. 744 Parcel No. 124
Zoning Wake Township Swift Creek
Owner/Contractor: Harvey Montague
Location/Address: 5405 Deerpark Dr.

Improvement Permit
Well Permit No. **C** 15215
Operation Permit []
Date: September 1, 1992

Subdivision Name: Deerpark Lot No. 63 Section or Block No. 1010

Preliminary Layout

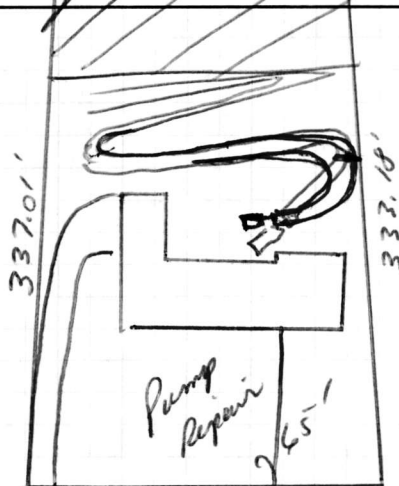

Final Layout

Sewage System Specifications

Repair [] Original Permit No. _____
Garbage Disposal Unit Yes [] No [X]
House [X] Mobile Home [] Business []
No. of Bedrooms 3 Lot Area .83Ac.
Size of Tank 1000 gal.
Comments: _____

Nitrification Line 2(3'x180') 1080 sq. ft.
Depth of Stone: 12" [X] Max Depth of Trenches: 26 in.
Riser and Baffle Required [X] Pump Required []
• Permit void if not in compliance with zoning regulations
• Permits may be voided if site is altered or intended use changed
Layout by: Robert S. Fulkner, R.S.

Date: 9-10-92 Installed By: Ricky Hutto

Approved By: W. Paul Bunting

Well System
Individual [] Semi-Public [] Public [X]
New [] Replacement [] Repair [X]
Fee Paid: Yes [] No []
Construction Compliance
Site Approved [] Yes [] No []
Well Head Approved []
Grouting Approved []

Final Inspection	Yes	No
Required Slab	[]	[]
Chlorinated	[]	[]
Required Certificate	[]	[]
Variance (Explain)	[]	[]
WCHD I.D. Affixed	[]	[]
Sample Collected	[]	[]

Date Inspected _____ Sanitarian _____

Bacteriological Results

Initial Sample: _____ Date: _____
* Re-Sample #1 _____ Date: _____
* Re-Sample #2 _____ Date: _____
* Re-chlorination as required [] Yes [] No

* Fees for all resamples

All checks payable to: **Wake County Health Department**

Comments: _____

Well Installed By: _____

Date System Finalized _____

Sanitarian _____

This report is based in part on information provided by the homeowner or his/her representative in the application submitted for this permit. The sanitarian is not responsible for false or misleading information contained in the application. The sanitarian is also not responsible for concealed conditions on the property or for statements in this report that may have resulted from false or misleading statements provided to him in the application. Neither Wake County nor the sanitarian warrants that the septic tank system will continue to function satisfactorily in the future or that the water supply will remain potable.

COPY TO HEALTH DEPARTMENT




SPECIAL FLOOD HAZARD AREA AS DETERMINED BY THE DEPARTMENT OF HOUSING AND URBAN DEVELOPMENT.

I, M. M. WEEKS, DO HEREBY CERTIFY THAT THE BUILDINGS LIE WHOLLY ON THE LOT AND THAT THERE ARE NO ENCROACHMENTS EITHER WAY ACROSS PROPERTY LINES EXCEPT AS SHOWN. WITNESS MY HAND AND SEAL THIS 18TH DAY OF AUGUST, 1992.

VICINITY MAP
I certify that the location of this structure is accurately shown.
Failure to locate this structure in accordance with this plot plan could require relocation of the structure regardless of its degree of completion.

Signature: *Harvey Montague* Date: 8/19/92
Check one: ☐ Owner ☒ Builder/Contractor ☐ Other

30' F
DOEMONT DRIVE
(50' R/W)

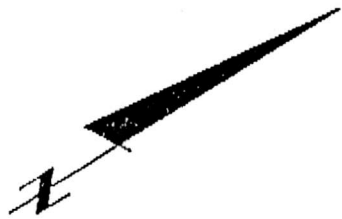

LOT 64

LOT 62

LOT 63
SECTION 5
PHASE 3
DEERFIELD PARK
B.M. 1987, PG. 1892

LEGEND

EIP - EXISTING IRON PIPE
R/W - RIGHT OF WAY
BM - BOOK OF MAPS
PG - PAGE
S/D - SUBDIVISION

	RADIUS	ARC	DELTA	CHORD	CHORD BEARING
C-1	325.00'	37.41'	06°35'43"	37.39'	N30°14'53"E
C-2	225.00'	30.03'	07°38'45"	30.00'	N30°46'21"E

PLOT PLAN FOR
HARVEY MONTAGUE



WEEKS LAND SURVEYING

P.O. BOX 36027, RALEIGH, NORTH CAROLINA 27606
(919)469-1008

CARY

WAKE COUNTY

NORTH CAROLINA

AUGUST 18, 1992

SCALE: 1" = 40'

TF-14-63

290.00
48.00
338.00