

Environmental Services - Water Quality
Onsite Wastewater Scan Data Entry Form

PERMIT #: 0013895

PIN #: 0689053326

OP DATE: 0512211992

SYSTEM USE:

- ☒ House
☐ Mobile Home
☐ Business
☐ Other

SEWAGE TYPE:

- ☒ Domestic
☐ Industrial

PUMP/SIPHON?:

- ☐ Yes
☒ No

PRESSURE MANIFOLD:

- ☐ Yes
☒ No

SYSTEM TYPE:

- ☐ I
☒ II
☐ III
☐ IV
☐ V
☐ VI
☐ Other

SUB TYPE:

- ☒ A
☐ B
☐ C
☐ D
☐ E
☐ F
☐ G

NBR BEDROOMS:

- ☐ 1
☐ 2
☒ 3
☐ 4
☐ 5
☐ 6
☐ Other

MAINT. SCHEDULE:

- ☐ Yes
☒ No

CERT. OPERATOR

- ☐ Yes
☒ No

GT ST PT SIZE

- | | | | |
|-------------------------------------|-------------------------------------|-------------------------------------|------------------|
| ☐ | ☐ | ☐ | 750 |
| ☐ | ☐ | ☐ | 900 |
| ☐ | ☒ | ☐ | 1,000 |
| ☐ | ☐ | ☐ | 1,200 |
| ☐ | ☐ | ☐ | 1,500 |
| ☐ | ☐ | ☐ | 1,800 |
| ☐ | ☐ | ☐ | 2,100 |
| ☐ | ☐ | ☐ | 2,500 |
| ☐ | ☐ | ☐ | 3,000 |
| ☐ | ☐ | ☐ | 4,000 |
| ☐ | ☐ | ☐ | 5,000 |
| ☐ | ☐ | ☐ | 8,000 |
| ☐ | ☐ | ☐ | 10,000 |
| ☒ | ☐ | ☒ | Other |
| | | | None/NA GT or PT |

DRAINFIELD SIZE(SQ. FT.)

01200

DRAIN TYPE:

- ☒ Stone
☐ EZ Flow
☐ Infiltrator
☐ Biodiffuser
☐ Cultec
☐ Drip
☐ Hancor
☐ Large Dia. Pipe
☐ Multi-Pipe
☐ Other

MAX DEPTH (IN.):

- ☐ 12 in. or less
☐ 18 in. or less
☒ 24 in. or less
☐ 26 in. or less
☐ 28 in. or less
☐ 30 in. or less
☐ 32 in. or less
☐ 36 in. or less
☐ Other

STONE DEPTH (IN.):

- ☐ 8 in. or less
☒ 12 in. or less
☐ 18 in. or less
☐ 24 in. or less
☐ Other

TRENCHES:

- ☒ Individual
☐ Bed

TRENCH WIDTH (IN.):

- ☐ 12 in. or less
☐ 18 in.
☐ 24 in.
☒ 36 in.
☐ 6 ft. or less
☐ 9 ft. or less
☐ Other

AW

WAKE COUNTY HEALTH DEPARTMENT WELL AND SEWAGE SITE, LOCATION PERMIT

ALL PERMITS VOID 60 MONTHS FROM DATE OF ISSUANCE

PIN# 680.05.3326

Tax Map No. 744 Parcel No. 221

Improvement Permit

Well Permit No. **C 13895**

Zoning WAIC Township SWIFT CREEK

Operation Permit []

Owner/Contractor Wrenn Investment

Date: 3-4-92

Location/Address: 4216 NEW Brighton DR: LAKE WHEELER RD South, CROSS


OVER 3R 1010 TR onto 5R 1390, TR into S/D S.R. # 1390

Subdivision Name: FAIRSTONE


Lot No. 11

Section or Block No. _____

Preliminary Layout

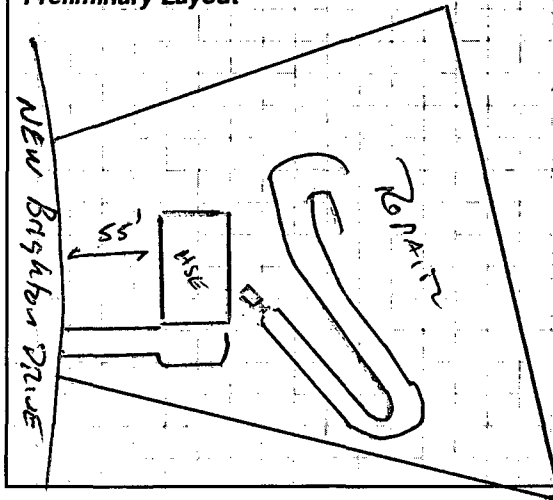

Final Layout

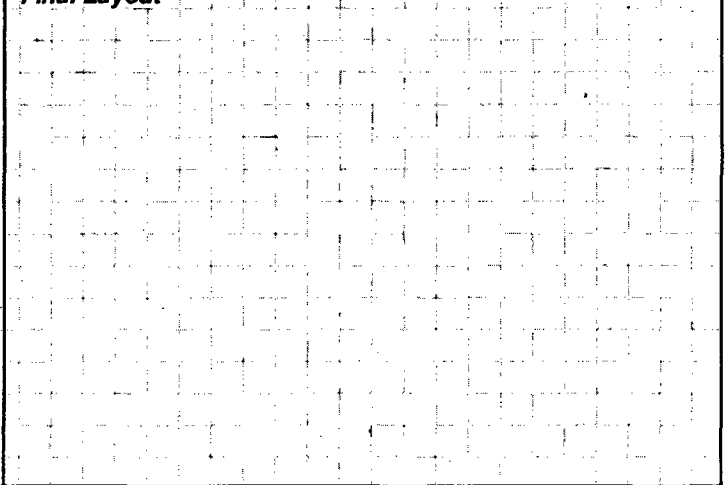

Sewage System Specifications

Repair [] Original Permit No. _____

Garbage Disposal Unit Yes [] No ☒

House ☒ Mobile Home [] Business []

No. of Bedrooms 3 Lot Area 31,180 sq. ft.

Size of Tank 1000 gal.

Comments: _____

Nitrification Line 1200 2(3' x 200') sq. ft.

Depth of Stone: 12" Max Depth of Trenches: 24" in.

Riser and Baffle Required ☒ Pump Required []

Permit void if not in compliance with zoning regulations

Permits may be voided if site is altered or intended use changed

Layout by: W. David Bruns RS

Date: 5-22-92 Installed By: Preston Wrenn Approved By: W. David Bruns RS

Well System
Individual [] Semi-Public [] Public ☒
New [] Replacement [] Repair ☒
Fee Paid: Yes [] No []
Construction Compliance Yes [] No []
Site Approved [] []
Well Head Approved [] []
Grouting Approved [] []

Date Inspected _____ Sanitarian _____

Bacteriological Results

Initial Sample: _____ Date: _____

* Re-Sample #1 _____ Date: _____

* Re-Sample #2 _____ Date: _____

* Re-chlorination as required [] Yes [] No

* Fees for all resamples

All checks payable to: **Wake County Health Department**

Final Inspection
Required Slab [] []
Chlorinated [] []
Required Certificate [] []
Variance (Explain) [] []
WCHD I.D. Affixed [] []
Sample Collected [] []

Comments: _____

Well Installed By: _____

Date System Finalized _____

Sanitarian _____

This report is based in part on information provided by the homeowner or his/her representative in the application submitted for this permit. The sanitarian is not responsible for false or misleading information contained in the application. The sanitarian is also not responsible for concealed conditions on the property or for statements in this report that may have resulted from false or misleading statements provided to him in the application. Neither Wake County nor the sanitarian warrants that the septic tank system will continue to function satisfactorily in the future or that the water supply will remain potable.

COPY TO HEALTH DEPARTMENT