

Environmental Services - Water Quality
Onsite Wastewater Scan Data Entry Form

PERMIT #: C 0 2 2 8 2 6

PIN #: 0 7 8 1 4 6 0 1 8 0

OP DATE: 0 8 1 2 1 1 1 9 9 5

SYSTEM USE:

- ☒ House
☐ Mobile Home
☐ Business
☐ Other

SEWAGE TYPE:

- ☒ Domestic
☐ Industrial

PUMP/SIPHON?:

- ☒ Yes
☐ No

PRESSURE MANIFOLD:

- ☐ Yes
☒ No

SYSTEM TYPE:

- ☐ I
☐ II
☒ III
☐ IV
☐ V
☐ VI
☐ Other

SUB TYPE:

- ☐ A
☒ B
☐ C
☐ D
☐ E
☐ F
☐ G

NBR BEDROOMS:

- ☐ 1
☐ 2
☒ 3
☐ 4
☐ 5
☐ 6
☐ Other

MAINT. SCHEDULE:

- ☐ Yes
☒ No

CERT. OPERATOR

- ☐ Yes
☒ No

GT	ST	PT	SIZE
☐	☐		750
☐	☐	☐	900
☐	☒	☐	1,000
☐	☐	☒	1,200
☐	☐	☐	1,500
☐	☐	☐	1,800
☐	☐	☐	2,100
☐	☐	☐	2,500
☐	☐	☐	3,000
☐	☐	☐	4,000
☐	☐	☐	5,000
☐	☐	☐	8,000
☐	☐	☐	10,000
☐	☐	☐	Other
☒		☐	None/NA GT or PT

DRAINFIELD SIZE(SQ. FT.)

0 1 2 0 0

DRAIN TYPE:

- ☒ Stone
☐ EZ Flow
☐ Infiltrator
☐ Biodiffuser
☐ Cultec
☐ Drip
☐ Hancor
☐ Large Dia. Pipe
☐ Multi-Pipe
☐ Other

MAX DEPTH (IN.):

- ☐ 12 in. or less
☐ 18 in. or less
☐ 24 in. or less
☐ 26 in. or less
☐ 28 in. or less
☒ 30 in. or less
☐ 32 in. or less
☐ 36 in. or less
☐ Other

STONE DEPTH (IN.):

- ☐ 8 in. or less
☒ 12 in. or less
☐ 18 in. or less
☐ 24 in. or less
☐ Other

TRENCHES:

- ☒ Individual
☐ Bed

TRENCH WIDTH (IN.):

- ☐ 12 in. or less
☐ 18 in.
☐ 24 in.
☒ 36 in.
☐ 6 ft. or less
☐ 9 ft. or less
☐ Other

WAKE COUNTY HEALTH DEPARTMENT WELL AND SEWAGE SITE, LOCATION PERMIT

ALL PERMITS VOID 60 MONTHS FROM DATE OF ISSUANCE

Pin # 0781.04460180 Project # 0952253

Tax Map No. _____ Parcel No. _____

Zoning Wake Township Swift Creek

Owner/Contractor: Braswell Const. Co. Inc.

Improvement Permit

Well Permit No. **C 22826**

Operation Permit []

Date: 2-23-95


Location/Address: (2217 Tomalley Ct.) Lake Wheeler Rd South, (R) Lanney Rd, (R) Old South, 310 on left.

S.R. # 1382

Subdivision Name: Old South Trace

Lot No. 25

Section or Block No. _____

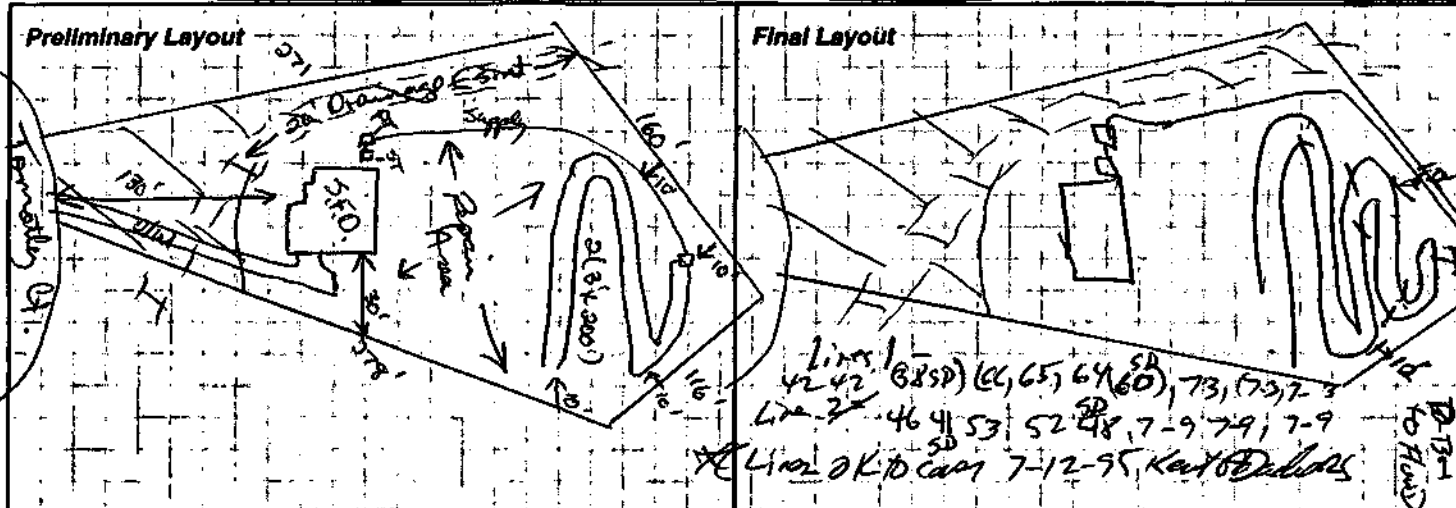

Sewage System Specifications

Repair [] Original Permit No. _____

Garbage Disposal Unit Yes [] No [X]

House [X] Mobile Home [] Business []

No. of Bedrooms 3 Lot Area _____

Size of Tank 1000 ST + 1200 PT gal.

Nitrification Line 1200 ft² 2(3'x200') sq. ft.

Depth of Stone: 12" [X] Max Depth of Trenches: 30 in.

Riser and Baffle Required [X] Pump Required [X]

Permit void if not in compliance with zoning regulations

Permits may be voided if site is altered or intended use changed

Layout by: Terry D. Chappell R.S.

* Comments: Keep system shallow! Use NEMA 4X Elec. box, 4x4 post, mount alarm in house or in garage!

Date: 8-21-1995 Installed By: R. Eberhart

Approved By: [Signature]

Well System

Individual [] Semi-Public [] Public [X]
 New [] Replacement [] Repair []
 Fee Paid: Yes [] No []
 Construction Compliance
 Site Approved [] Yes [] No []
 Well Head Approved []
 Grouting Approved []

Final Inspection

	Yes	No
Required Slab	[]	[]
Chlorinated	[]	[]
Required Certificate	[]	[]
Variance (Explain)	[]	[]
WCHD I.D. Affixed	[]	[]
Sample Collected	[]	[]

Date Inspected _____ Sanitarian _____

Bacteriological Results

Initial Sample: _____ Date: _____
 * Re-Sample #1 _____ Date: _____
 * Re-Sample #2 _____ Date: _____
 * Re-chlorination as required [] Yes [] No
 * Fees for all resamples

Comments: _____

Well Installed By: _____

All checks payable to: **Wake County Health Department**

Date System Finalized _____

Sanitarian _____

This report is based in part on information provided by the homeowner or his/her representative in the application submitted for this permit. The sanitarian is not responsible for false or misleading information contained in the application. The sanitarian is also not responsible for concealed conditions on the property or for statements in this report that may have resulted from false or misleading statements provided to him in the application. Neither Wake County nor the sanitarian warrants that the septic tank system will continue to function satisfactorily in the future or that the water supply will remain potable.

COPY TO HEALTH DEPARTMENT

3002.017 - 5/14/93

Tax Map No.

Parcel No.

PIN# 0781.04460180