

Environmental Services - Water Quality
Onsite Wastewater Scan Data Entry Form

PERMIT #: **C 0 1 5 4 9 8**

PIN #: **0 7 8 2 3 0 0 9 8 1**

OP DATE: **0 9 / 2 5 / 1 9 9 2**

SYSTEM USE:

- ☒ House
☐ Mobile Home
☐ Business
☐ Other

SEWAGE TYPE:

- ☒ Domestic
☐ Industrial

PUMP/SIPHON?:

- ☐ Yes
☒ No

PRESSURE MANIFOLD:

- ☐ Yes
☒ No

SYSTEM TYPE:

- ☐ I
☒ II
☐ III
☐ IV
☐ V
☐ VI
☐ Other

SUB TYPE:

- ☒ A
☐ B
☐ C
☐ D
☐ E
☐ F
☐ G

NBR BEDROOMS:

- ☐ 1
☐ 2
☒ 3
☐ 4
☐ 5
☐ 6
☐ Other

MAINT. SCHEDULE:

- ☐ Yes
☒ No

CERT. OPERATOR

- ☐ Yes
☒ No

GT ST PT SIZE

- | | | | |
|-------------------------------------|-------------------------------------|-------------------------------------|------------------|
| ☐ | ☐ | | 750 |
| ☐ | ☐ | ☐ | 900 |
| ☐ | ☐ | ☐ | 1,000 |
| ☐ | ☐ | ☐ | 1,200 |
| ☐ | ☐ | ☐ | 1,500 |
| ☐ | ☐ | ☐ | 1,800 |
| ☐ | ☐ | ☐ | 2,100 |
| ☐ | ☐ | ☐ | 2,500 |
| ☐ | ☐ | ☐ | 3,000 |
| ☐ | ☐ | ☐ | 4,000 |
| ☐ | ☐ | ☐ | 5,000 |
| ☐ | ☐ | ☐ | 8,000 |
| ☐ | ☐ | ☐ | 10,000 |
| ☐ | ☒ | ☐ | Other |
| ☒ | | ☒ | None/NA GT or PT |

DRAINFIELD SIZE(SQ. FT.)

0 0 9 0 0

Estimated for scanning project.

DRAIN TYPE:

- ☒ Stone
☐ EZ Flow
☐ Infiltrator
☐ Biodiffuser
☐ Cultec
☐ Drip
☐ Hancor
☐ Large Dia. Pipe
☐ Multi-Pipe
☐ Other

MAX DEPTH (IN.):

- ☐ 12 in. or less
☐ 18 in. or less
☐ 24 in. or less
☐ 26 in. or less
☐ 28 in. or less
☐ 30 in. or less
☐ 32 in. or less
☐ 36 in. or less
☒ Other

STONE DEPTH (IN.):

- ☐ 8 in. or less
☐ 12 in. or less
☐ 18 in. or less
☐ 24 in. or less
☒ Other

TRENCHES:

- ☒ Individual
☐ Bed

TRENCH WIDTH (IN.):

- ☐ 12 in. or less
☐ 18 in.
☐ 24 in.
☐ 36 in.
☐ 6 ft. or less
☐ 9 ft. or less
☒ Other

WAKE COUNTY HEALTH DEPARTMENT WELL AND SEWAGE SITE, LOCATION PERMIT

ALL PERMITS VOID 60 MONTHS FROM DATE OF ISSUANCE

Tax Map No. 628 Parcel No. 49

Improvement Permit

Well Permit No. **C** 15498

Zoning WAKE Township Swiftcreek

Operation Permit []

Owner/Contractor: Robert STEVENSON

Date: 9-25-92


Location/Address: 5516 YATES MILL Pond Rd

S.R. # 1852

Subdivision Name: 48

Lot No. 6A

Section or Block No. _____

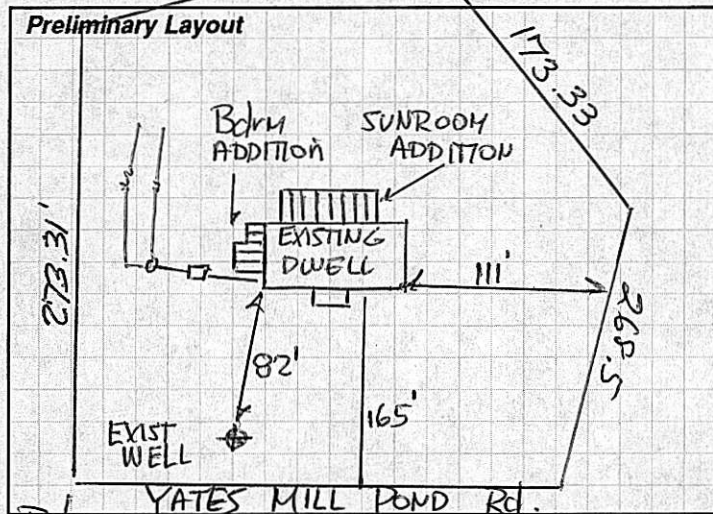

Final Layout

THIS PERMIT IS FOR THE ADDITION OF ONE Bdrm TO THE EXISTING 3Bdrm dwelling. ONE bedroom to be removed when sunroom addition constructed. therefore no net gain OF Bedrooms to EXISTING dwelling. House to remain 3 bedrooms.

NO ADDITIONAL NITRIFICATION LINE IS required to be Added TO EXISTING septic system.

Bdrm. ADDITION
Repair ☒

Sewage System Specifications

Original Permit No. _____

Garbage Disposal Unit Yes [] No []

House [] Mobile Home [] Business []

No. of Bedrooms Existing Lot Area _____

Size of Tank Existing gal. _____

Comments: _____

Nitrification Line Existing sq. ft. _____

Depth of Stone: 12" [] Max Depth of Trenches: _____ in.

Riser and Baffle Required [] Pump Required []

Permit void if not in compliance with zoning regulations

Permits may be voided if site is altered or intended use changed

Layout by: Amendy Maugz RS

Date: 9-25-92 Installed By: _____

Approved By: Amendy Maugz RS

Well System			
Individual []	Semi-Public []	Public []	
New []	Replacement []	Repair []	
Fee Paid: Yes []	No []		
Construction Compliance		Yes	No
Site Approved		[]	[]
Well Head Approved		[]	[]
Grouting Approved		[]	[]

Final Inspection	Yes	No
Required Slab	[]	[]
Chlorinated	[]	[]
Required Certificate	[]	[]
Variance (Explain)	[]	[]
WCHD I.D. Affixed	[]	[]
Sample Collected	[]	[]

Date Inspected _____ Sanitarian _____

Bacteriological Results

Initial Sample: _____ Date: _____

* Re-Sample #1 _____ Date: _____

* Re-Sample #2 _____ Date: _____

* Re-chlorination as required [] Yes [] No

* Fees for all resamples _____

All checks payable to: **Wake County Health Department**



Comments: _____

Well Installed By: _____

Date System Finalized _____ Sanitarian _____

This report is based in part on information provided by the homeowner or his/her representative in the application submitted for this permit. The sanitarian is not responsible for false or misleading information contained in the application. The sanitarian is also not responsible for concealed conditions on the property or for statements in this report that may have resulted from false or misleading statements provided to him in the application. Neither Wake County nor the sanitarian warrants that the septic tank system will continue to function satisfactorily in the future or that the water supply will remain potable.

COPY TO HEALTH DEPARTMENT

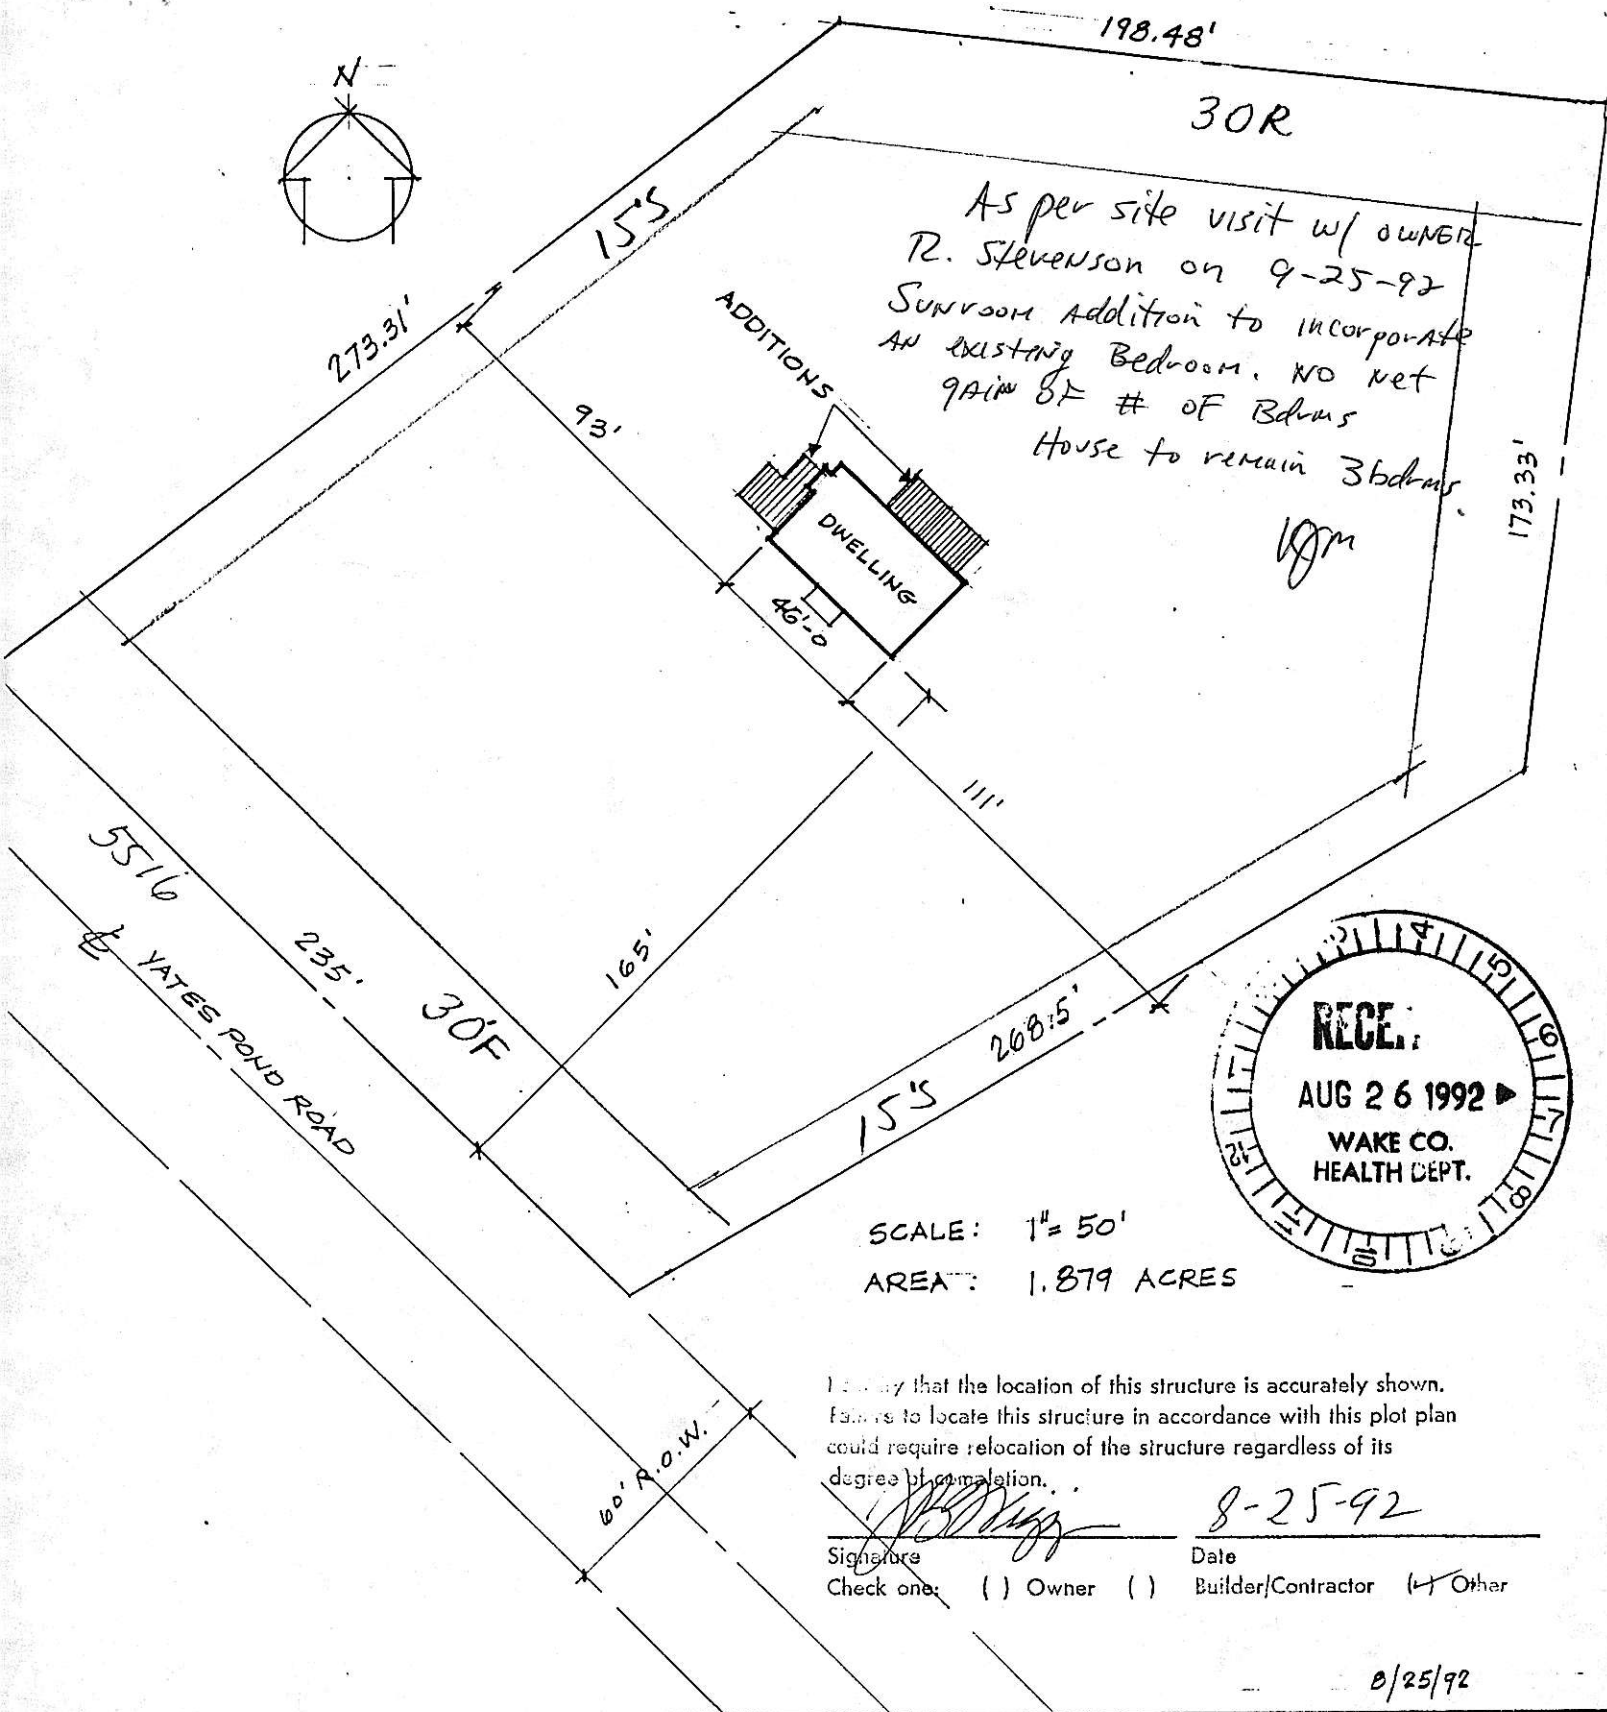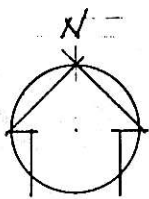

PROPERTY OF ROBERT E. & KATIE W. STEPHENSON
5516 YATES POND ROAD
RALEIGH, N.C. 851-4888
628-49
LOT 6A