

Environmental Services - Water Quality
Onsite Wastewater Scan Data Entry Form

PERMIT #: 0031625

PIN #: 0685366453

OP DATE: 0113112005

SYSTEM USE:

- ☒ House
☐ Mobile Home
☐ Business
☐ Other

SEWAGE TYPE:

- ☒ Domestic
☐ Industrial

PUMP/SIPHON?:

- ☐ Yes
☒ No

PRESSURE MANIFOLD:

- ☐ Yes
☒ No

SYSTEM TYPE:

- ☐ I
☐ II
☒ III
☐ IV
☐ V
☐ VI
☐ Other

SUB TYPE:

- ☐ A
☐ B
☐ C
☐ D
☐ E
☐ F
☒ G

NBR BEDROOMS:

- ☐ 1
☐ 2
☒ 3
☐ 4
☐ 5
☐ 6
☐ Other

MAINT. SCHEDULE:

- ☐ Yes
☒ No

CERT. OPERATOR

- ☐ Yes
☒ No

GT ST PT SIZE

- | | | | |
|-------------------------------------|-------------------------------------|-------------------------------------|------------------|
| ☐ | ☐ | ☐ | 750 |
| ☐ | ☐ | ☐ | 900 |
| ☐ | ☒ | ☐ | 1,000 |
| ☐ | ☐ | ☐ | 1,200 |
| ☐ | ☐ | ☐ | 1,500 |
| ☐ | ☐ | ☐ | 1,800 |
| ☐ | ☐ | ☐ | 2,100 |
| ☐ | ☐ | ☐ | 2,500 |
| ☐ | ☐ | ☐ | 3,000 |
| ☐ | ☐ | ☐ | 4,000 |
| ☐ | ☐ | ☐ | 5,000 |
| ☐ | ☐ | ☐ | 8,000 |
| ☐ | ☐ | ☐ | 10,000 |
| ☐ | ☐ | ☐ | Other |
| ☒ | ☐ | ☒ | None/NA GT or PT |

DRAINFIELD SIZE(SQ. FT.)

00900

DRAIN TYPE:

- ☐ Stone
☒ EZ Flow
☐ Infiltrator
☐ Biodiffuser
☐ Cultec
☐ Drip
☐ Hancor
☐ Large Dia. Pipe
☐ Multi-Pipe
☐ Other

MAX DEPTH (IN.):

- ☐ 12 in. or less
☐ 18 in. or less
☒ 24 in. or less
☐ 26 in. or less
☐ 28 in. or less
☐ 30 in. or less
☐ 32 in. or less
☐ 36 in. or less
☐ Other

STONE DEPTH (IN.):

- ☐ 8 in. or less
☒ 12 in. or less
☐ 18 in. or less
☐ 24 in. or less
☐ Other

TRENCHES:

- ☒ Individual
☐ Bed

TRENCH WIDTH (IN.):

- ☐ 12 in. or less
☐ 18 in.
☐ 24 in.
☒ 36 in.
☐ 6 ft. or less
☐ 9 ft. or less
☐ Other

WAKE COUNTY DEPARTMENT OF ENVIRONMENTAL SERVICES WELL AND SEWAGE SITE LOCATION PERMIT
NO PERMIT(S) FOR CONSTRUCTION, LOCATION OR RELOCATION ACTIVITY SHALL BE ISSUED
UNTIL AN AUTHORIZATION FOR WASTEWATER SYSTEM CONSTRUCTION HAS BEEN ISSUED

PERMIT VOID IF NOT IN COMPLIANCE WITH ZONING REGULATIONS AND/ OR IF SITE IS ALTERED OR INTENDED USE CHANGED

PERMIT#: D031625 STATUS: A APP. DATE: 09/22/2004 BLDG. PERMIT#: 0050988
PIN: 0685.01 36 6453 000 TAX MAP: 0879 0000 RECORDED: Y ORIG. PERMIT#:
TOWNSHIP: 12 MIDDLE CREEK JURISDICTION: WC ZONING: R30
APPLICANT: CUSTOM CRAFT BUILDERS INC
29 NEIGHBOR LANE
FOUR OAKS, NC 27524
(919) 669 - 3813
USE: HD USE: 101 ONE-FAMILY HOUSE
EXIST USE:
DISPOSAL: BEDROOMS: 3 BASEMENT: N #EMPLOYEES: 0
SITE: ADDRESS: 7721 PEGRAM ST
SUBDIVISION: WESTMOOR LOT: 16 ACRES: 0.46
DIRECTION: WALTER MYATT RD, TL KENNEBEC RD TL BUD LIBSCOMB
S/D ON RT

Well System: WATER: COMMUNITY - TYPE:

WELL LOG INFORMATION: DEPTH: _____ CASING DEPTH: _____ YIELD: _____ STATIC LEVEL: _____
WELL CONTRACTOR: _____ REG.# _____ PUMP CONTRACTOR: _____ REG.# _____
Construction Compliance GROUT APPROVED ☐ DATE _____ EHS _____
WELLHEAD APPROVED ☐ DATE _____ EHS _____
SYSTEM FINALIZED ☐ DATE _____ EHS _____

COMMENTS:

Operation Permit

DESIGN FLOW: _____ gal./min. ACTUAL FLOW: _____ INNOVATIVE LETTER: _____

INSTALLED BY: Tony Carroll INSTALLATION APPROVED BY: Vjm
PROPRIETARY SYSTEM: _____ FILTER NO: _____
COMMENTS:

OPERATIONS PERMIT ISSUED? X OP DATE: 1-31-05 BY: Christy Manzi RS

This permit is based in part on information provided by the homeowner or his/her representative in the application submitted for this permit. The Environmental Health Specialist is not responsible for false or misleading information contained in the application. The Environmental Health Specialist is also not responsible for concealed conditions on the property or for statements in this report that may have resulted from false or misleading statements provided to him in the application. Neither Wake County nor the Environmental Health Specialist warrants that the septic tank system will continue to function satisfactorily in the future or that the water supply will remain potable.

As Built Information:

Date: 1-31-05 Benchmark: _____ Rod reading: _____ Distance to Structure: _____
ST: 1000 mfg gals ID#: STB-814 D.O.M.: 10-8-04 Elev.: 85 Distance to Well: N/A
PT: _____ gals ID#: _____ D.O.M.: _____ Elev.: _____
D-box/FD/PM elev.: 9.7 Supply Line: _____ ft. Pump/Control Panel: _____
Line 1: 10.11 _____ Date: _____
Line 2: 11.5 _____ Date: _____
Line 3: 11.6 _____ Date: _____
Line 4: 11.7 _____ Date: _____
Line 5: _____ Date: _____
Distance to P/L: _____ Notes: _____

WAKE COUNTY DEPARTMENT OF ENVIRONMENTAL SERVICES WELL AND SEWAGE SITE LOCATION PERMIT
NO PERMIT(S) FOR CONSTRUCTION, LOCATION OR RELOCATION ACTIVITY SHALL BE ISSUED
UNTIL AN AUTHORIZATION FOR WASTEWATER SYSTEM CONSTRUCTION HAS BEEN ISSUED

PERMIT VOID IF NOT IN COMPLIANCE WITH ZONING REGULATIONS AND/ OR IF SITE IS ALTERED OR INTENDED USE CHANGED

PERMIT#: D031625 STATUS: A APP. DATE: 09/22/2004 BLDG. PERMIT#: 0050988
PIN: 0685.01 36 6453 000 TAX MAP: 0879 0000 RECORDED: Y ORIG. PERMIT#:
TOWNSHIP: 12 MIDDLE CREEK JURISDICTION: WC ZONING: R30
APPLICANT: CUSTOM CRAFT BUILDERS INC
29 NEIGHBOR LANE
FOUR OAKS, NC 27524
(919) 669 - 3813
USE: HD USE: 101 ONE-FAMILY HOUSE
EXIST USE:
DISPOSAL: BEDROOMS: 3 BASEMENT: N #EMPLOYEES: 0 FOUND DRAIN:
SITE: ADDRESS: 7721 PEGRAM ST
SUBDIVISION: WESTMOOR LOT: 16 ACRES: 0.46
DIRECTION: WALTER MYATT RD, TL KENNEBEC RD TL BUD LIBSCOMB
S/D ON RT

IMPROVEMENT PERMIT

TANK SIZE: 1000 gal. PUMP Tank: ____ gal. SQ FT: 900 STONE DEPTH: 12 in. MAX DEPTH LINE: 24 in.
WASTEWATER: INDIVIDUAL SEWAGE: DOMESTIC TYPE SYSTEM: III B PUMP: N P/M: N
DAILY FLOW: 360 gal/day DESIGN FEE REQ?: PAID?: WATER: COMMUNITY

COMMENTS:

IP ISSUED? Y DATE: 09/30/2004 BY: (TXW)  PHONE#: 856-7433

AUTHORIZATION FOR WASTEWATER/WATER SYSTEM CONSTRUCTION

VOID SIXTY (60) MONTHS FROM DATE OF ISSUANCE

AUTHORIZATION CONDITIONS:

Contractors shall install system on contours, see attached site plan for wastewater system design and well location. No underground utilities, water lines or sprinkler systems may be located in the original system or repair areas. A septic tank filter with a riser for access is required. The wastewater system shall not be covered or placed into use until inspected by the Wake County Department of Environmental Services and an Operation Permit issued. **OTHER CONDITIONS:**

MAINTAIN ALL SETBACKS. INSTALL ALL LINES ON CONTOUR. LINES SHOULD BE INSTALLED AS 4 @ 75' OF INNOVATIVE. TANK SIZE SHOULD BE 1000 GAL., MAX TRENCH DEPTH IS 24", AND TOTAL SYSTEM AREA IS 900 SQ.FT. PLEASE CALL THE OFFICE WITH ANY QUESTIONS OR CONCERNS PRIOR TO INSTALLATION.

TANK SIZE: 1000 gal. PUMP TANK: ____ gal. SQ FT: 900 STONE DEPTH: 12 in. MAX DEPTH LINE: 24 in.
MAINT: N OPER: N L/O: Y TRENCH#: 4 LENGTH: 75 ft. WIDTH: 36 in. DESIGNER: ____
SUBFIELDS: ____ DESIGN HEAD PRESSURE: ____ DESIGN FLOW: ____ gal/min DOSE VOLUME: ____ gal.

CA ISSUED? Y DATE: 09/30/2004 BY: (TXW)  PHONE#: 856-7433


MINIMUM BUILDING SETBACKS

FRONT.....15'
SIDE.....05'
REAR.....15'

7721 **AS Built**
PEGRAM STREET 50' R/W (PUBLIC)

N01°25'52"E 90.02'

Zoning R30 By C.H.C.
Approve ✓ Date 9/21/04
Revise _____ Use 101
Reject _____ MBL _____
Front 15 Rear 30
Side 5 Corner _____
Comments:

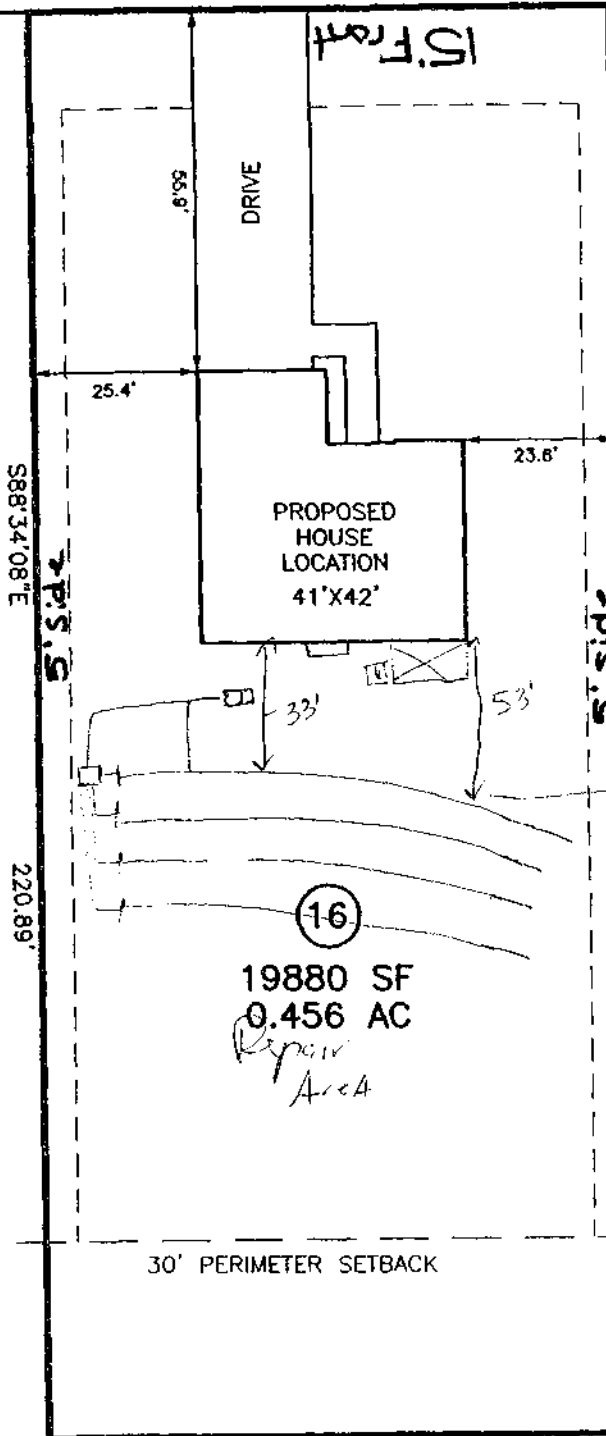

(17)

Additional 20' of E-Z-Flow at this measurement.

Drawing may not be accurate to scale

All measurements are correct

30' PERIMETER SETBACK

S01°22'49"W 90.02'
SR 2760 JAMES AUSTIN ROAD
60' R/W (PUBLIC) MAXIMUM ISA: 3777 SF
IMPERVIOUS SURFACE TABLE

NOTES:

PUBLIC WATER SYSTEM ☒ YES ☐ NO
WELL ☐ YES ☒ NO
PUBLIC SEWER SYSTEM ☐ YES ☒ NO
HOUSE DIMENSIONS: 41' X 42'

HOUSE.....1488 SF
DRIVE & WALK.....1125 SF
TOTAL.....2613 SF
LOT AREA.....19880 SF
PERCENTAGE OF IMPERVIOUS AREA.....13.14%

PLOT PLAN
OF
LOT 16
WESTMOOR
WAKE COUNTY
FOR
CUSTOM CRAFT BUILDERS
SCALE: 1" = 30'

TRUE LINE SURVEYING, P.C.



205 W. MAIN STREET
CLAYTON, N.C. 27520
TELEPHONE: (919) 359-0427
FAX: (919) 359-0428
www.truelinesurveying.com

JOB NO: 477.008 DRAWN: SHEILA DATE: 09/15/04 CHECKED: CURK

W 003336

7721

Pin: 068501366453


I certify that the location of planned or existing structure(s) are accurately shown. I understand failure to locate structures in accordance with this plot plan may require the relocation of structure(s) regardless degree of completion. I hereby grant permission to Municipal/County Representatives the right of entry to make evaluations or inspections upon this property.

Signature of Owner or Authorized Agent

0080935

Zoning R30 By SL
Approve ☒ Date 09/17/07
Revise 434
Reject MBL 101
Front 15 Rear 30
Side 5 Corner
Comments SCREEN PORCH

5'S

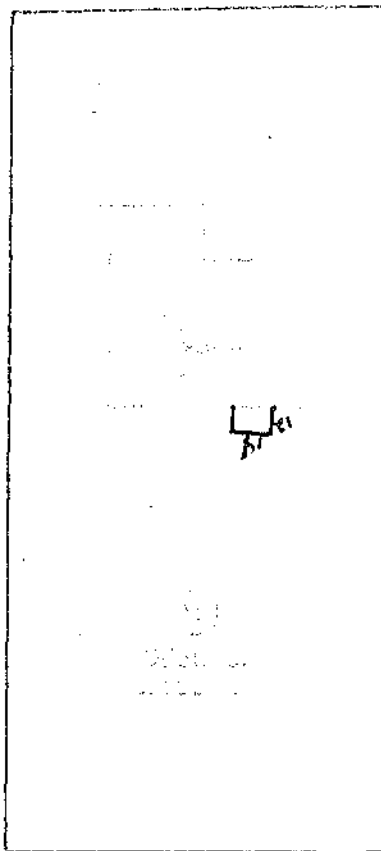

30R

Site plan approved as shown for 12x14 Screen Porch
Any changes to site plan voids approval. All setbacks apply for septic systems and wells, regarding any pools, decks, additions and/or accessory structures. Applicant is responsible for protecting all portions of the septic system, repair area and wells from damage during construction. Adhere to all Local and State Rules.
Reviewed by [Signature] Date 9/17/07
County Department of Environmental Services
Solid and Waste/Water Section

Screen porch
168.5 FT

2781

ISA 3777