

Environmental Services - Water Quality
Onsite Wastewater Scan Data Entry Form

PERMIT #: D038398

PIN #: 0689144407

OP DATE: 0312312007

SYSTEM USE:

- ☒ House
☐ Mobile Home
☐ Business
☐ Other

SEWAGE TYPE:

- ☒ Domestic
☐ Industrial

PUMP/SIPHON?:

- ☒ Yes
☐ No

PRESSURE MANIFOLD:

- ☐ Yes
☒ No

SYSTEM TYPE:

- ☐ I
☐ II
☒ III
☐ IV
☐ V
☐ VI
☐ Other

SUB TYPE:

- ☐ A
☒ B
☐ C
☐ D
☐ E
☐ F
☐ G

NBR BEDROOMS:

- ☐ 1
☐ 2
☐ 3
☒ 4
☐ 5
☐ 6
☐ Other

MAINT. SCHEDULE:

- ☐ Yes
☒ No

CERT. OPERATOR

- ☐ Yes
☒ No

GT	ST	PT	SIZE
☐	☐		750
☐	☐	☐	900
☐	☐	☐	1,000
☐	☒	☒	1,200
☐	☐	☐	1,500
☐	☐	☐	1,800
☐	☐	☐	2,100
☐	☐	☐	2,500
☐	☐	☐	3,000
☐	☐	☐	4,000
☐	☐	☐	5,000
☐	☐	☐	8,000
☐	☐	☐	10,000
☐	☐	☐	Other
☒		☐	None/NA GT or PT

DRAINFIELD SIZE(SQ. FT.)

01200

DRAIN TYPE:

- ☐ Stone
☐ EZ Flow
☐ Infiltrator
☐ Biodiffuser
☐ Cultec
☐ Drip
☐ Hancor
☐ Large Dia. Pipe
☐ Multi-Pipe
☒ Other

MAX DEPTH (IN.):

- ☐ 12 in. or less
☐ 18 in. or less
☒ 24 in. or less
☐ 26 in. or less
☐ 28 in. or less
☐ 30 in. or less
☐ 32 in. or less
☐ 36 in. or less
☐ Other

STONE DEPTH (IN.):

- ☐ 8 in. or less
☒ 12 in. or less
☐ 18 in. or less
☐ 24 in. or less
☐ Other

TRENCHES:

- ☒ Individual
☐ Bed

TRENCH WIDTH (IN.):

- ☐ 12 in. or less
☐ 18 in.
☐ 24 in.
☒ 36 in.
☐ 6 ft. or less
☐ 9 ft. or less
☐ Other

WAKE COUNTY DEPARTMENT OF ENVIRONMENTAL SERVICES WELL AND SEWAGE SITE LOCATION PERMIT
NO PERMIT(S) FOR CONSTRUCTION, LOCATION OR RELOCATION ACTIVITY SHALL BE ISSUED
UNTIL AN AUTHORIZATION FOR WASTEWATER SYSTEM CONSTRUCTION HAS BEEN ISSUED
PERMIT VOID IF NOT IN COMPLIANCE WITH ZONING REGULATIONS AND/ OR IF SITE IS ALTERED OR INTENDED USE CHANGED

PERMIT#: D038398 STATUS: A APP. DATE: 10/23/2006 BLDG. PERMIT#: 0071367
PIN: 0689.03 14 4407 000 TAX MAP: 0 RECORDED: Y ORIG. PERMIT#:
TOWNSHIP: 12 MIDDLE CREEK JURISDICTION: WC ZONING: R30
APPLICANT: STRONG BUILT HOMES
732 TREBOR DR.
GARNER, NC 27529
(919) 662-2624
USE: HD USE: 101 ONE-FAMILY HOUSE
EXIST USE:
DISPOSAL: BEDROOMS: 4 BASEMENT: N #EMPLOYEES: 0
SITE: ADDRESS: 2612 WHISTLEBERRY CT
SUBDIVISION: HICKORY CREEK LOT: 3 ACRES: 0.78
DIRECTION: 401 S TR ON 1010 HWY TL ON LAKE WHEELER TR ON O
PTIMIST FARM RD CORNER OPTIMIST & JOHNSON POND

Well System: WATER: COMMUNITY TYPE: EXISTING

WELL LOG INFORMATION: DEPTH: _____ CASING DEPTH: _____ YIELD: _____ STATIC LEVEL: _____
WELLI CONTRACTOR: _____ REG.# _____ PUMP CONTRACTOR: _____ REG.# _____
Construction Compliance GROUT APPROVED ☐ DATE _____ EHS _____
WELLHEAD APPROVED ☐ DATE _____ EHS _____
SYSTEM FINALIZED ☐ DATE _____ EHS _____

COMMENTS: COMMUNITY WATER

DESIGN FLOW: _____ gal./min. ACTUAL FLOW: _____ INNOVATIVE LETTER: _____
Operation Permit

INSTALLED BY: Jason Matthews INSTALLATION APPROVED BY: Caroline Hugg
PROPRIETARY SYSTEM: _____ FILTER NO: Blue polylok
COMMENTS: _____

OPERATIONS PERMIT ISSUED? Y OP DATE: 3/23/07 BY: Caroline Hugg 4/25/07

This permit is based in part on information provided by the homeowner or his/her representative in the application submitted for this permit. The Environmental Health Specialist is not responsible for false or misleading information contained in the application. The Environmental Health Specialist is also not responsible for concealed conditions on the property or for statements in this report that may have resulted from false or misleading statements provided to him in the application. Neither Wake County nor the Environmental Health Specialist warrants that the septic tank system will continue to function satisfactorily in the future or that the water supply will remain potable.

As Built Information:

Date: 3/23 Benchmark: top of ST Rod reading: 60" Distance to Structure: _____
ST: BTS1200 gals ID#: STB106 D.O.M.: 8-8-06 Elev.: 60" Distance to Well: _____
PT: BTS1200 gals ID#: PT213 D.O.M.: 8-8-06 Elev.: 60"
D-box/FD/PM elev.: 42" Supply Line: _____ ft. Pump/Control Panel: _____
Line 1: 62" 62" 62" Date: 3/23 Line 6: _____ Date: _____
Line 2: 67" 67" 67" Date: ↓ Line 7: _____ Date: _____
Line 3: 68" 68" 68" Date: ↓ Line 8: _____ Date: _____
Line 4: _____ Date: _____ Line 9: _____ Date: _____
Line 5: _____ Date: _____ Line 10: _____ Date: _____
Distance to P/L: _____ Notes: _____

WAKE COUNTY DEPARTMENT OF ENVIRONMENTAL SERVICES WELL AND SEWAGE SITE LOCATION PERMIT

NO PERMIT(S) FOR CONSTRUCTION, LOCATION OR RELOCATION ACTIVITY SHALL BE ISSUED
UNTIL AN AUTHORIZATION FOR WASTEWATER SYSTEM CONSTRUCTION HAS BEEN ISSUED

PERMIT VOID IF NOT IN COMPLIANCE WITH ZONING REGULATIONS AND/ OR IF SITE IS ALTERED OR INTENDED USE CHANGED

PERMIT#: D038398 STATUS: A APP. DATE: 10/23/2006 BLDG. PERMIT#: 0071367
PIN: 0689.03 14 4407 000 TAX MAP: 0 RECORDED: Y ORIG. PERMIT#:
TOWNSHIP: 12 MIDDLE CREEK JURISDICTION: WC ZONING: R30
APPLICANT: STRONG BUILT HOMES
732 TREBOR DR.
GARNER, NC 27529
(919) 662 - 2624
USE: HD USE: 101 ONE-FAMILY HOUSE
EXIST USE:
DISPOSAL: BEDROOMS: 4 BASEMENT: N #EMPLOYEES: 0 FOUND DRAIN: Y
SITE: ADDRESS: 2612 WHISTLEBERRY CT
SUBDIVISION: HICKORY CREEK LOT: 3 ACRES: 0.78
DIRECTION: 401 S TR ON 1010 HWY TL ON LAKE WHEELER TR ON O
PTIMIST FARM RD CORNER OPTIMIST & JOHNSON POND

IMPROVEMENT PERMIT

TANK SIZE: 1200 gal. PUMP Tank: 1200 gal. SQ FT: 1200 INNOVATIVE MAX DEPTH LINE: 24 in.
WASTEWATER: INDIVIDUAL SEWAGE: DOMESTIC TYPE SYSTEM: III G PUMP: Y P/M: N
DAILY FLOW: 480 gal/day DESIGN FEE REQ?: PAID?: WATER: COMMUNITY

COMMENTS:

IP ISSUED? Y DATE: 11/03/2006 BY: (TAH) *Travis A. Howard* PHONE#: 369-5974

AUTHORIZATION FOR WASTEWATER/WATER SYSTEM CONSTRUCTION

VOID SIXTY (60) MONTHS FROM DATE OF ISSUANCE

AUTHORIZATION CONDITIONS:

Contractors shall install system on contours, see attached site plan for wastewater system design and well location. No underground utilities, water lines or sprinkler systems may be located in the original system or repair areas. A septic tank filter with a riser for access is required. The wastewater system shall not be covered or placed into use until inspected by the Wake County Department of Environmental Services and an Operation Permit issued. An Accepted Status System may be used in place of conventional system, if it can be placed in the permitted/authorized trench footprint (except reduction in line length and/or number as allowed for in approval) and the installation is in accordance with the accepted system approval, without unauthorized product alteration. If permit required use of an Accepted Status System, substitution with another accepted status system may be made, as long as no changes are necessary in the location of each nitrification line (including any increase in line length), trench depth or effluent distribution method. If changes are necessary, prior approval by this office is required before system installation. **OTHER CONDITIONS:**


SYSTEM DESIGNED AS AN ACCEPTED STATUS SYSTEM WITH A 25% REDUCTION IN DRAIN LINE LENGTH TAKEN. A 1200 GALLON SEPTIC AND PUMP TANK ARE REQUIRED. PUMP TO A DISTRIBUTION BOX THAT FEEDS THREE 135'X 3' DRAIN LINES. THE MAXIMUM TRENCH DEPTH IS 24". BE AWARE OF FUTURE POOL SITE AREA. THIS AREA WILL NEED TO BE PRESERVED BY MAINTAINING 15' OFF INITIAL AND REPAIR DRAINLINES. PROTECT REPAIR AREA AND MAINTAIN PROPER FOUNDATION AND PROPERTY LINE SETBACKS. CALL PRIOR TO INSTALLATION WITH QUESTIONS OR CONCERNS. TAH

TANK SIZE: 1200 gal. PUMP TANK: 1200 gal. SQ FT: 1200 INNOVATIVE MAX DEPTH LINE: 24 in.
MAINT: N OPER: N L/O: Y TRENCH#: 3 LENGTH: 135 ft. WIDTH: 36 in. DESIGNER:
SUBFIELDS: _ DESIGN HEAD PRESSURE: _ DESIGN FLOW: _ gal/min DOSE VOLUME: _ gal.

CA ISSUED? Y DATE: 11/07/2006 BY: (TAH) *Travis A. Howard* PHONE#: 369-5974

AS BUILT ^{Sealed only}

071367

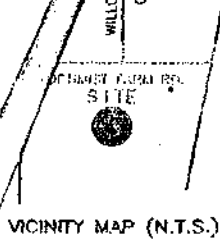

- LEGEND**
- NTS NOT TO SCALE
 - EIP EXISTING IRON PIPE
 - FP POWER POLE
 - W/M WATER METER
 - TB TELEPHONE BOX
 - IPS IRON PIPE SET
 - CP8L TRANSFORMER
 - CTV CABLE TV BOX
 - L. POLE LIGHT POLE
 - GRPL OVERHEAD POWER LINE
 - F.E.S. FLARED END SECTION (PIPE)
 - RCP REINFORCED CONC. PIPE
 - B.O.C. BACK OF CURB
 - F.H. FIRE HYDRANT
 - CNO SEWER CLEAN OUT
 - EIS EXISTING IRON STAKE
 - M.H. MANHOLE
 - ECM EXISTING CONCRETE MONUMENT
 - P.K. PARKER KALON NAIL

IMPERVIOUS SURFACE TABLE

HOUSE & FUT. GAR.	3347
DRIVEWAY	1346
SIDEWALK	195
TOTAL IMPERVIOUS AREA	4888
TOTAL LOT AREA	34,206
PERCENTAGE OF IMPERVIOUS AREA	14.29%


IMPERVIOUS SURFACE COVERAGE ALLOWED
PER B.O.M.2006 PG.1156-1157 IS 5074 SQ. FT.
AREA IN FUTURE POOL IS 300 SQ. FT.
NOT SHOWN IN TABLE

FMRK, L.L.C.
D.B.11645 PG.467
B.O.M.1956 PG.105

PLAT # 0689 03 14 4507 000

I certify that the location of planned or existing structure(s) are accurately shown. I understand failure to locate structures in accordance with this plat plan may require the relocation of structure(s) regardless to degree of completion. I hereby grant permission to Municipal/County Representatives the right of entry to make evaluations or inspections upon this property.

Signature of Owner or Authorized Agent

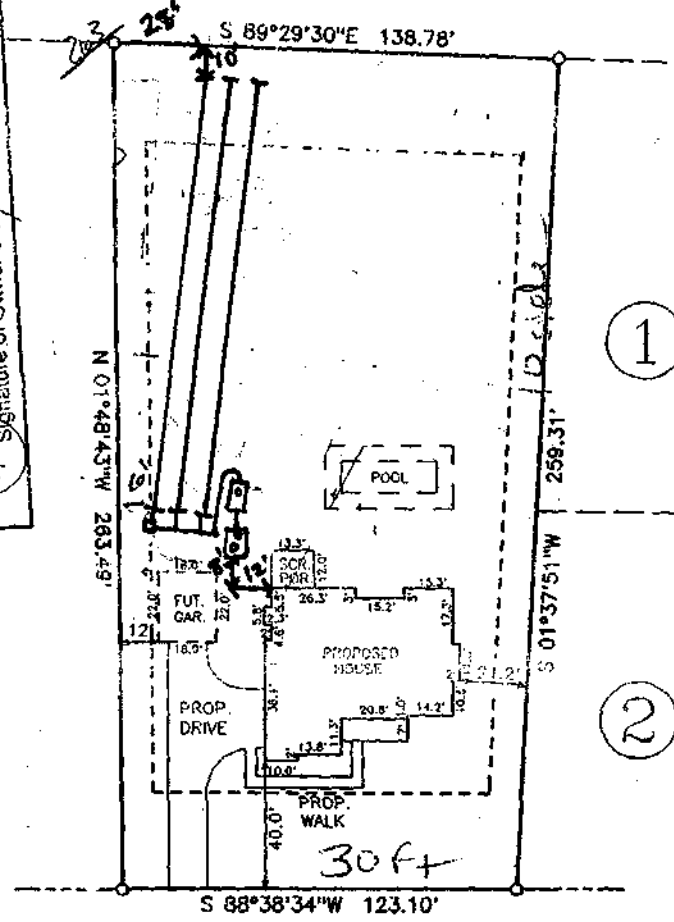

Zoning: R30 By: Sent

Approved: [Signature] Date: 10/23/06

Revised: Use: 101 - Z

Revised: MBL

Front: 30 Rear: 30


Side: 10 Corner:

Comments:

N.C. GRID NORTH, NAD 83
(B.O.M.2006 PG.1156-1157)

2012 WHISTLEBERRY COURT
(50' PUBLIC R/W)


NOTE: SHOWN IS LOT 3 OF
HICKORY CREEK S/D
REF: B.O.M.2006 PG.1156-1157

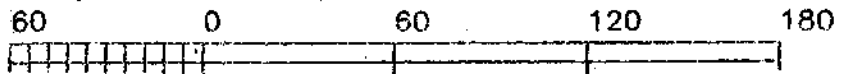

CA

Septic only

0071367

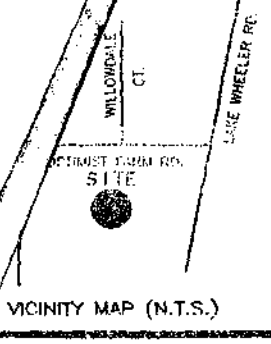

- LEGEND**
- NTS NOT TO SCALE
 - EIP EXISTING IRON PIPE
 - FP POWER POLE
 - W/M WATER METER
 - TB TELEPHONE BOX
 - IPS IRON PIPE SET
 - CPBL TRANSFORMER
 - CTV CABLE TV BOX
 - L. POLE LIGHT POLE
 - OHPL OVERHEAD POWER LINE
 - F.E.S. FLARED END SECTION (PIPE)
 - RCP REINFORCED CONC. PIPE
 - B.O.C. BACK OF CURB
 - F.H. FIRE HYDRANT
 - CNO SEWER CLEAN OUT
 - EIS EXISTING IRON STAKE
 - M.H. MANHOLE
 - ECM EXISTING CONCRETE MONUMENT
 - P.K. PARKER KALON NAIL

IMPERVIOUS SURFACE TABLE

HOUSE & FUT. GAR.	3347
DRIVEWAY	1346
SIDEWALK	199
TOTAL IMPERVIOUS AREA	4888
TOTAL LOT AREA	34,206

PERCENTAGE OF IMPERVIOUS AREA 14.29%


IMPERVIOUS SURFACE COVERAGE ALLOWED
PER B.O.M.2006 PG.1156-1157 IS 5074 SQ. FT.
AREA IN FUTURE POOL IS 300 SQ. FT.
NOT SHOWN IN TABLE

Pin # 0689 03 14 4507 000

I certify that the location of planned or existing structure(s) are accurately shown. I understand failure to locate structures in accordance with this plot plan may require the relocation of structure(s) regardless degree of completion. I hereby grant permission to Municipal/County Representatives the right of entry to make evaluations or inspections upon this property.

Signature of Owner or Authorized Agent

FMRK, L.L.C.
D.B.11645 PG.467
B.O.M.1956 PG.105

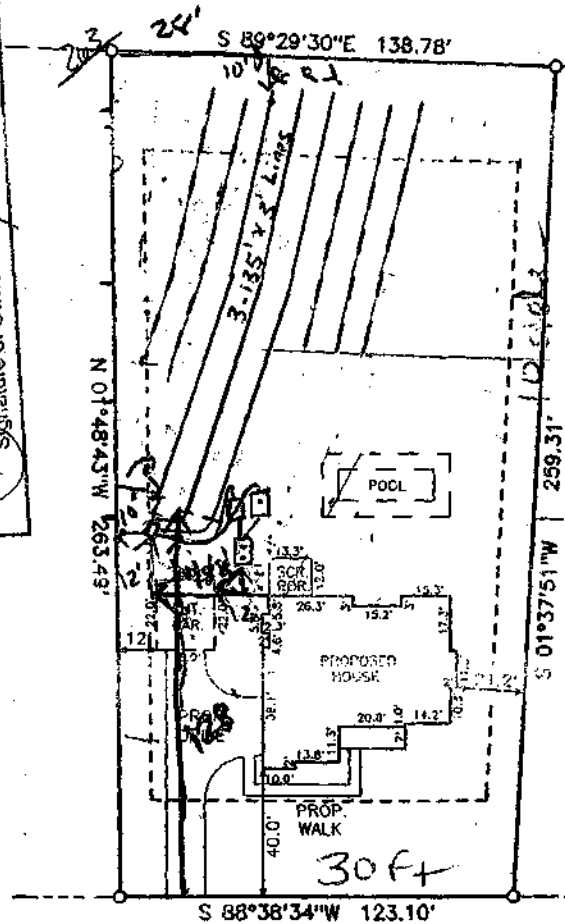

Initial - Accepted Status → 25% Red. Taken
0.3 LAR - 1200 gallon septic & pump tank
- Pump to D-Box
- 3- 135'x3' Lines
- 24" Max Trench Depth

- Be aware of future pool site shown & maintain 15' off initial
- Repair drain lines

By P30 Date 10/23/00 Use MBL MBL MBL
Revised 30 Rear 30 Corner 10
Comments:

Repair - Accepted Status
0.3 LAR - 1200 gall. ST & PT
- Pressure Manifold
- 5- 80'x3' Lines

2012 WHISTLEBERRY COURT
(50' PUBLIC R/W)

