

Environmental Services - Water Quality
Onsite Wastewater Scan Data Entry Form

PERMIT #: 0021039

PIN #: 0687938936

OP DATE: 07/11/2001

SYSTEM USE:

- ☒ House
☐ Mobile Home
☐ Business
☐ Other

SEWAGE TYPE:

- ☒ Domestic
☐ Industrial

PUMP/SIPHON?:

- ☐ Yes
☒ No

PRESSURE MANIFOLD:

- ☐ Yes
☒ No

SYSTEM TYPE:

- ☐ I
☐ II
☒ III
☐ IV
☐ V
☐ VI
☐ Other

SUB TYPE:

- ☐ A
☐ B
☐ C
☐ D
☐ E
☐ F
☒ G

NBR BEDROOMS:

- ☐ 1
☐ 2
☒ 3
☐ 4
☐ 5
☐ 6
☐ Other

MAINT. SCHEDULE:

- ☐ Yes
☒ No

CERT. OPERATOR

- ☐ Yes
☒ No

GT ST PT SIZE

- | | | | |
|-------------------------------------|-------------------------------------|-------------------------------------|------------------|
| ☐ | ☐ | | 750 |
| ☐ | ☐ | ☐ | 900 |
| ☐ | ☒ | ☐ | 1,000 |
| ☐ | ☐ | ☐ | 1,200 |
| ☐ | ☐ | ☐ | 1,500 |
| ☐ | ☐ | ☐ | 1,800 |
| ☐ | ☐ | ☐ | 2,100 |
| ☐ | ☐ | ☐ | 2,500 |
| ☐ | ☐ | ☐ | 3,000 |
| ☐ | ☐ | ☐ | 4,000 |
| ☐ | ☐ | ☐ | 5,000 |
| ☐ | ☐ | ☐ | 8,000 |
| ☐ | ☐ | ☐ | 10,000 |
| ☐ | ☐ | ☐ | Other |
| ☒ | | ☒ | None/NA GT or PT |

DRAINFIELD SIZE(SQ. FT.)

00900

DRAIN TYPE:

- ☐ Stone
☒ EZ Flow
☐ Infiltrator
☐ Biodiffuser
☐ Cultec
☐ Drip
☐ Hancor
☐ Large Dia. Pipe
☐ Multi-Pipe
☐ Other

MAX DEPTH (IN.):

- ☐ 12 in. or less
☐ 18 in. or less
☒ 24 in. or less
☐ 26 in. or less
☐ 28 in. or less
☐ 30 in. or less
☐ 32 in. or less
☐ 36 in. or less
☐ Other

STONE DEPTH (IN.):

- ☐ 8 in. or less
☒ 12 in. or less
☐ 18 in. or less
☐ 24 in. or less
☐ Other

TRENCHES:

- ☒ Individual
☐ Bed

TRENCH WIDTH (IN.):

- ☐ 12 in. or less
☐ 18 in.
☐ 24 in.
☒ 36 in.
☐ 6 ft. or less
☐ 9 ft. or less
☐ Other

B.W 7/29/14

WAKE COUNTY DEPARTMENT OF ENVIRONMENTAL SERVICES WELL AND SEWAGE SITE LOCATION PERMIT
NO PERMIT(S) FOR CONSTRUCTION, LOCATION OR RELOCATION ACTIVITY SHALL BE ISSUED
UNTIL AN AUTHORIZATION FOR WASTEWATER SYSTEM CONSTRUCTION HAS BEEN ISSUED

PERMIT VOID IF NOT IN COMPLIANCE WITH ZONING REGULATIONS AND/ OR IF SITE IS ALTERED OR INTENDED USE CHANGED

PERMIT#: D021039 STATUS: A APP. DATE: 03/12/2001 BLDG. PERMIT#: 0012993
PIN: 0687.04 93 8936 000 TAX MAP: 0324 RECORDED: Y ORIG. PERMIT#:
TOWNSHIP: 12 MIDDLE CREEK JURISDICTION: WC ZONING: R30
APPLICANT: COMFORT HOMES
P. O. BOX 369
CLAYTON, NC 27592
(919) 553 - 3242
USE: HD USE: 101 ONE-FAMILY HOUSE
EXIST USE:
DISPOSAL: N BEDROOMS: 3 BASEMENT: N #EMPLOYEES: 5
SITE: ADDRESS: 6512 BRIDGEMONT LA
SUBDIVISION: WILLOW BLUFFS LOT: 130 ACRES: 0.56
DIRECTION: 401 S LEFT ON SR 1006 TO RIGHT IN SUB

Well System: WATER: COMMUNITY - TYPE: IRRIGATION

WELL LOG INFORMATION: DEPTH: _____ CASING DEPTH: _____ YIELD: _____ STATIC LEVEL: _____
WELL CONTRACTOR: _____ REG.# _____ PUMP CONTRACTOR: _____ REG.# _____
Construction Compliance GROUT APPROVED ☐ DATE _____ EHS _____
WELLHEAD APPROVED ☐ DATE _____ EHS _____
SYSTEM FINALIZED ☐ DATE _____ EHS _____

COMMENTS:

Operation Permit

DESIGN FLOW: _____ gal./min. ACTUAL FLOW: _____ INNOVATIVE LETTER: Y
INSTALLED BY: Jeff Thompson INSTALLATION APPROVED BY: Ra Duff Rs.
PROPRIETARY SYSTEM: _____ FILTER NO: _____
COMMENTS:

OPERATIONS PERMIT ISSUED? _____ OP DATE: 7/11/01 BY: _____

This permit is based in part on information provided by the homeowner or his/her representative in the application submitted for this permit. The Environmental Health Specialist is not responsible for false or misleading information contained in the application. The Environmental Health Specialist is also not responsible for concealed conditions on the property or for statements in this report that may have resulted from false or misleading statements provided to him in the application. Neither Wake County nor the Environmental Health Specialist warrants that the septic tank system will continue to function satisfactorily in the future or that the water supply will remain potable.

WAKE COUNTY DEPARTMENT OF ENVIRONMENTAL SERVICES WELL AND SEWAGE SITE LOCATION PERMIT

NO PERMIT(S) FOR CONSTRUCTION, LOCATION OR RELOCATION ACTIVITY SHALL BE ISSUED

UNTIL AN AUTHORIZATION FOR WASTEWATER SYSTEM CONSTRUCTION HAS BEEN ISSUED

PERMIT VOID IF NOT IN COMPLIANCE WITH ZONING REGULATIONS AND/ OR IF SITE IS ALTERED OR INTENDED USE CHANGED

PERMIT#: D021039 STATUS: A APP. DATE: 03/12/2001 BLDG. PERMIT#: 0012993
PIN: 0687.04 93 8936 000 TAX MAP: 0324 0000 RECORDED: Y ORIG. PERMIT#:
TOWNSHIP: 12 MIDDLE CREEK JURISDICTION: WC ZONING: R30
APPLICANT: COMFORT HOMES
P. O. BOX 369
CLAYTON, NC 27592
(919) 553 - 3242
USE: HD USE: 101 ONE-FAMILY HOUSE
EXIST USE:
DISPOSAL: N BEDROOMS: 3 BASEMENT: N #EMPLOYEES: 5
SITE: ADDRESS: 6512 BRIDGEMONT LA
SUBDIVISION: WILLOW BLUFFS LOT: 130 ACRES: 0.56
DIRECTION: 401 S LEFT ON SR 1006 TO RIGHT IN SUB

IMPROVEMENT PERMIT

TANK SIZE: 1000 gal. PUMP Tank: _____ gal. SQ FT: 900 INNOVATIVE MAX DEPTH LINE: 24 in.
WASTEWATER: INDIVIDUAL SEWAGE: DOMESTIC TYPE SYSTEM: III G PUMP: N P/M: N
DAILY FLOW: 360 gal/day WATER: COMMUNITY

COMMENTS:

IP ISSUED? Y DATE: 04/14/2001 BY: (SCR)  PHONE#: _____


AUTHORIZATION FOR WASTEWATER/WATER SYSTEM CONSTRUCTION

VOID SIXTY (60) MONTHS FROM DATE OF ISSUANCE

AUTHORIZATION CONDITIONS:

Contractors shall install system on contours, see attached site plan for wastewater system design and well location. No underground utilities, water lines or sprinkler systems may be located in the original system or repair areas. A septic tank filter with a riser for access is required. The wastewater system shall not be covered or placed into use until inspected by the Wake County Department of Environmental Services and an Operation Permit issued. **OTHER CONDITIONS:**
INITIAL SYSTEM 4 75' EZLAY, FLAGGED OUT IN FIELD. 25% REDUCTION ALREADY TAKEN. REPAIR WILL REQUIRE PRESSURE MANIFOLD WHEN NEEDED. KEEP DRIVEWAY 12' FROM PROPERTY LINE AS SHOWN ON SITE PLAN.

TANK SIZE: 1000 gal. PUMP TANK: _____ gal. SQ FT: 900 INNOVATIVE MAX DEPTH LINE: 24 in.
MAINT: N OPER: N L/O: Y TRENCH#: 4 LENGTH: 75 ft. WIDTH: 36 in.
SUBFIELDS: _____ DESIGN HEAD PRESSURE: _____ DESIGN FLOW: _____ gal/min DOSE VOLUME: _____ gal.

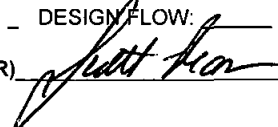CA ISSUED? Y DATE: 04/14/2001 BY: (SCR)  PHONE#: 857-9355


NOTE: BEING LOT 130 OF WILLOW BLUFFS SUBD,
PHASE 3, RECORDED IN BOM 2000, Pg 15

NOTE: AREA COMPUTED BY COORDINATE METHOD.

VICINITY MAP

**PLOT PLAN FOR
COMFORT HOMES
MIDDLE CREEK TOWNSHIP
WAKE COUNTY
NORTH CAROLINA**

LOT 1
BOM 1998
Pg 1120

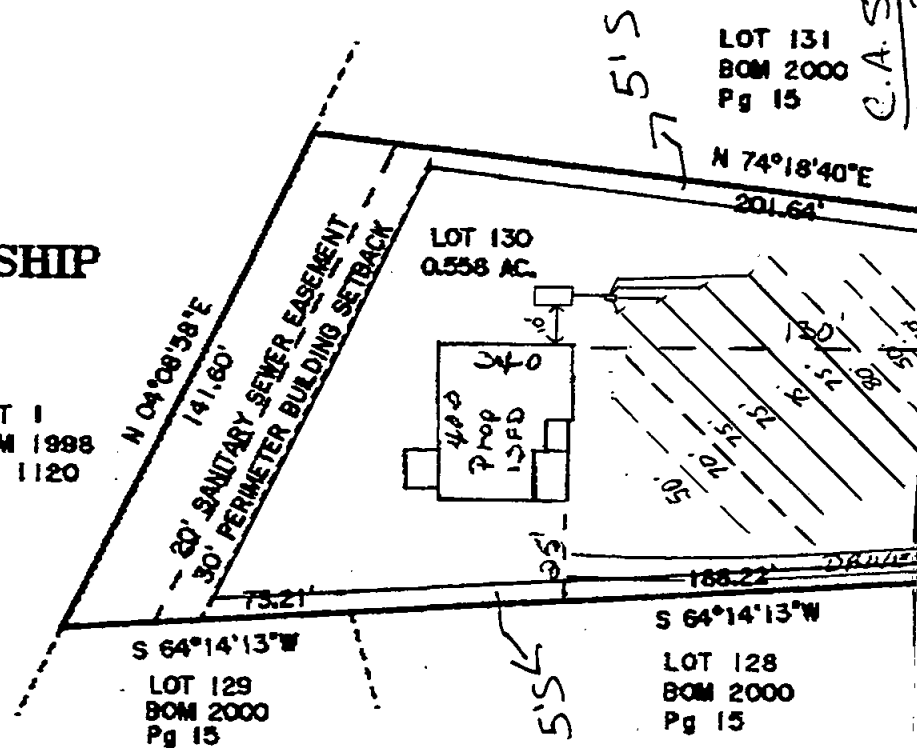

I, DANNY G. WILLIAMS, certify that under my direction and supervision
this map was drawn from an actual field survey; that the error of
closure of the survey as calculated by latitudes and departures is
1: 10,000; and that this survey meets general standards of practice
for land surveying in North Carolina.

Witness my hand and seal this day of


P.L.S. 1-2047

WILLIAMS - PEARCE & ASSOC., P.A.

BOX 892

N. C.

9605

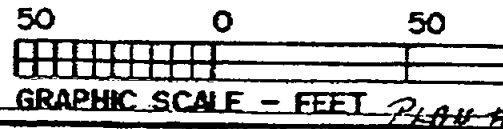

Attn: Scott Re

Revis

Comfort Homes, Inc.



P.O. Box 269 Clayton, NC 27520

919-553-3242

April 16, 2001

To: Scott Reams
Wake County
Environmental Health

Comfort Homes, Inc. requests that an EEEZZZ LAY System be installed in Willow Bluff
Subdivision for the following lot:

Lot # D#

130 21039

Thank you,

A handwritten signature in cursive script that reads "Julian Stewart".

Julian Stewart
President

JS:pw