

Environmental Services - Water Quality
Onsite Wastewater Scan Data Entry Form

PERMIT #: 6027865

PIN #: 0678268912

OP DATE: 0511611984

SYSTEM USE:

- ☒ House
☐ Mobile Home
☐ Business
☐ Other

SEWAGE TYPE:

- ☒ Domestic
☐ Industrial

PUMP/SIPHON?:

- ☐ Yes
☒ No

PRESSURE MANIFOLD:

- ☐ Yes
☒ No

SYSTEM TYPE:

- ☐ I
☒ II
☐ III
☐ IV
☐ V
☐ VI
☐ Other

SUB TYPE:

- ☒ A
☐ B
☐ C
☐ D
☐ E
☐ F
☐ G

NBR BEDROOMS:

- ☐ 1
☐ 2
☒ 3
☐ 4
☐ 5
☐ 6
☐ Other

MAINT. SCHEDULE:

- ☐ Yes
☒ No

CERT. OPERATOR

- ☐ Yes
☒ No

GT ST PT

- | | | | |
|-------------------------------------|-------------------------------------|-------------------------------------|------------------|
| ☐ | ☐ | | 750 |
| ☐ | ☐ | ☐ | 900 |
| ☐ | ☒ | ☐ | 1,000 |
| ☐ | ☐ | ☐ | 1,200 |
| ☐ | ☐ | ☐ | 1,500 |
| ☐ | ☐ | ☐ | 1,800 |
| ☐ | ☐ | ☐ | 2,100 |
| ☐ | ☐ | ☐ | 2,500 |
| ☐ | ☐ | ☐ | 3,000 |
| ☐ | ☐ | ☐ | 4,000 |
| ☐ | ☐ | ☐ | 5,000 |
| ☐ | ☐ | ☐ | 8,000 |
| ☐ | ☐ | ☐ | 10,000 |
| ☐ | ☐ | ☐ | Other |
| ☒ | | ☒ | None/NA GT or PT |

DRAINFIELD SIZE(SQ. FT.)

01000

DRAIN TYPE:

- ☒ Stone
☐ EZ Flow
☐ Infiltrator
☐ Biodiffuser
☐ Cultec
☐ Drip
☐ Hancor
☐ Large Dia. Pipe
☐ Multi-Pipe
☐ Other

MAX DEPTH (IN.):

- ☐ 12 in. or less
☐ 18 in. or less
☐ 24 in. or less
☐ 26 in. or less
☐ 28 in. or less
☒ 30 in. or less
☐ 32 in. or less
☐ 36 in. or less
☐ Other

STONE DEPTH (IN.):

- ☐ 8 in. or less
☒ 12 in. or less
☐ 18 in. or less
☐ 24 in. or less
☐ Other

TRENCHES:

- ☒ Individual
☐ Bed

TRENCH WIDTH (IN.):

- ☐ 12 in. or less
☐ 18 in.
☐ 24 in.
☒ 36 in.
☐ 6 ft. or less
☐ 9 ft. or less
☐ Other

11/14/10

WAKE COUNTY HEALTH DEPARTMENT SEPTIC TANK LAYOUT AND PERMIT

TAX MAP NO. 103 PARCEL NO. 102

PERMIT NO. B

12:00
27865

CONTRACTOR

OWNER Bill Tingen

DATE 3-27-84

LOCATION to end of out-to-sac


S. R. NO. 1343

SUBDIVISION NAME Bent Creek

LOT NO. 15

SECTION OR BLOCK NO. 2

REPAIR ☐ ORIGINAL PERMIT NO. _____
GARBAGE DISPOSAL UNIT YES ☐ NO ☒
HOUSE ☒ MOBILE HOME ☐ BUSINESS ☐
NO. BEDROOMS 3 LOT AREA 2.2 AC
SIZE OF TANK 1000 gal.
NITRIFICATION LINE 1000 - 2 (16' x 3') sq. ft.
DEPTH OF STONE IN LINES: 12" ☒
RISER AND BAFFLE REQUIRED ☒ PUMP REQUIRED ☐
WATER SUPPLY: INDIVIDUAL ☒ PUBLIC ☐ OTHER ☐
* PERMIT VOID 36 MONTHS FROM DATE OF ISSUANCE.
* PERMIT VOID IF NOT IN COMPLIANCE WITH ZONING REGULATIONS
* PERMIT MAY BE VOIDED IF SITE ALTERATIONS MADE

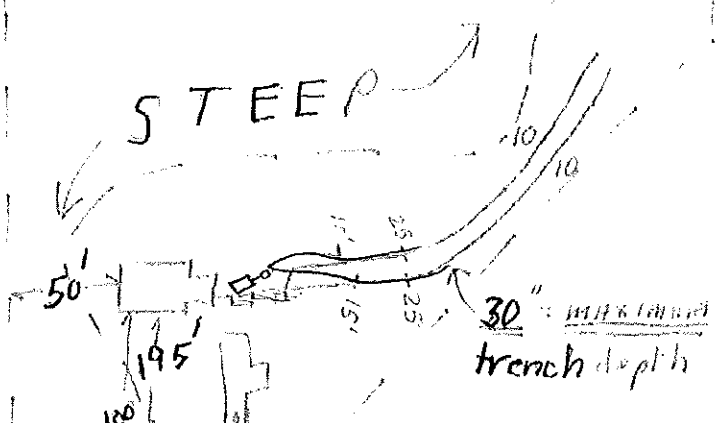

LAYOUT BY David Parnell, Jr.

590-GP09

DATE May 16, 1984
5/16/84

Charles Harder, Jr.
INSTALLED BY

David Parnell, Jr.
APPROVED BY DAVID PARNELL, JR.