

Environmental Services - Water Quality
Onsite Wastewater Scan Data Entry Form

PERMIT #: 0018325

PIN #: 0678455789

OP DATE: 01/06/1995

SYSTEM USE:

- ☒ House
☐ Mobile Home
☐ Business
☐ Other

SEWAGE TYPE:

- ☒ Domestic
☐ Industrial

PUMP/SIPHON?:

- ☒ Yes
☐ No

PRESSURE MANIFOLD:

- ☐ Yes
☒ No

SYSTEM TYPE:

- ☐ I
☐ II
☒ III
☐ IV
☐ V
☐ VI
☐ Other

SUB TYPE:

- ☐ A
☒ B
☐ C
☐ D
☐ E
☐ F
☐ G

NBR BEDROOMS:

- ☐ 1
☐ 2
☒ 3
☐ 4
☐ 5
☐ 6
☐ Other

MAINT. SCHEDULE:

- ☐ Yes
☒ No

CERT. OPERATOR

- ☐ Yes
☒ No

GT ST PT SIZE

- | | | | |
|-------------------------------------|-------------------------------------|-------------------------------------|------------------|
| ☐ | ☐ | ☐ | 750 |
| ☐ | ☐ | ☐ | 900 |
| ☐ | ☒ | ☒ | 1,000 |
| ☐ | ☐ | ☐ | 1,200 |
| ☐ | ☐ | ☐ | 1,500 |
| ☐ | ☐ | ☐ | 1,800 |
| ☐ | ☐ | ☐ | 2,100 |
| ☐ | ☐ | ☐ | 2,500 |
| ☐ | ☐ | ☐ | 3,000 |
| ☐ | ☐ | ☐ | 4,000 |
| ☐ | ☐ | ☐ | 5,000 |
| ☐ | ☐ | ☐ | 8,000 |
| ☐ | ☐ | ☐ | 10,000 |
| ☐ | ☐ | ☐ | Other |
| ☒ | ☐ | ☐ | None/NA GT or PT |

DRAINFIELD SIZE(SQ. FT.)

01060

DRAIN TYPE:

- ☒ Stone
☐ EZ Flow
☐ Infiltrator
☐ Biodiffuser
☐ Cultec
☐ Drip
☐ Hancor
☐ Large Dia. Pipe
☐ Multi-Pipe
☐ Other

MAX DEPTH (IN.):

- ☐ 12 in. or less
☐ 18 in. or less
☐ 24 in. or less
☐ 26 in. or less
☒ 28 in. or less
☐ 30 in. or less
☐ 32 in. or less
☐ 36 in. or less
☐ Other

STONE DEPTH (IN.):

- ☐ 8 in. or less
☒ 12 in. or less
☐ 18 in. or less
☐ 24 in. or less
☐ Other

TRENCHES:

- ☒ Individual
☐ Bed

TRENCH WIDTH (IN.):



- ☐ 12 in. or less
☐ 18 in.
☐ 24 in.
☒ 36 in.
☐ 6 ft. or less
☐ 9 ft. or less
☐ Other

WAKE-COUNTY HEALTH DEPARTMENT WELL AND SEWAGE SITE, LOCATION PERMIT

ALL PERMITS VOID 60 MONTHS FROM DATE OF ISSUANCE

Pin # 0678.01 45 5789 Project # 0940603 ~~2:30~~
 Tax Map No. 784 Parcel No. 162
 Zoning WAKE Township Middle Creek
 Owner/Contractor: Penny Thompson Date: 9/16/93
 Location/Address: (5104 STEUBEN PL) 4015 T/R 1393 T/R on 1404 T/L
Bent Willow T/L Doughton T/L Steuben S.R. # 1404

Subdivision Name: WEST DOORS Lot No. 70 Section or Block No. _____

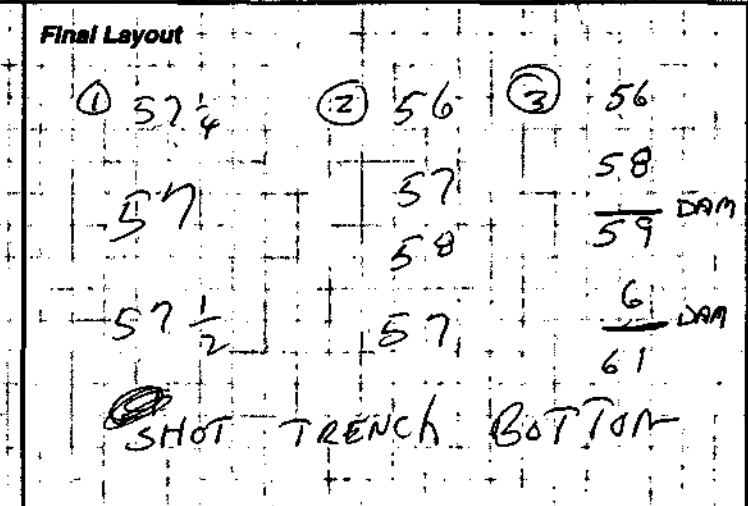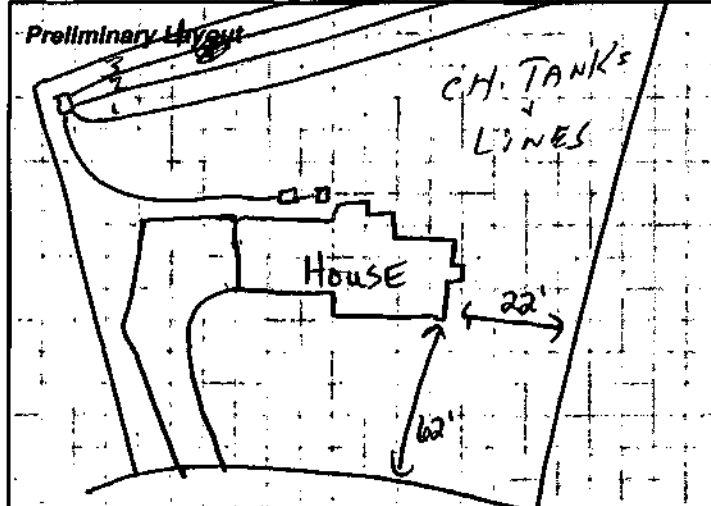

Sewage System Specifications

Repair [] Original Permit No. _____
 Garbage Disposal Unit Yes [] No [✓]
 House [✓] Mobile Home [] Business []
 No. of Bedrooms 3 Lot Area 30,000 ft.²
 Size of Tank 1000 Septic / 1000 Pump gal.
 Comments: _____

Nitrification Line (3) 110' x 3' 1000 sq. ft.
 Depth of Stone: 12" [✓] Max Depth of Trenches: 28 in.
 Riser and Baffle Required [✓] Pump Required []
 Permit void if not in compliance with zoning regulations
 Permits may be voided if site is altered or intended use changed
 Layout by: H. B. Phillips

Date: 1-6-95 Installed By: Gulley GSTR Approved By: Edward J. [Signature]

Well System
 Individual [] Semi-Public [] Public [✓]
 New [] Replacement [] Repair []
 Fee Paid: Yes [] No []
Construction Compliance
 Site Approved [] Yes [] No []
 Well Head Approved []
 Grouting Approved []

Final Inspection
 Required Slab [] Yes [] No []
 Chlorinated []
 Required Certificate []
 Variance (Explain) []
 WCHD I.D. Affixed []
 Sample Collected []

Bacteriological Results
 Date Inspected _____ Sanitarian _____
 Initial Sample: _____ Date: _____
 * Re-Sample #1 _____ Date: _____
 * Re-Sample #2 _____ Date: _____
 * Re-chlorination as required [] Yes [] No []
 * Fees for all resamples
 All checks payable to: Wake County Health Department

Comments: _____
 Well Installed By: _____
 Date System Finalized _____ Sanitarian _____

This report is based in part on information provided by the homeowner or his/her representative in the application submitted for this permit. The sanitarian is not responsible for false or misleading information contained in the application. The sanitarian is also not responsible for concealed conditions on the property or for statements in this report that may have resulted from false or misleading statements provided to him in the application. Neither Wake County nor the sanitarian warrants that the septic tank system will continue to function satisfactorily in the future or that the water supply will remain potable.

COPY TO HEALTH DEPARTMENT

3002.017 - 5/14/93