

Environmental Services - Water Quality
Onsite Wastewater Scan Data Entry Form

PERMIT #: **D 0 2 I I 3 I**

PIN #: **0 6 8 6 4 4 8 1 0 7**

OP DATE: **0 8 / 2 2 / 2 0 0 1**

LOT 15

SYSTEM USE:

- ☐ House
☒ Mobile Home
☐ Business
☐ Other

SEWAGE TYPE:

- ☒ Domestic
☐ Industrial

PUMP/SIPHON?:

- ☒ Yes
☐ No

PRESSURE MANIFOLD:

- ☐ Yes
☒ No

SYSTEM TYPE:

- ☐ I
☐ II
☒ III
☐ IV
☐ V
☐ VI
☐ Other

SUB TYPE:

- ☐ A
☒ B
☐ C
☐ D
☐ E
☐ F
☐ G

NBR BEDROOMS:

- ☐ 1
☐ 2
☐ 3
☒ 4
☐ 5
☐ 6
☐ Other

MAINT. SCHEDULE:

- ☐ Yes
☒ No

CERT. OPERATOR

- ☐ Yes
☒ No

GT ST PT SIZE

- | | | | |
|-------------------------------------|-------------------------------------|-------------------------------------|------------------|
| ☐ | ☐ | | 750 |
| ☐ | ☐ | ☐ | 900 |
| ☐ | ☐ | ☐ | 1,000 |
| ☐ | ☒ | ☒ | 1,200 |
| ☐ | ☐ | ☐ | 1,500 |
| ☐ | ☐ | ☐ | 1,800 |
| ☐ | ☐ | ☐ | 2,100 |
| ☐ | ☐ | ☐ | 2,500 |
| ☐ | ☐ | ☐ | 3,000 |
| ☐ | ☐ | ☐ | 4,000 |
| ☐ | ☐ | ☐ | 5,000 |
| ☐ | ☐ | ☐ | 8,000 |
| ☐ | ☐ | ☐ | 10,000 |
| ☐ | ☐ | ☐ | Other |
| ☒ | | ☐ | None/NA GT or PT |

DRAINFIELD SIZE(SQ. FT.)

0 1 2 0 0

DRAIN TYPE:

- ☐ Stone
☐ EZ Flow
☐ Infiltrator
☐ Biodiffuser
☐ Cultec
☐ Drip
☐ Hancor
☐ Large Dia. Pipe
☐ Multi-Pipe
☒ Other

MAX DEPTH (IN.):

- ☐ 12 in. or less
☐ 18 in. or less
☒ 24 in. or less
☐ 26 in. or less
☐ 28 in. or less
☐ 30 in. or less
☐ 32 in. or less
☐ 36 in. or less
☐ Other

STONE DEPTH (IN.):

- ☐ 8 in. or less
☐ 12 in. or less
☐ 18 in. or less
☐ 24 in. or less
☒ Other

TRENCHES:

- ☒ Individual
☐ Bed

TRENCH WIDTH (IN.):

- ☐ 12 in. or less
☐ 18 in.
☐ 24 in.
☒ 36 in.
☐ 6 ft. or less
☐ 9 ft. or less
☐ Other

WAKE COUNTY DEPARTMENT OF ENVIRONMENTAL SERVICES WELL AND SEWAGE SITE LOCATION PERMIT
NO PERMIT(S) FOR CONSTRUCTION, LOCATION OR RELOCATION ACTIVITY SHALL BE ISSUED
UNTIL AN AUTHORIZATION FOR WASTEWATER SYSTEM CONSTRUCTION HAS BEEN ISSUED

PERMIT VOID IF NOT IN COMPLIANCE WITH ZONING REGULATIONS AND/ OR IF SITE IS ALTERED OR INTENDED USE CHANGED

PERMIT#: D021131 STATUS: A APP. DATE: 03/16/2001 BLDG. PERMIT#: 0013098
PIN: 0686.03 44 6643 000 TAX MAP: 0869 RECORDED: Y ORIG. PERMIT#:
TOWNSHIP: 12 MIDDLE CREEK JURISDICTION: WC ZONING: R30
APPLICANT: ENERGY EFFICIENT HOUSING
5429 FAYETTEVILLE RD
RALEIGH, NC 27603
(919) 662 - 9235
USE: HD USE: 112 MOBILE HOME
EXIST USE:
DISPOSAL: N BEDROOMS: 4 BASEMENT: N #EMPLOYEES: 0
SITE: ADDRESS: 7229 PECAN TREE ST
SUBDIVISION: COLEY FARM LOT: 15 ACRES: 1.81
DIRECTION: SR 1006-S, TR NC 42 HWY W, TL KINTON DR, SUB AT
END OF ST.

Well System: WATER: INDIVIDUAL - TYPE: NEW

WELL LOG INFORMATION DEPTH: 36 CASING DEPTH: 185 YIELD: 25 STATIC LEVEL: 100
WELLI CONTRACTOR: Wadey Pool REG.# 479 PUMP CONTRACTOR: Strickland REG.# 8620
Construction Compliance GROUT APPROVED ☒ DATE 6/5/01 EHS Wadey Pool
WELLHEAD APPROVED ☒ DATE 8/21/01 EHS Wadey Pool
SYSTEM FINALIZED ☐ DATE _____ EHS _____

COMMENTS:

DESIGN FLOW: _____ gal./min. ACTUAL FLOW: _____ INNOVATIVE LETTER: _____
INSTALLED BY: Ray Moore INSTALLATION APPROVED BY: Wadey Pool
PROPRIETARY SYSTEM: _____ FILTER NO: _____
COMMENTS:

OPERATIONS PERMIT ISSUED? yes OP DATE: 8-22-01 BY: MTB

This permit is based in part on information provided by the homeowner or his/her representative in the application submitted for this permit. The Environmental Health Specialist is not responsible for false or misleading information contained in the application. The Environmental Health Specialist is also not responsible for concealed conditions on the property or for statements in this report that may have resulted from false or misleading statements provided to him in the application. Neither Wake County nor the Environmental Health Specialist warrants that the septic tank system will continue to function satisfactorily in the future or that the water supply will remain potable.

Pump ok B 8/21/01

WAKE COUNTY DEPARTMENT OF ENVIRONMENTAL SERVICES WELL AND SEWAGE SITE LOCATION PERMIT

NO PERMIT(S) FOR CONSTRUCTION, LOCATION OR RELOCATION ACTIVITY SHALL BE ISSUED

UNTIL AN AUTHORIZATION FOR WASTEWATER SYSTEM CONSTRUCTION HAS BEEN ISSUED

PERMIT VOID IF NOT IN COMPLIANCE WITH ZONING REGULATIONS AND/ OR IF SITE IS ALTERED OR INTENDED USE CHANGED

PERMIT#: D021131 STATUS: A APP. DATE: 03/16/2001 BLDG. PERMIT#: 0013098
PIN: 0686.03 44 6643 000 TAX MAP: 0869 0004 RECORDED: Y ORIG. PERMIT#:
TOWNSHIP: 12 MIDDLE CREEK JURISDICTION: WC ZONING: R30
APPLICANT: ENERGY EFFICIENT HOUSING
5429 FAYETTEVILLE RD
RALEIGH, NC 27603
(919) 662 - 9235
USE: HD USE: 112 MOBILE HOME
EXIST USE:
DISPOSAL: N BEDROOMS: 4 BASEMENT: N #EMPLOYEES: 0
SITE: ADDRESS: 7229 PECAN TREE ST
SUBDIVISION: COLEY FARM LOT: 15 ACRES: 1.81
DIRECTION: SR 1006-S, TR NC 42 HWY W, TL KINTON DR, SUB AT
END OF ST.

IMPROVEMENT PERMIT

TANK SIZE: 1200 gal. PUMP Tank: 1200 gal. SQ FT: 1200 INNOVATIVE MAX DEPTH LINE: 24 in.
WASTEWATER: INDIVIDUAL SEWAGE: DOMESTIC TYPE SYSTEM: III G PUMP: Y P/M: N
DAILY FLOW: 480 gal/day WATER: INDIVIDUAL

COMMENTS:

IP ISSUED? Y DATE: 05/04/2001 BY: (VJM) *Clement Manzini* PHONE#: 856-7438

AUTHORIZATION FOR WASTEWATER/WATER SYSTEM CONSTRUCTION

VOID SIXTY (60) MONTHS FROM DATE OF ISSUANCE

AUTHORIZATION CONDITIONS:

Contractors shall install system on contours, see attached site plan for wastewater system design and well location. No underground utilities, water lines or sprinkler systems may be located in the original system or repair areas. A septic tank filter with a riser for access is required. The wastewater system shall not be covered or placed into use until inspected by the Wake County Department of Environmental Services and an Operation Permit issued. **OTHER CONDITIONS:**

INSTALL ON CONTOUR SET TANK MINIMUM OF 5 FEET FROM DWELLING. DRAINLINES TO BE A MINIMUM OF 100 FEET FROM WELL. *****NOTE TO APPLICANT, IT IS YOUR ULTIMATE RESPONSIBILITY TO ENSURE THAT ALL UTILITIES ARE LOCATED OUTSIDE THE AREA RESERVED FOR THE INITIAL SYSTEM.*****


TANK SIZE: 1200 gal. PUMP TANK: 1200 gal. SQ FT: 1200 INNOVATIVE MAX DEPTH LINE: 24 in.
MAINT: N OPER: N L/O: N TRENCH#: 3 LENGTH: 133 ft. WIDTH: 36 in.
SUBFIELDS: _ DESIGN HEAD PRESSURE: _ DESIGN FLOW: _ gal/min DOSE VOLUME: _ gal.

CA ISSUED? Y DATE: 05/04/2001 BY: (VJM) *Clement Manzini* PHONE#: 856-7438

BTS 1200
STB-106 5/21/01
PT 213
3/2/01

CH. TANKS, supply lines
& DRAINFIELD
8/3/01 RSD

60 = 1"

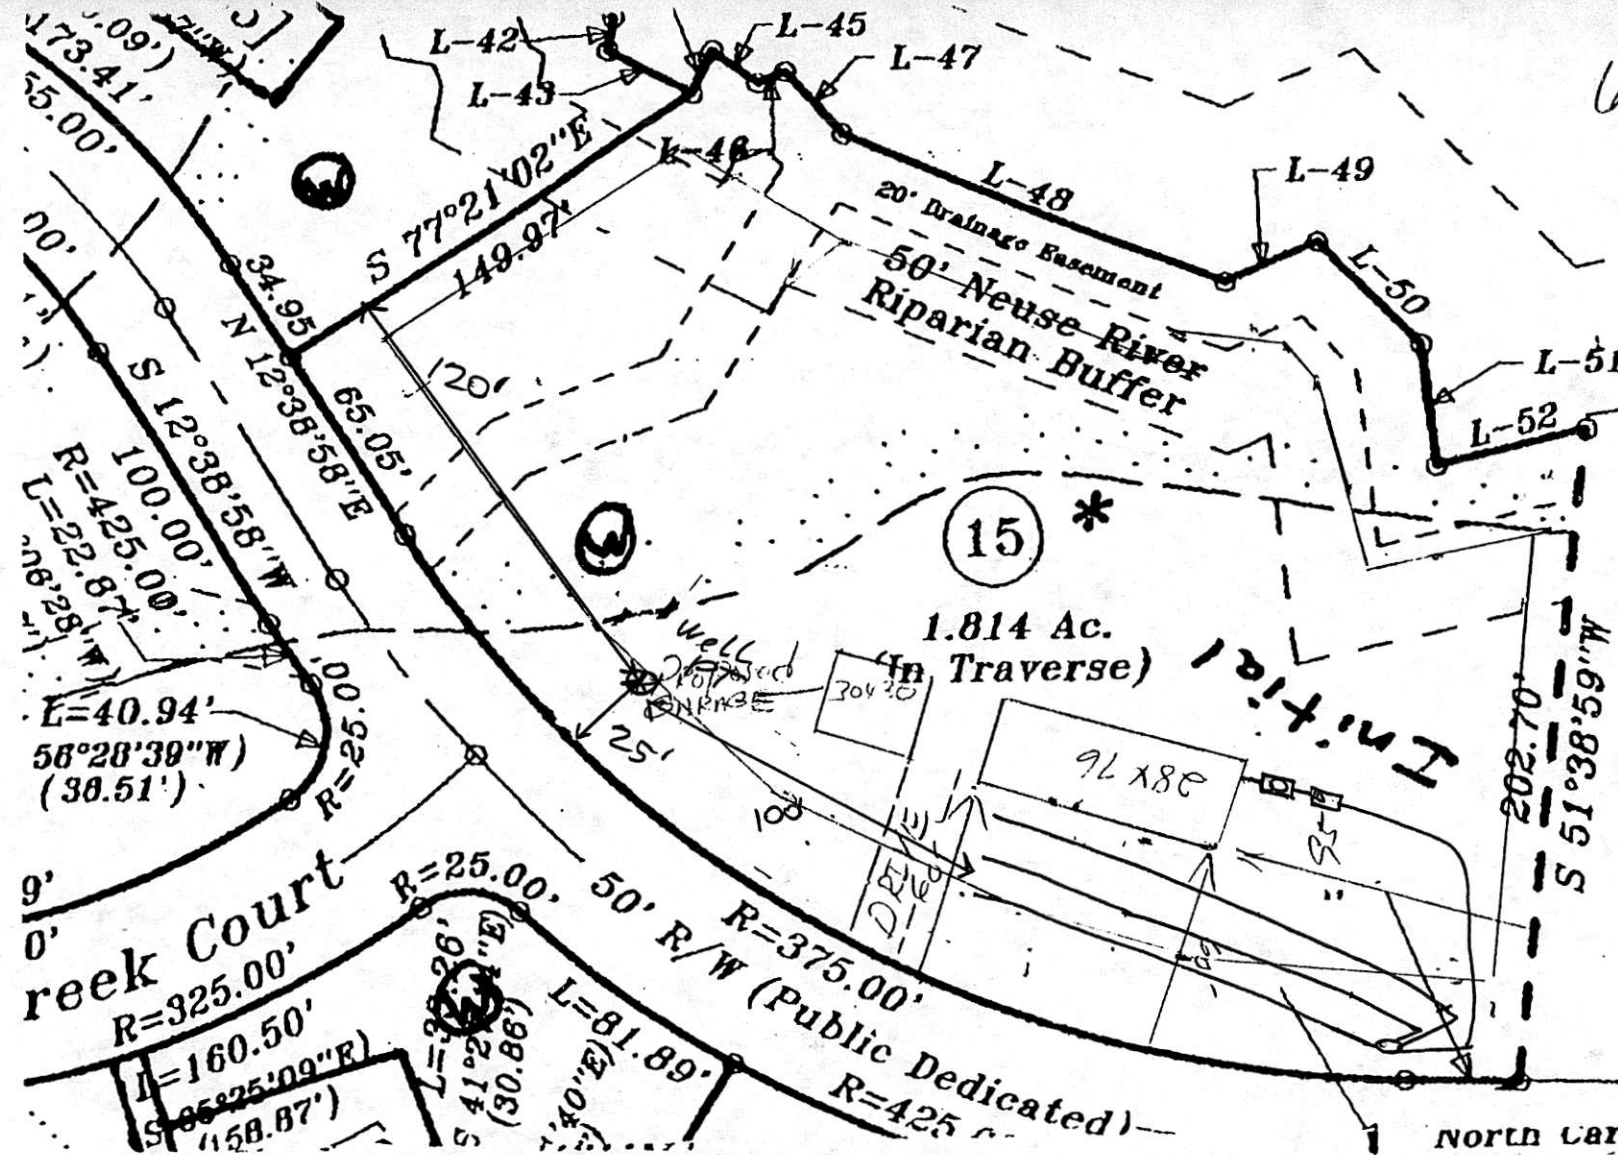

(14)

B. M. 1997, P.

reek Court
R=325.00'
L=160.50'
S 41°25'09"E
(58.87')

1.814 Ac.
(Traverse)
R=25.00'
L=81.89'
R=375.00'
R=425.00'
(Public Dedicated)

North Carolina

D21131
0013098

TOTAL


03446643

I certify that the location of planned or existing structure(s) are accurately shown. I understand failure to locate structures in accordance with this plot plan may require the relocation of structure(s) regardless degree of completion. I hereby grant permission to Municipal/County Representatives the right of entry to make evaluations or inspections upon this property.

[Signature]
Signature of Owner or Authorized Agent

Zoning B30 By CAL
 Approve _____ Date 3.16.01
 Revise _____ Use 112
 Reject _____ MBL _____
 Front 30 Rear 30
 Side 10 Corner _____
 Comments: Sent for Flood Cert.

60 = 1"

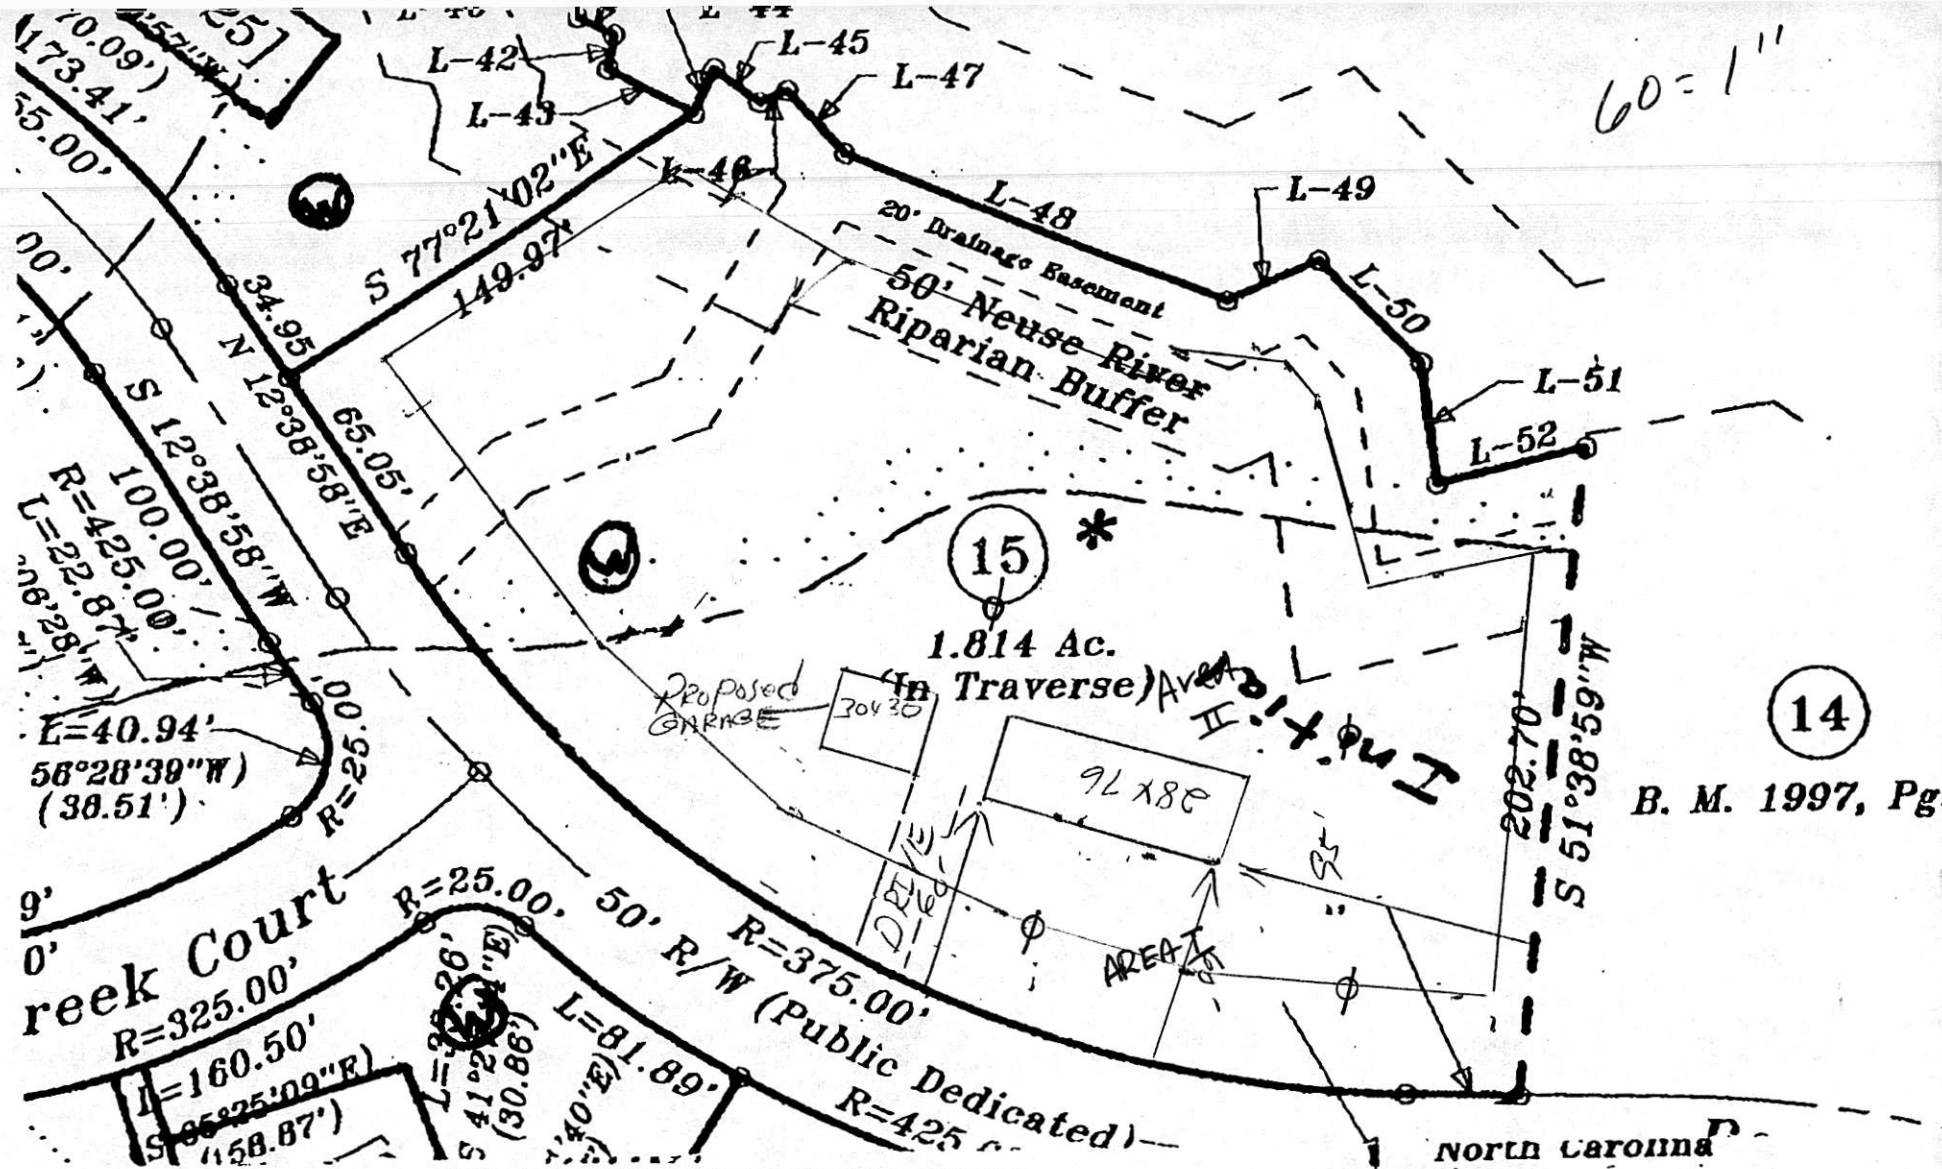

14

B. M. 1997, Pg.

reek Court
R=325.00'
I=160.50'
S 85°25'09"E
(158.87')

R=25.00'
S 41°26'34"E
(30.86')
L=81.89'
R=375.00'
50' R/W (Public Dedicated)
R=425.00'

North Carolina

D21131
0013098

TOTAL P.06

Pin# 068603446643

I certify that the location of planned or existing structure(s) are accurately shown. I understand failure to locate structures in accordance with this plot plan may require the relocation of structure(s) regardless degree of completion. I hereby grant permission to Municipal/County Representatives the right of entry to make evaluations or inspections upon this property.

[Signature]
Signature of Owner or Authorized Agent

Zoning B30 By CMC
 Approve _____ Date 3-16-01
 Revise _____ Use 112
 Reject _____ MBL _____
 Front 30 Rear 30
 Side 10 Corner _____
 Comments: Sent for Flood Cert.