

WAKE COUNTY HEALTH DEPARTMENT SEPTIC TANK LAYOUT AND PERMIT

TAX MAP NO. 802 PARCEL NO. 170

PERMIT NO. B
OPERATION PERMIT ☐

33410

M-CK

CONTRACTOR _____

OWNER Charles Holliday

DATE

7-29-85

LOCATION _____

S. R. NO.

1393

SUBDIVISION NAME

Bentwinds

LOT NO.

52

SECTION OR BLOCK NO.

3C

REPAIR ☐ ORIGINAL PERMIT NO. _____

GARBAGE DISPOSAL UNIT YES ☐ NO ☒

HOUSE ☒ MOBILE HOME ☐ BUSINESS ☐

NO. BEDROOMS 4 LOT AREA 30,000 sq. ft.

SIZE OF TANK 1200 gal.

NITRIFICATION LINE 1200 2 (200 x 3') sq. ft.

DEPTH OF STONE IN LINES: 12" ☐

RISER AND BAFFLE REQUIRED ☐ PUMP REQUIRED ☐

WATER SUPPLY: INDIVIDUAL ☒ PUBLIC ☐ OTHER ☐


* PERMIT VOID 36 MONTHS FROM DATE OF ISSUANCE.

* PERMIT VOID IF NOT IN COMPLIANCE WITH ZONING REGULATIONS

* PERMIT MAY BE VOIDED IF SITE ALTERATIONS MADE

LAYOUT BY

M. Van Dyke, P.E.

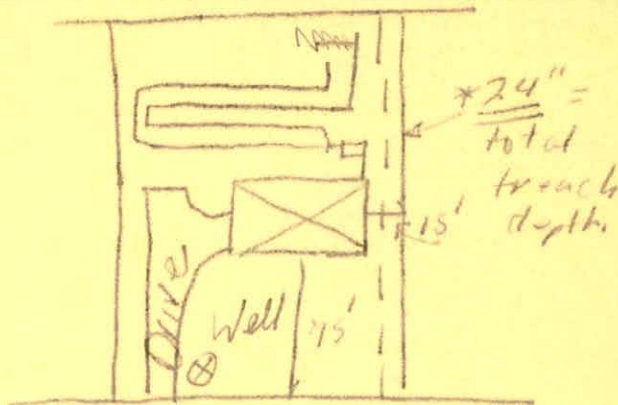

11-26-85


DATE

Homer Fish

INSTALLED BY

APPROVED BY

Al Ward

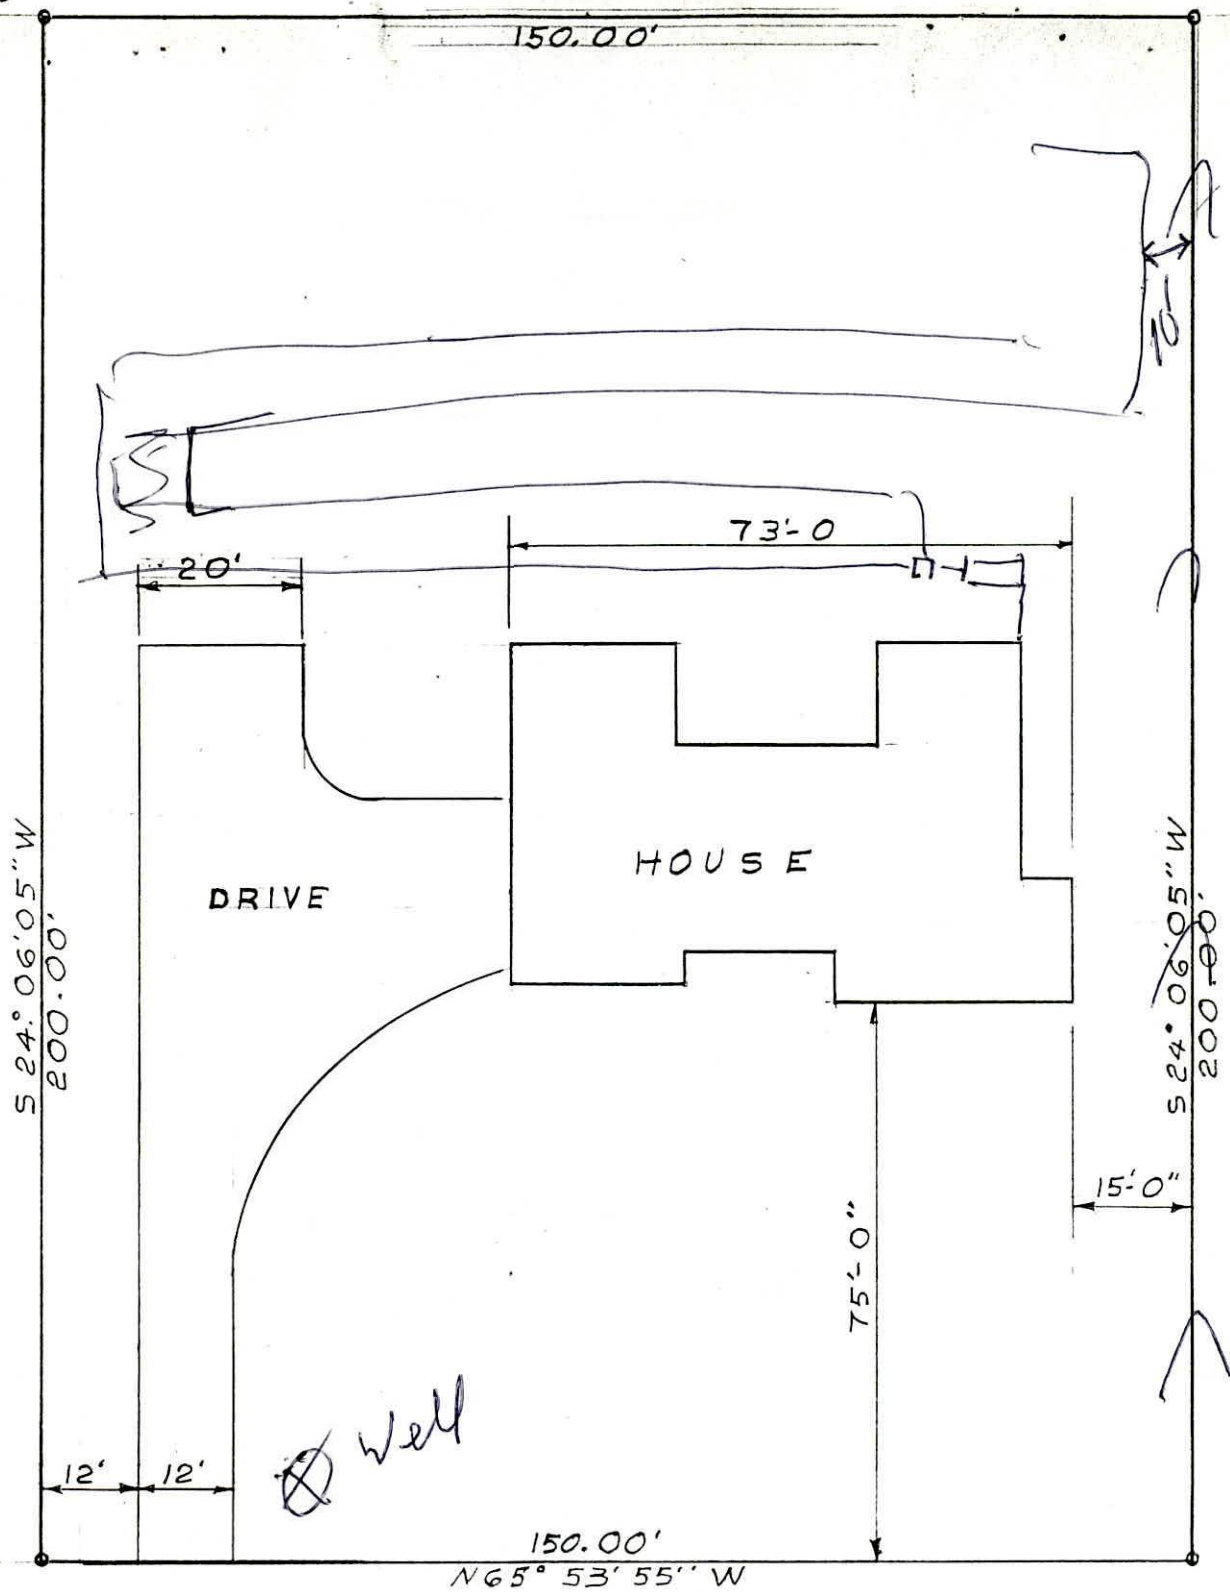

BENTWINDS LANE